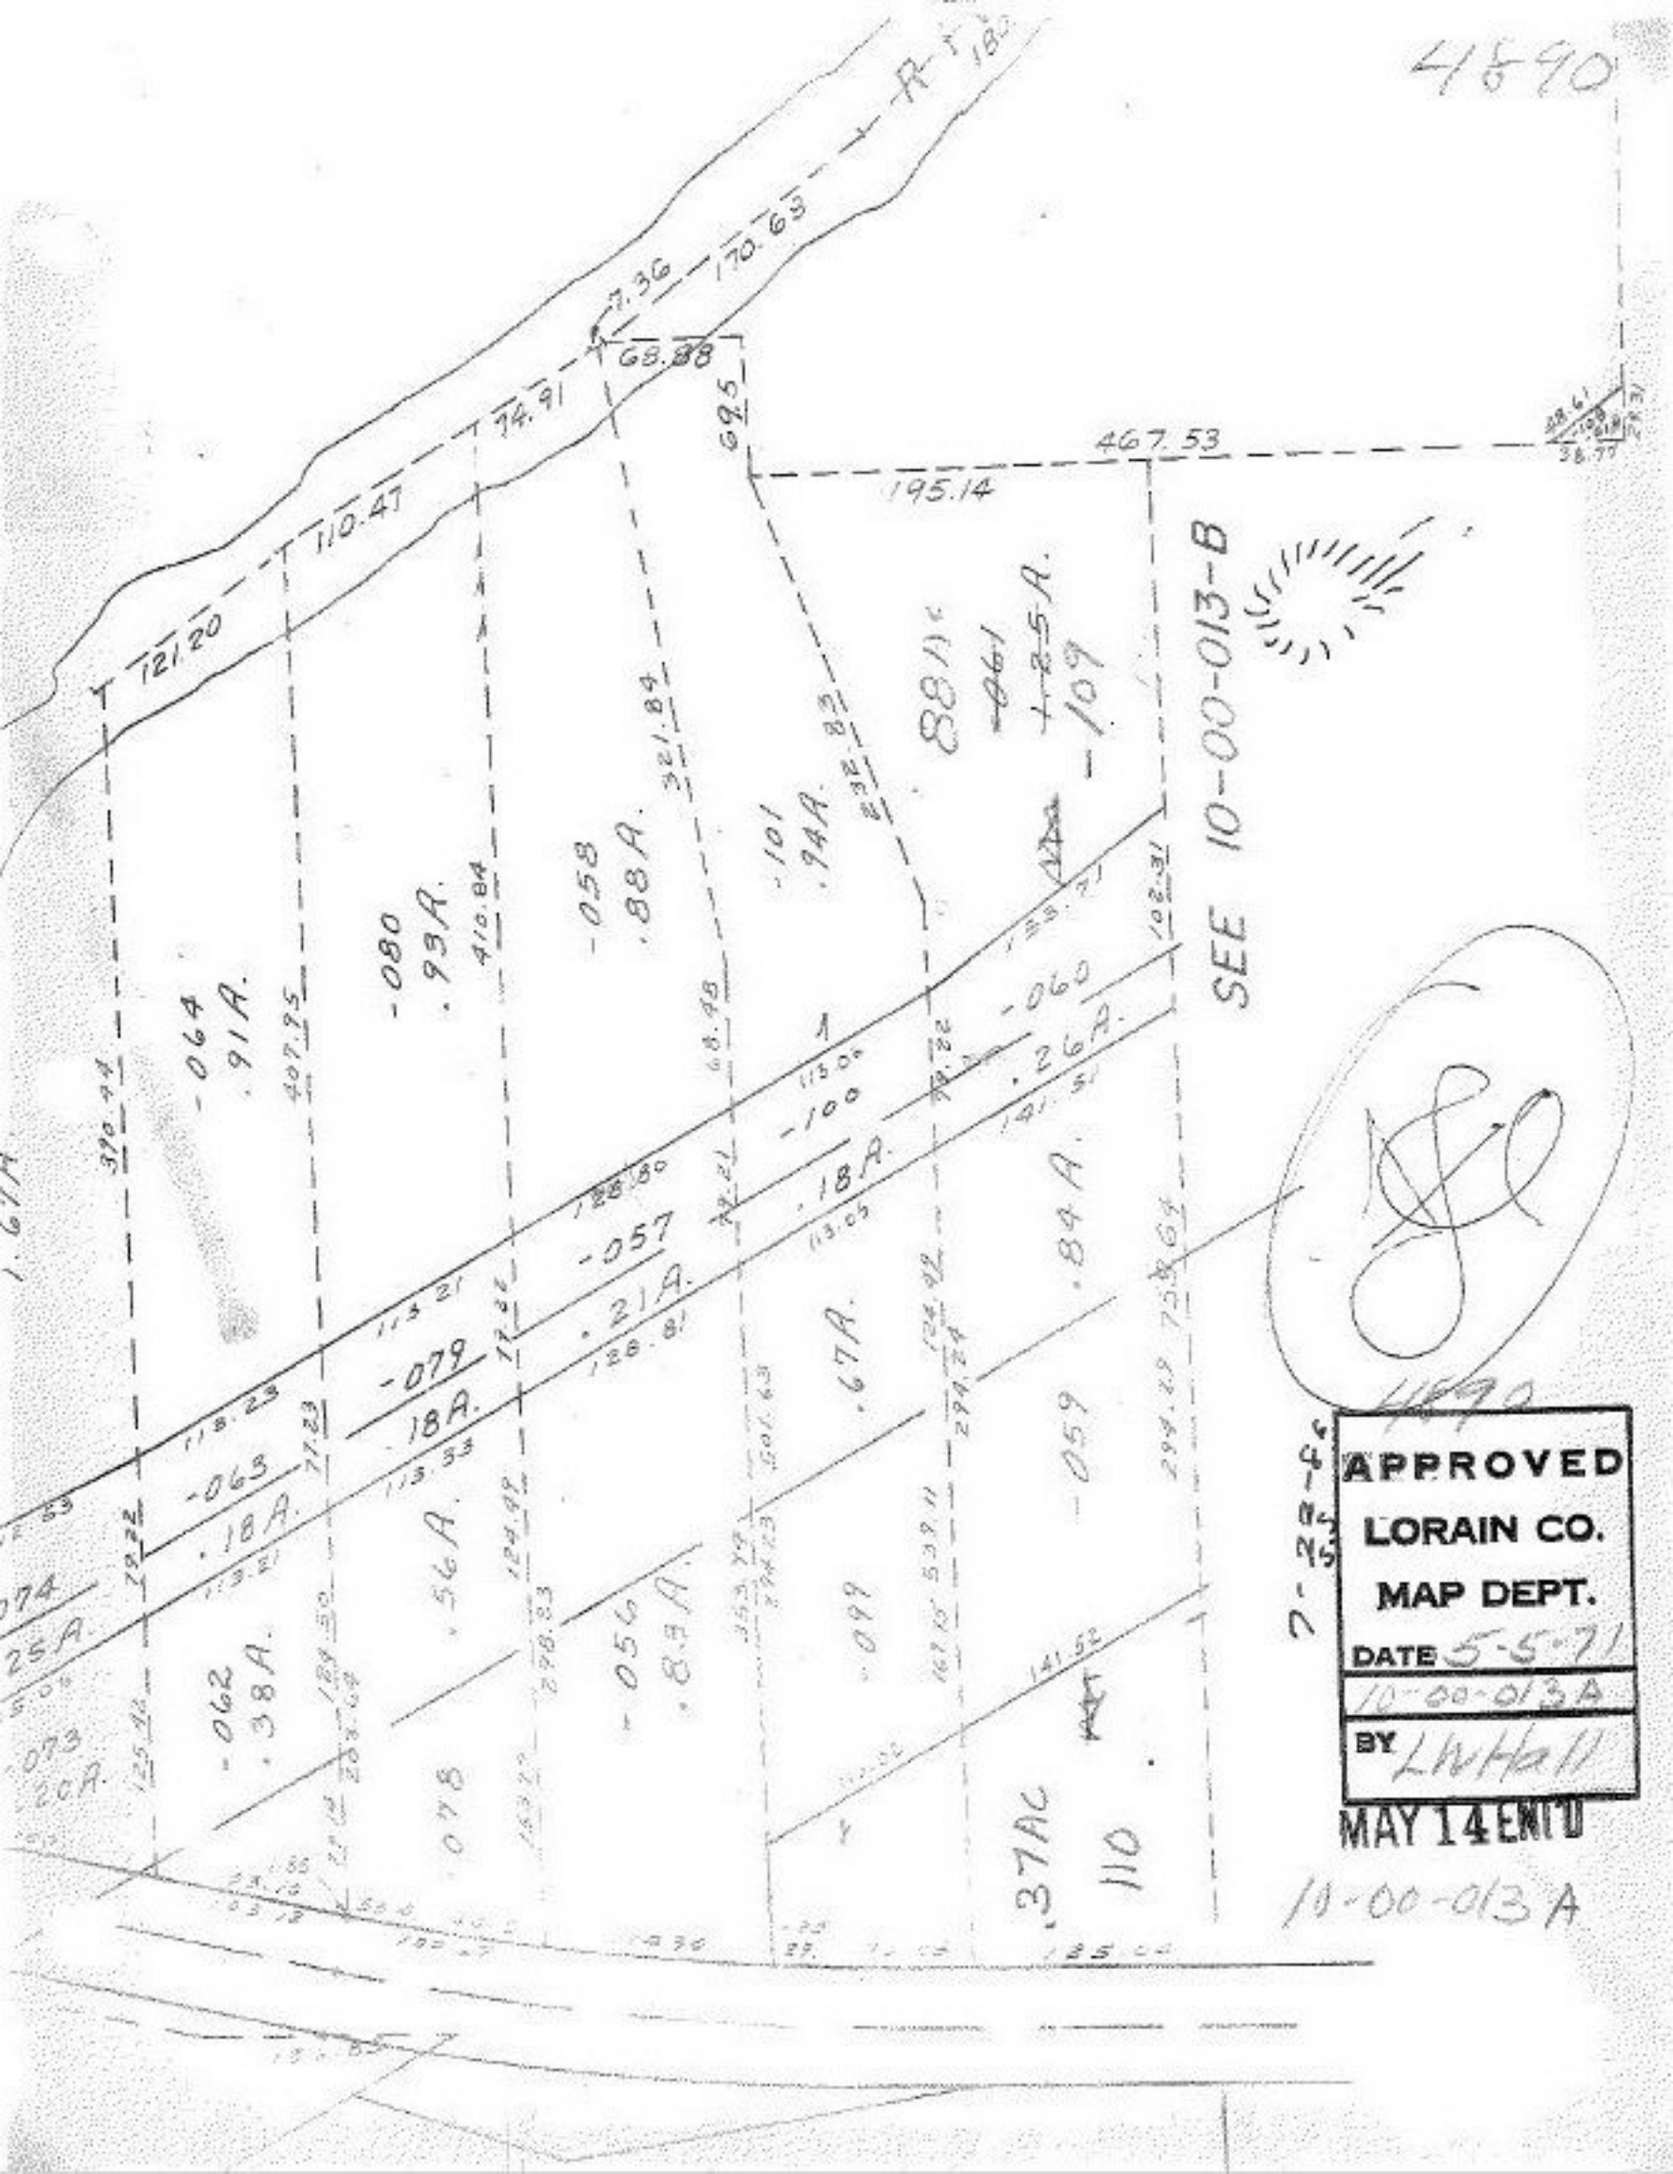
4690
SEE 10-00-013-B
APPROVED
LORAIN CO.
MAP DEPT.
DATE 5-5-71
10-00-013A
BY LWHall
MAY 14 ENTD
10-00-013A