


33510
53818
87328

BAUMHART RD. (60)

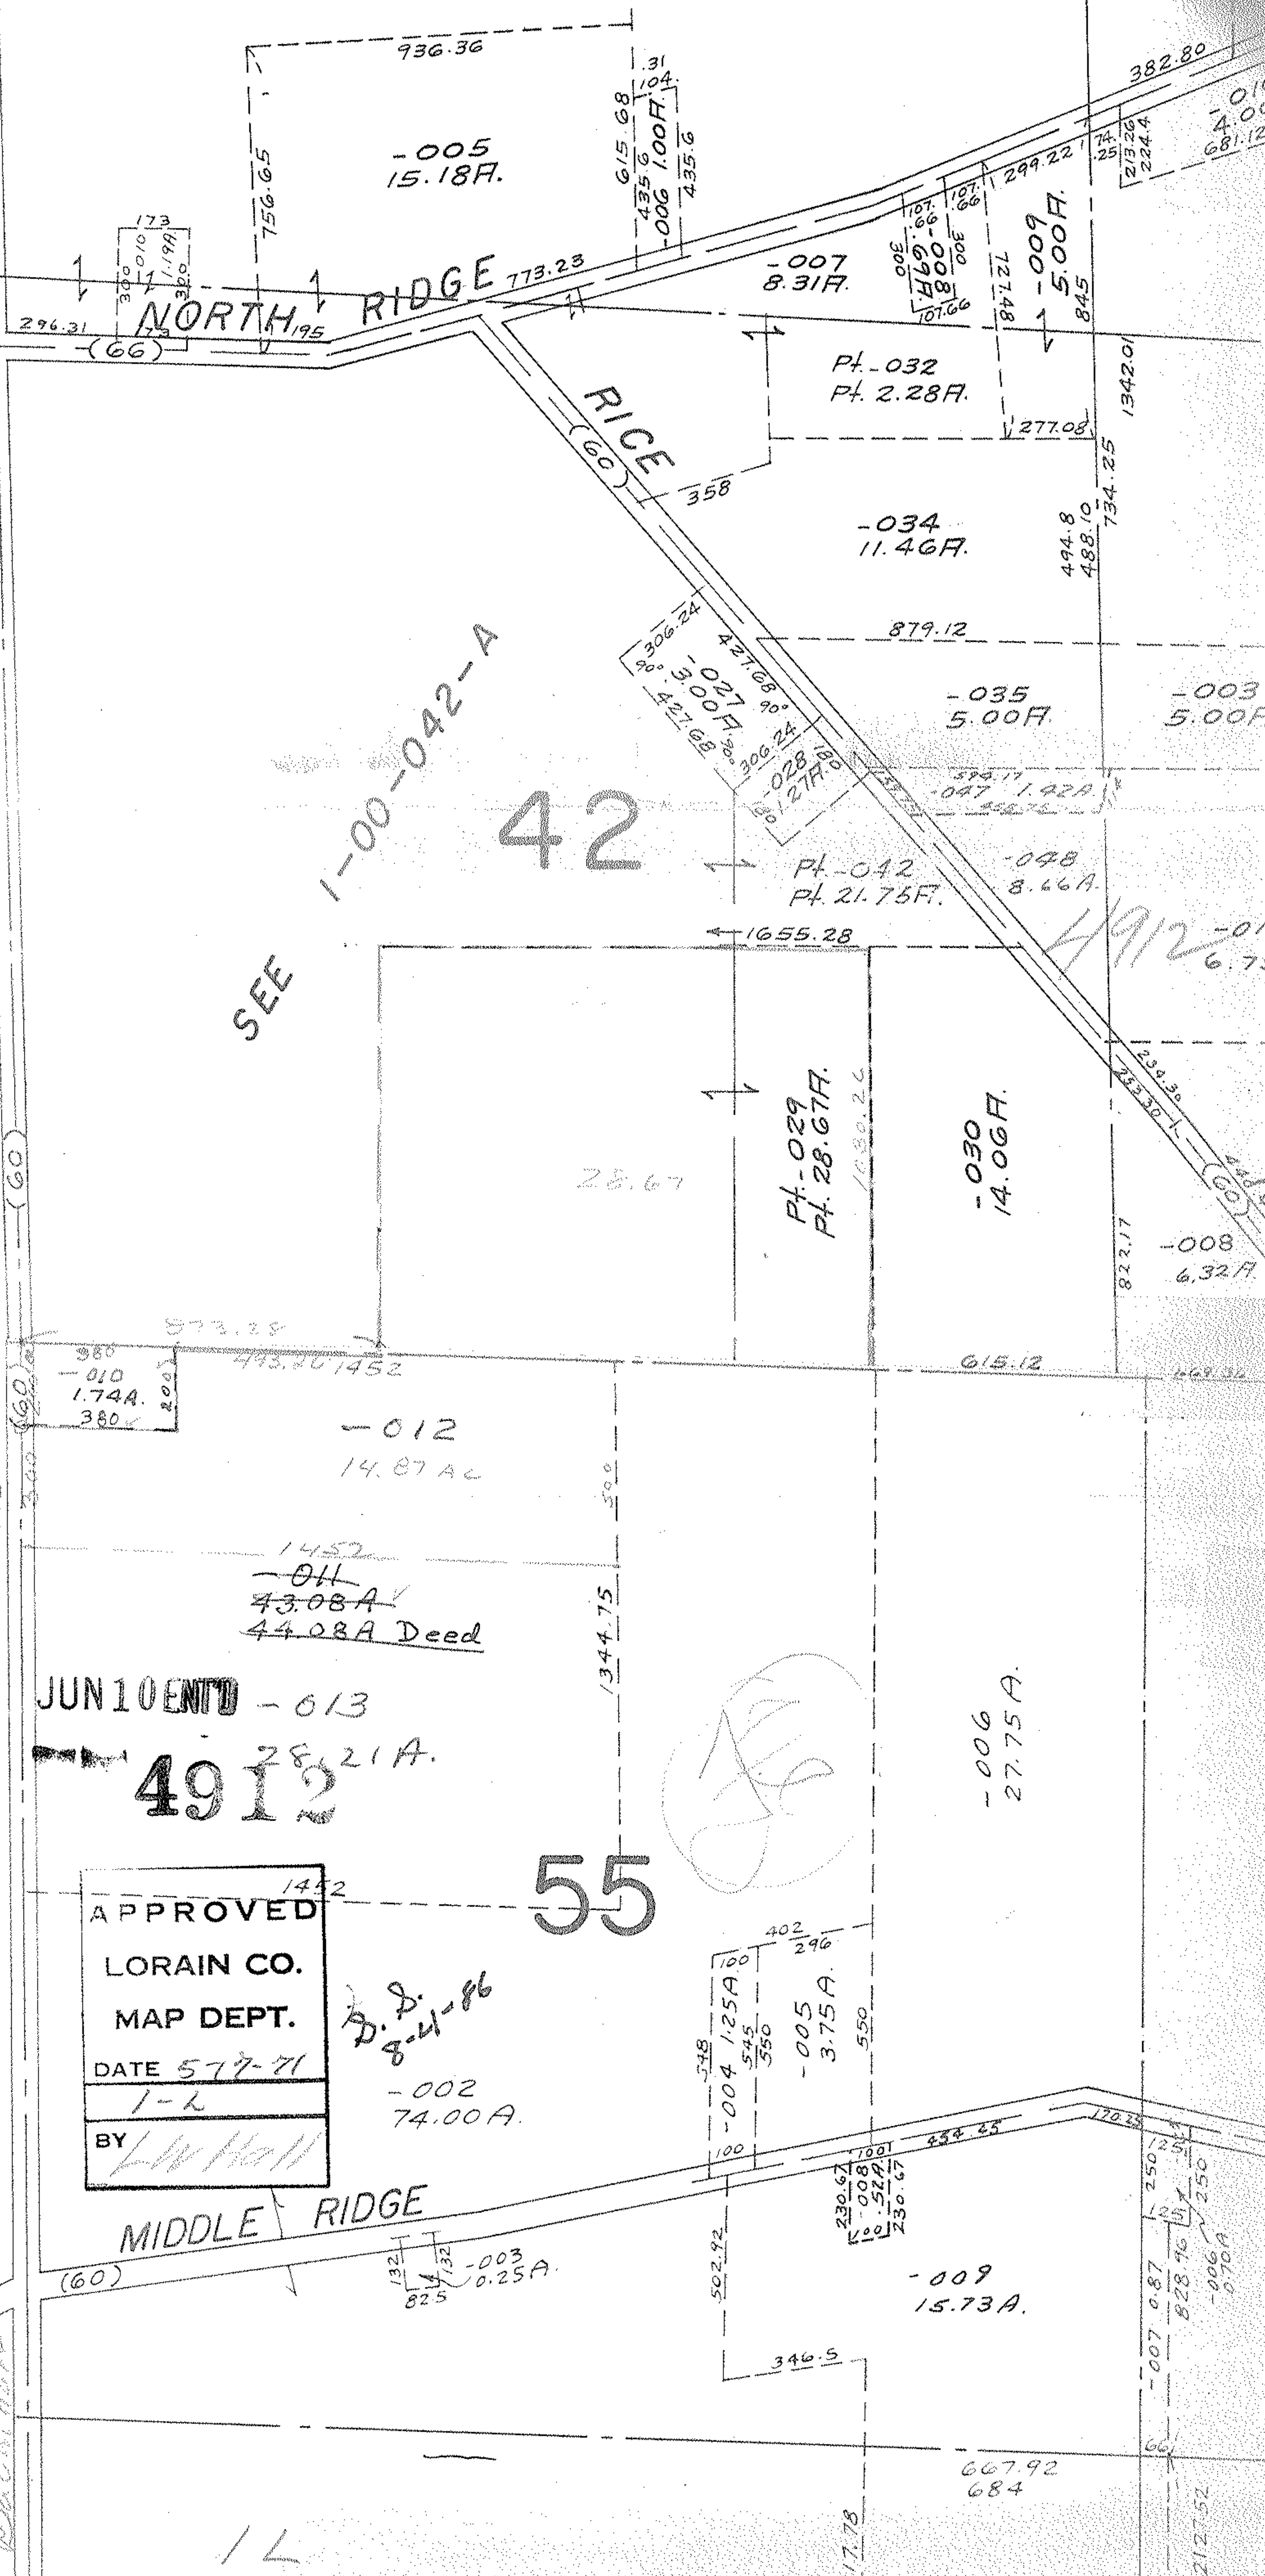

NORTH RIDGE

RICE

APPROVED
 LORAIN CO.
 MAP DEPT.
 DATE 5-7-71
 1-K
 BY *L.W. Hall*

SEE 1-00-042-A


JUN 10 1970 -013
 28.21 A.
4912

42

55

MIDDLE RIDGE

D.S. 8-4-86

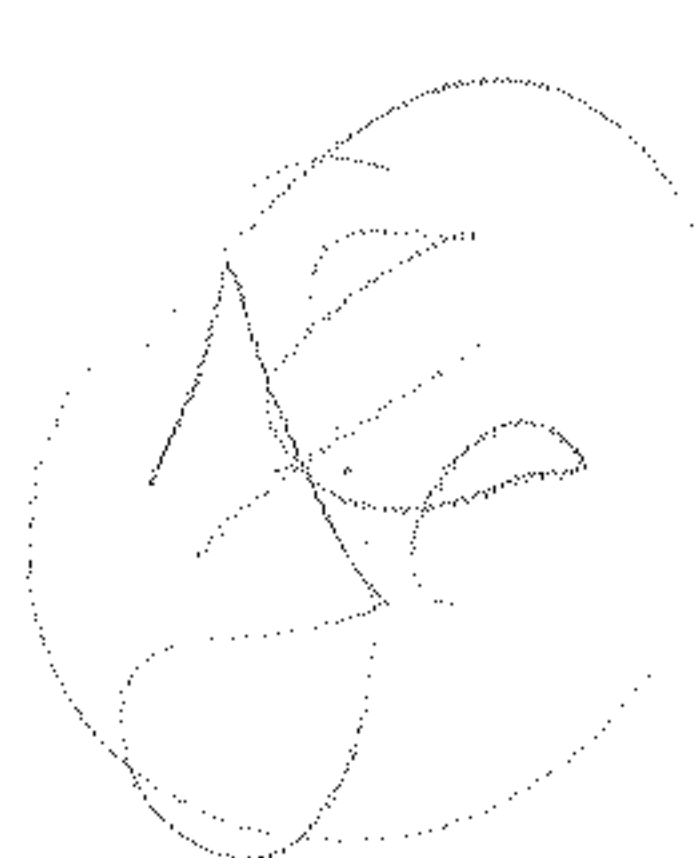

H 9/12

(60)

(60)

(66)

(60)

(66)

(60)

(60)