4916

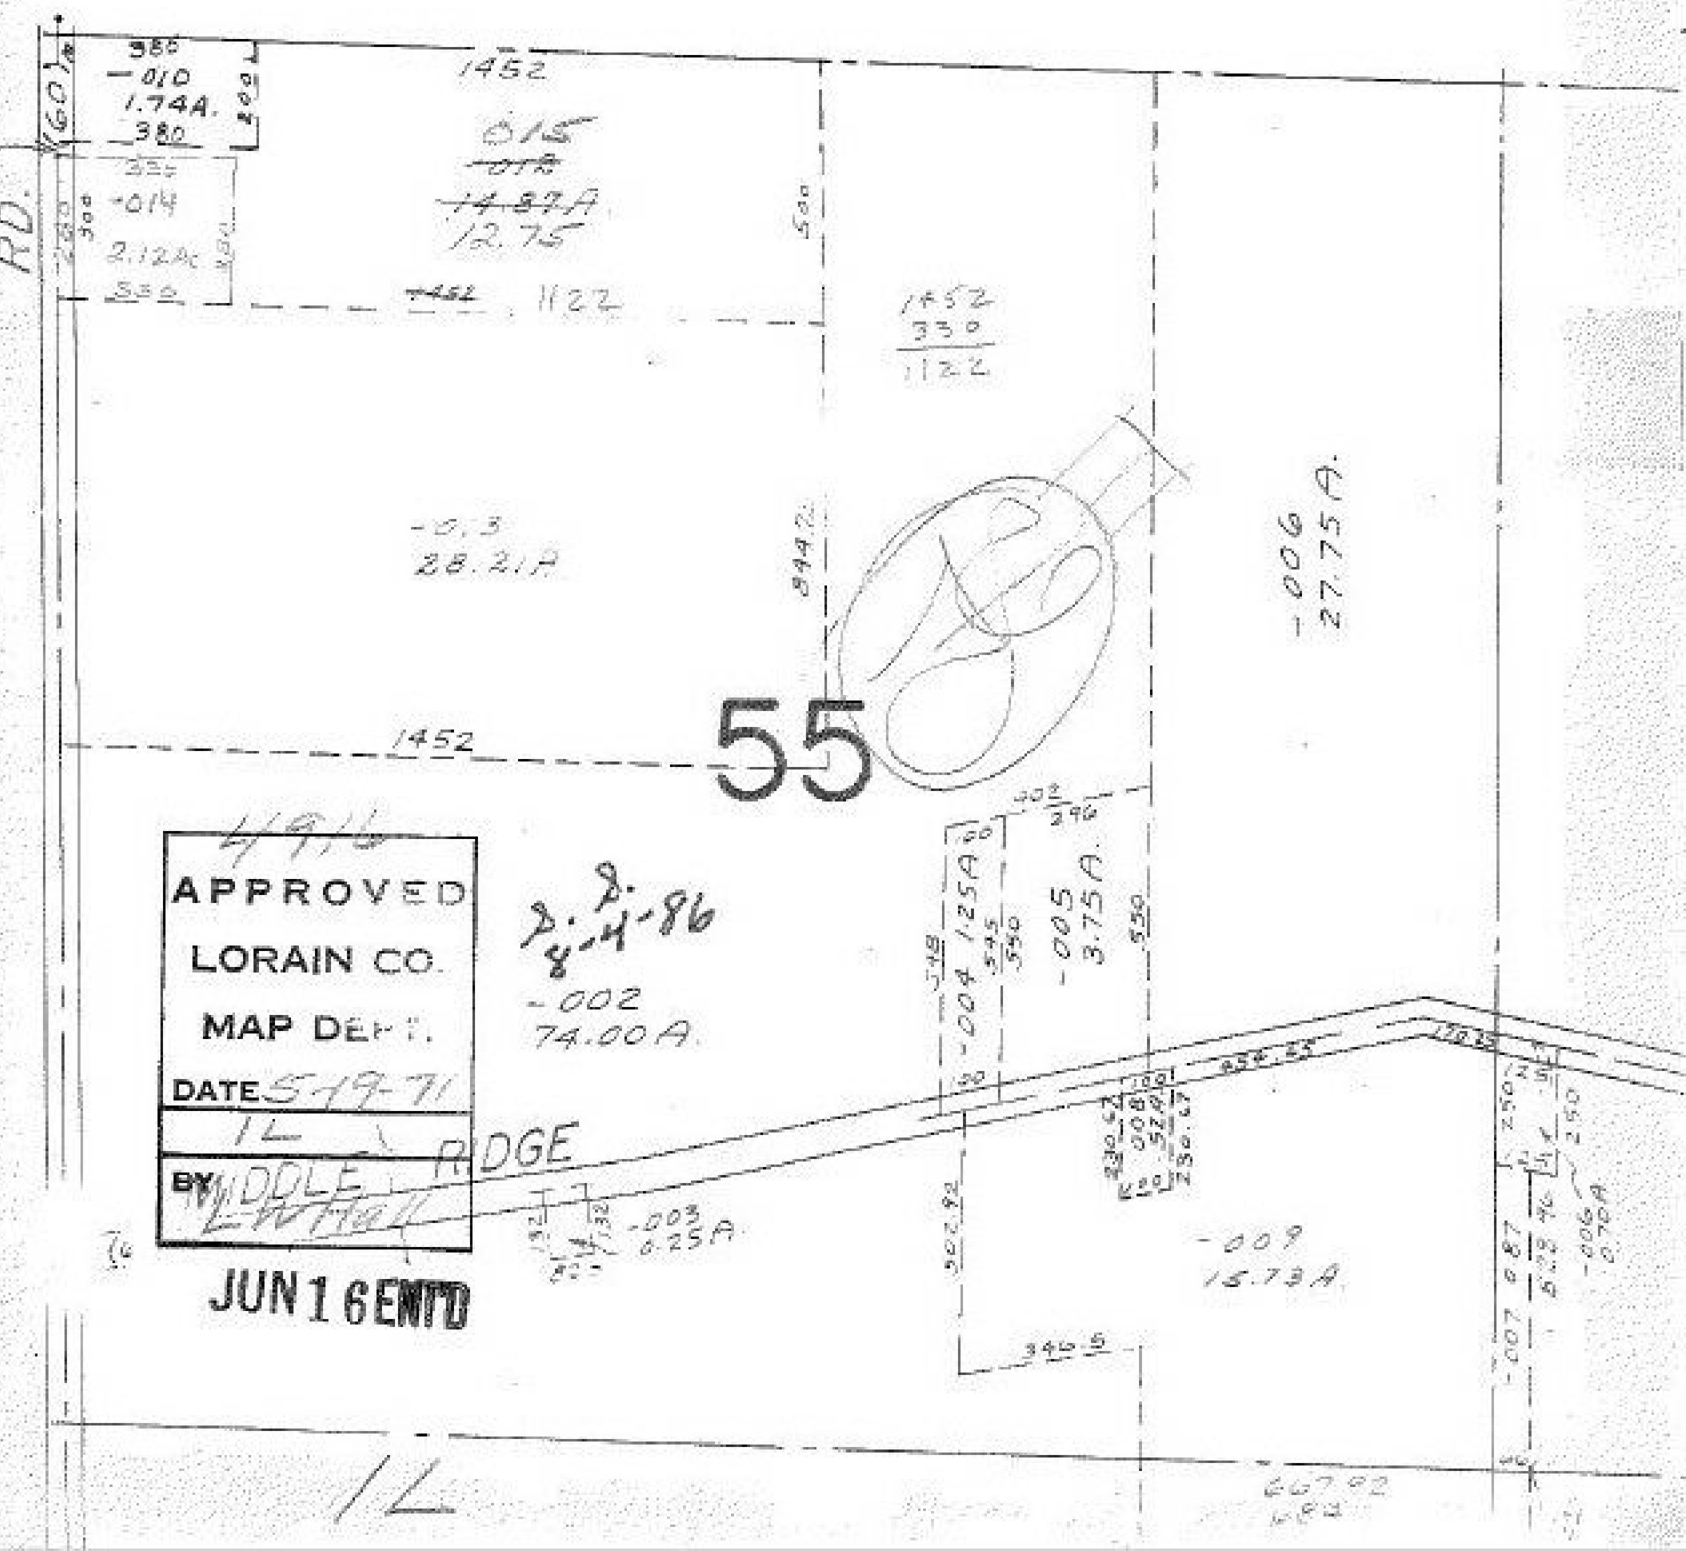

RD.
1452
-015
12.75
1122
1452
330
1122
28.21A
-006
27.75A
55
1452
-005
3.75A
-002
74.00A
-003
0.25A
-009
15.73A
RIDGE
4916
APPROVED
LORAIN CO.
MAP DEPT.
DATE 5-19-71
JUN 16 ENT'D