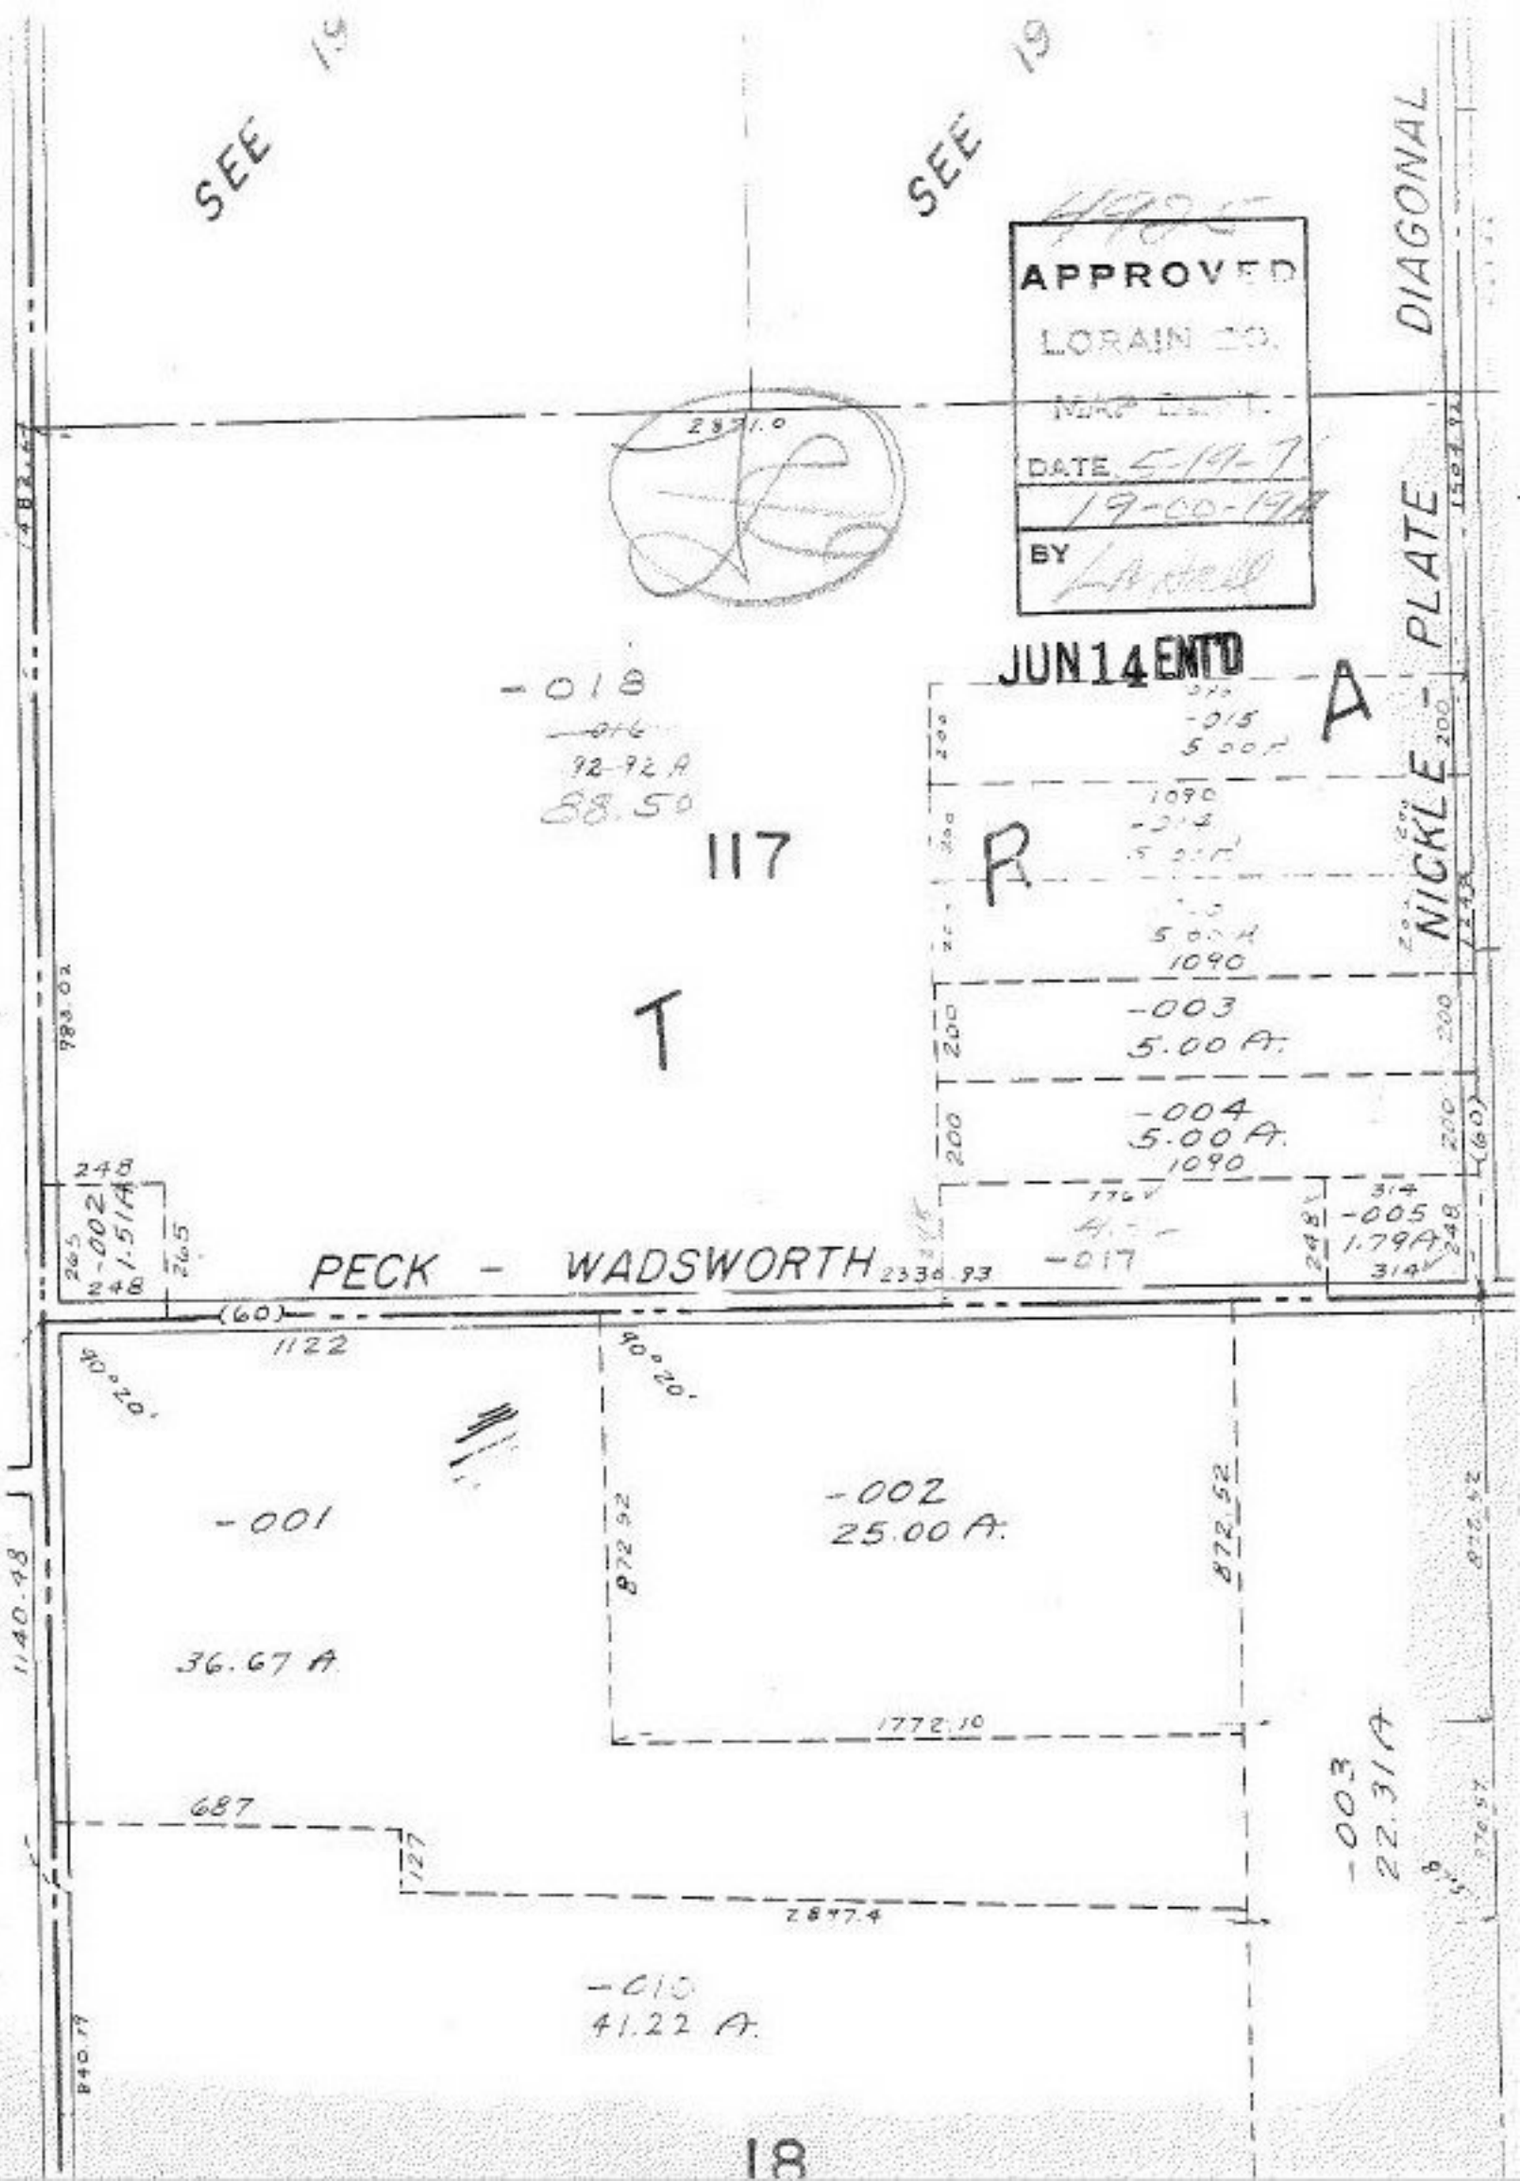
SEE 19
SEE 19
APPROVED
LORAIN CO.
MAP DEPT.
DATE 5-19-7
19-00-19
BY
JUN 14 ENTD
DIAGONAL
NICKLE PLATE
-018
-016
92-92A
58.50
117
T
R
A
-015
5.00 A.
1090
-013
5.00 A.
1090
-003
5.00 A.
1090
-004
5.00 A.
1090
-017
-005
1.79A
-002
1.51A
PECK - WADSWORTH
2336.93
(60)
1122
-001
36.67 A.
-002
25.00 A.
872.52
1772.10
687
127
2847.4
-010
41.22 A.
-003
22.31A
1140.48
840.19
983.02
18