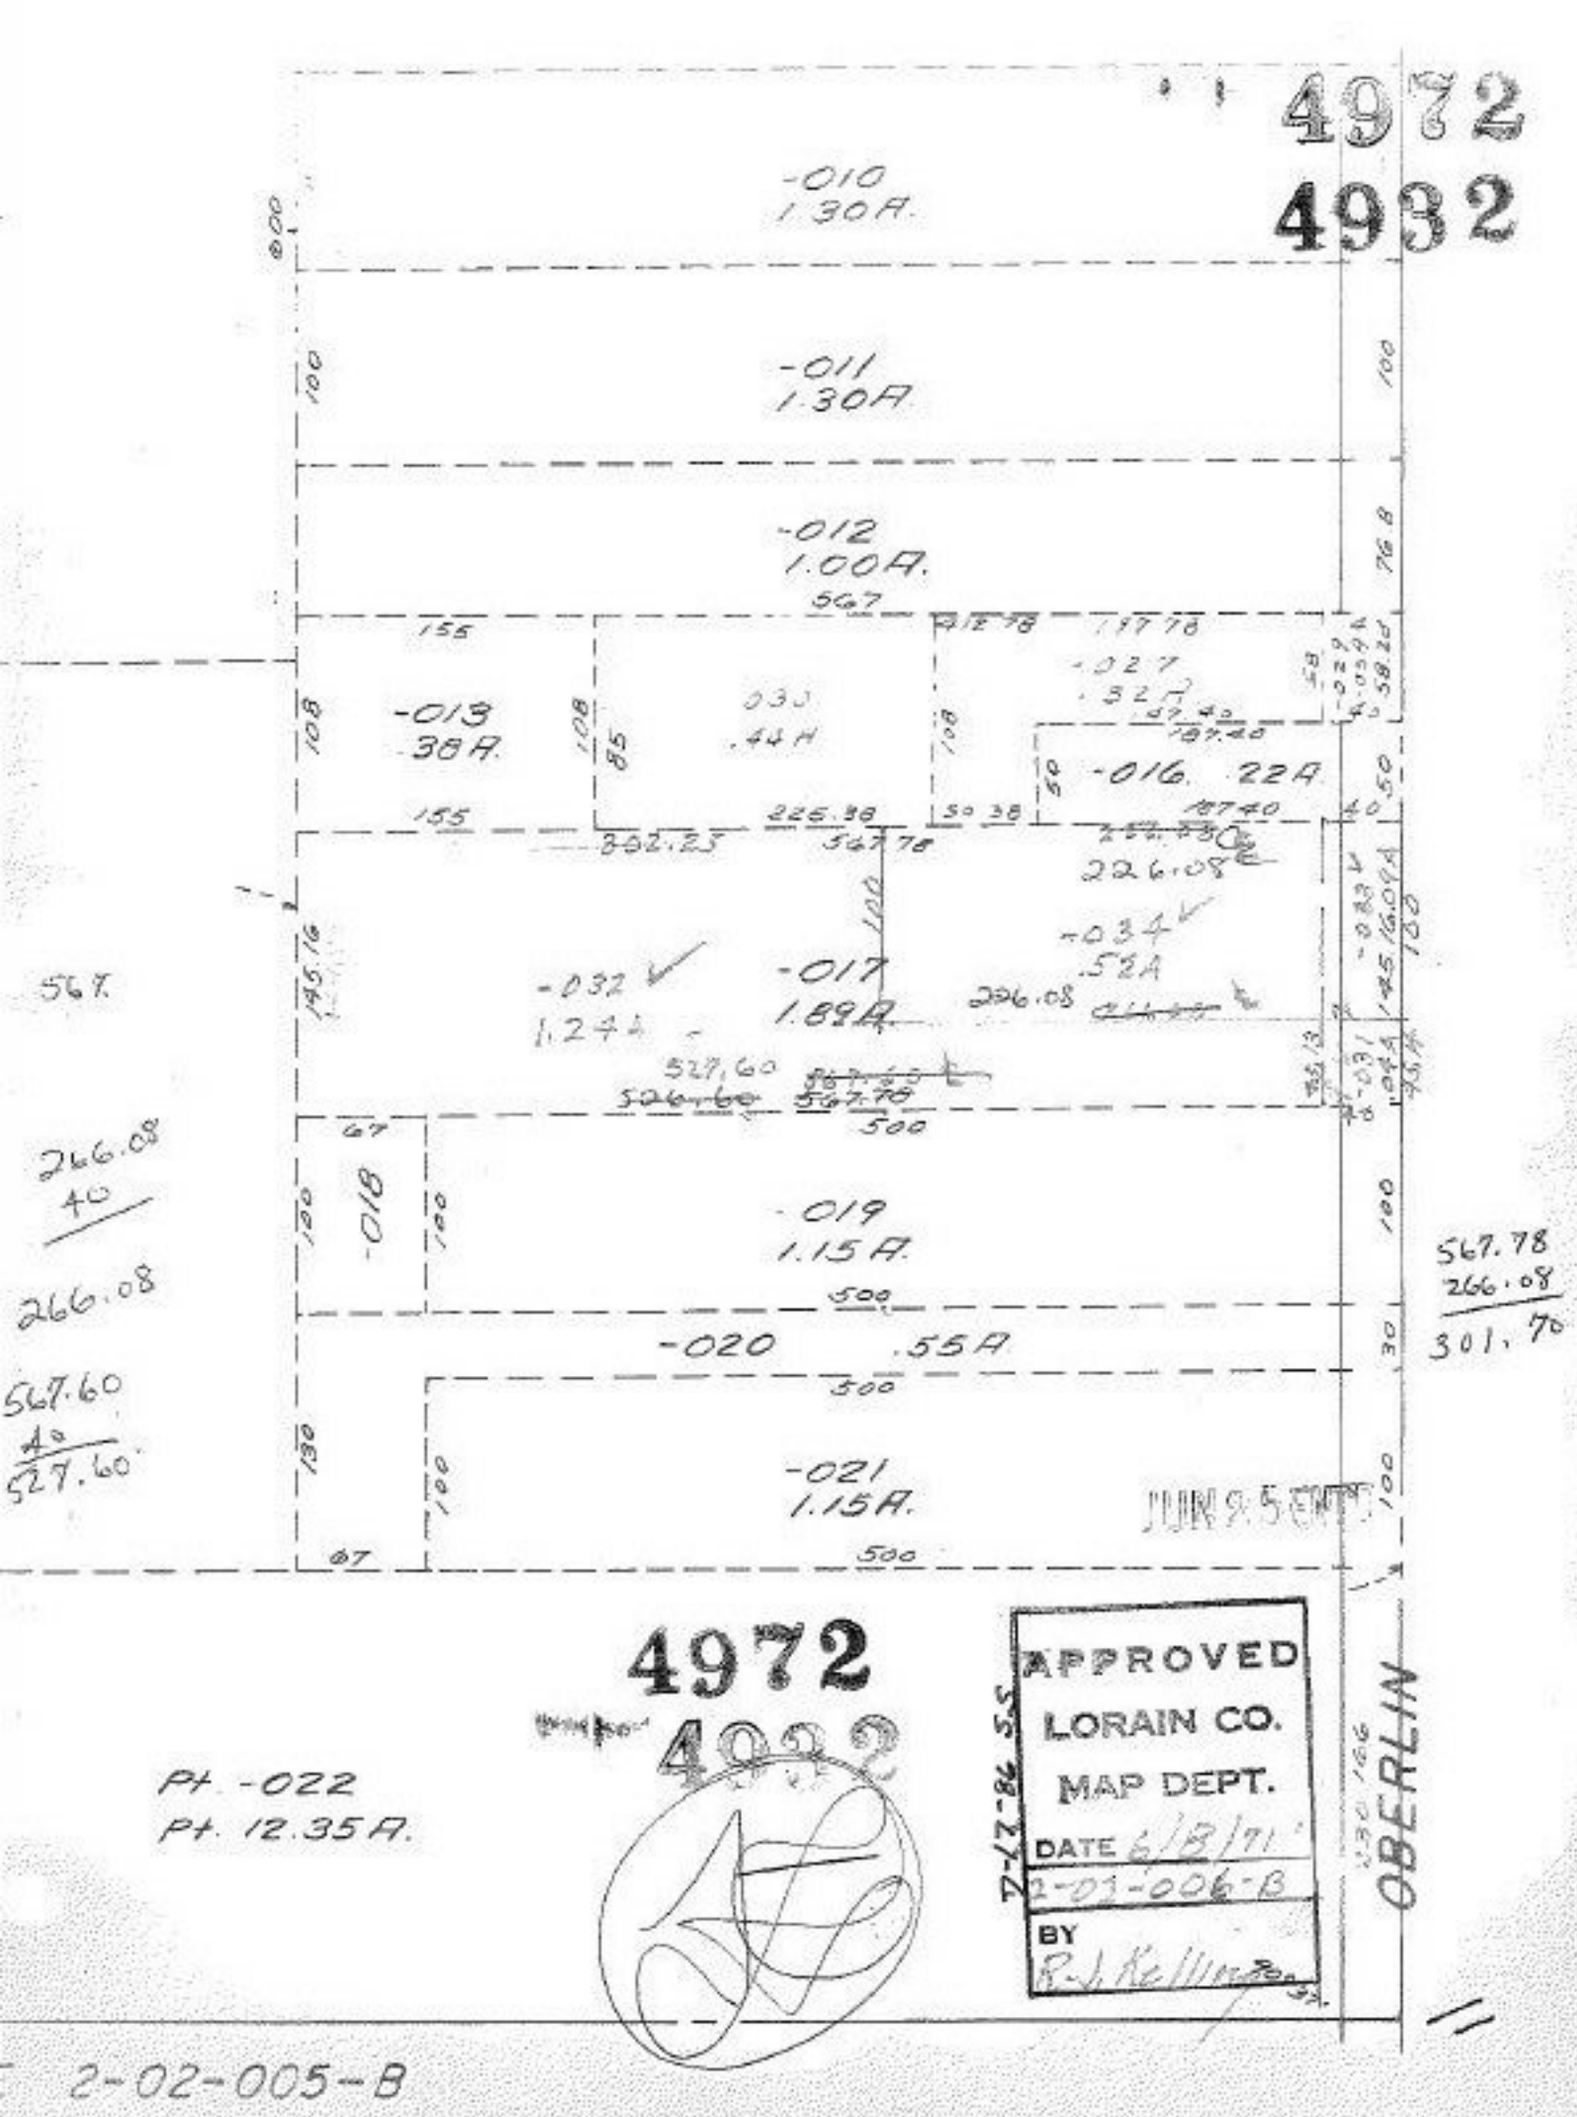
4972
4932
-010
1.30A.
-011
1.30A.
-012
1.00A.
-013
.38A.
-016 .22A
-027
.32A
-034
.52A
-017
1.89A.
-032
1.24A
-018
-019
1.15A.
-020 .55A
-021
1.15A.
JUN 9 5 ENTD
APPROVED
LORAIN CO.
MAP DEPT.
DATE 6/8/71
2-01-006-B
BY R.J. Kellner
7-27-86 SS
OBERLIN
4972
4932
Pt. -022
Pt. 12.35A.
2-02-005-B