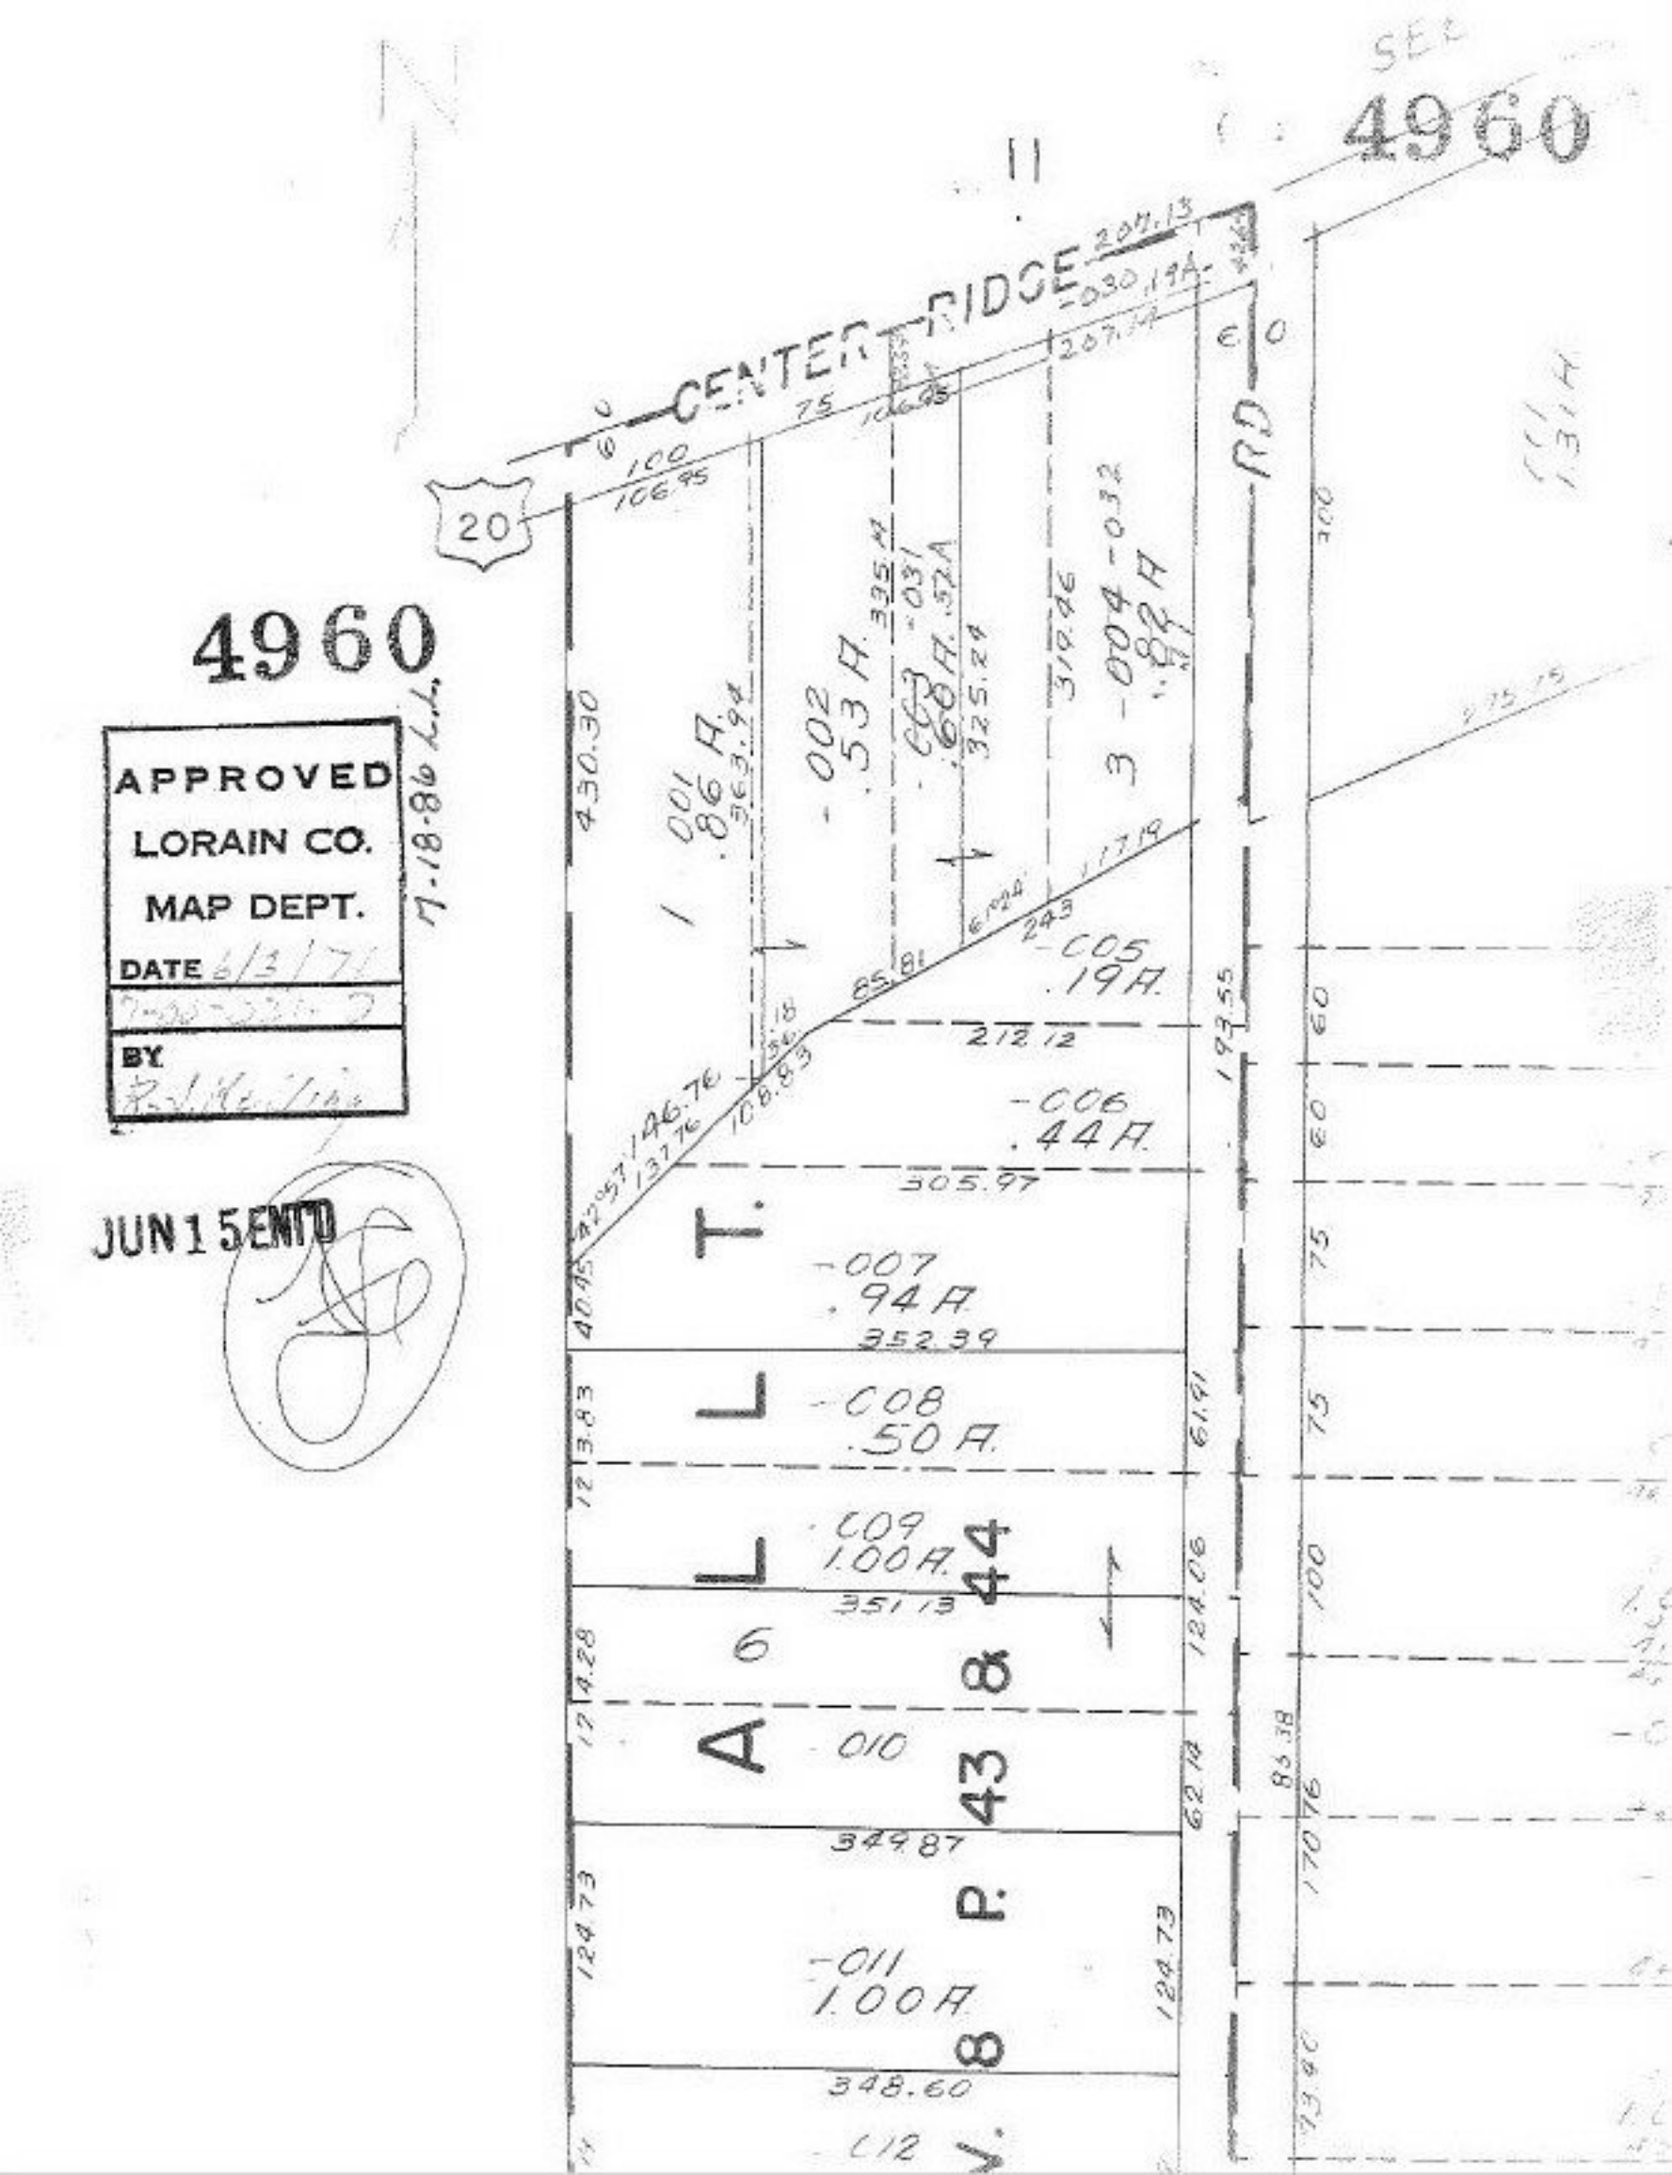
4960
APPROVED
LORAIN CO.
MAP DEPT.
DATE 6/3/71
BY
7-18-86 L.L.
JUN 15 ENTD
CENTER RIDGE RD
20
T. 6 P. 43 & 44
001 .86 A.
002 .53 A.
003 .68 A.
004 .82 A.
005 .19 A.
006 .44 A.
007 .94 A.
008 .50 A.
009 1.00 A.
010
011 1.00 A.
012
430.30
363.94
335.44
325.24
310.46
207.13
2030.19 A±
212.12
193.55
305.97
352.39
351.13
349.87
348.60
124.73
124.06
62.14
61.91
85.38
170.76
100
75
60
243
65.81
106.83
146.76
137.76
40.45
12 3.83
12 4.28