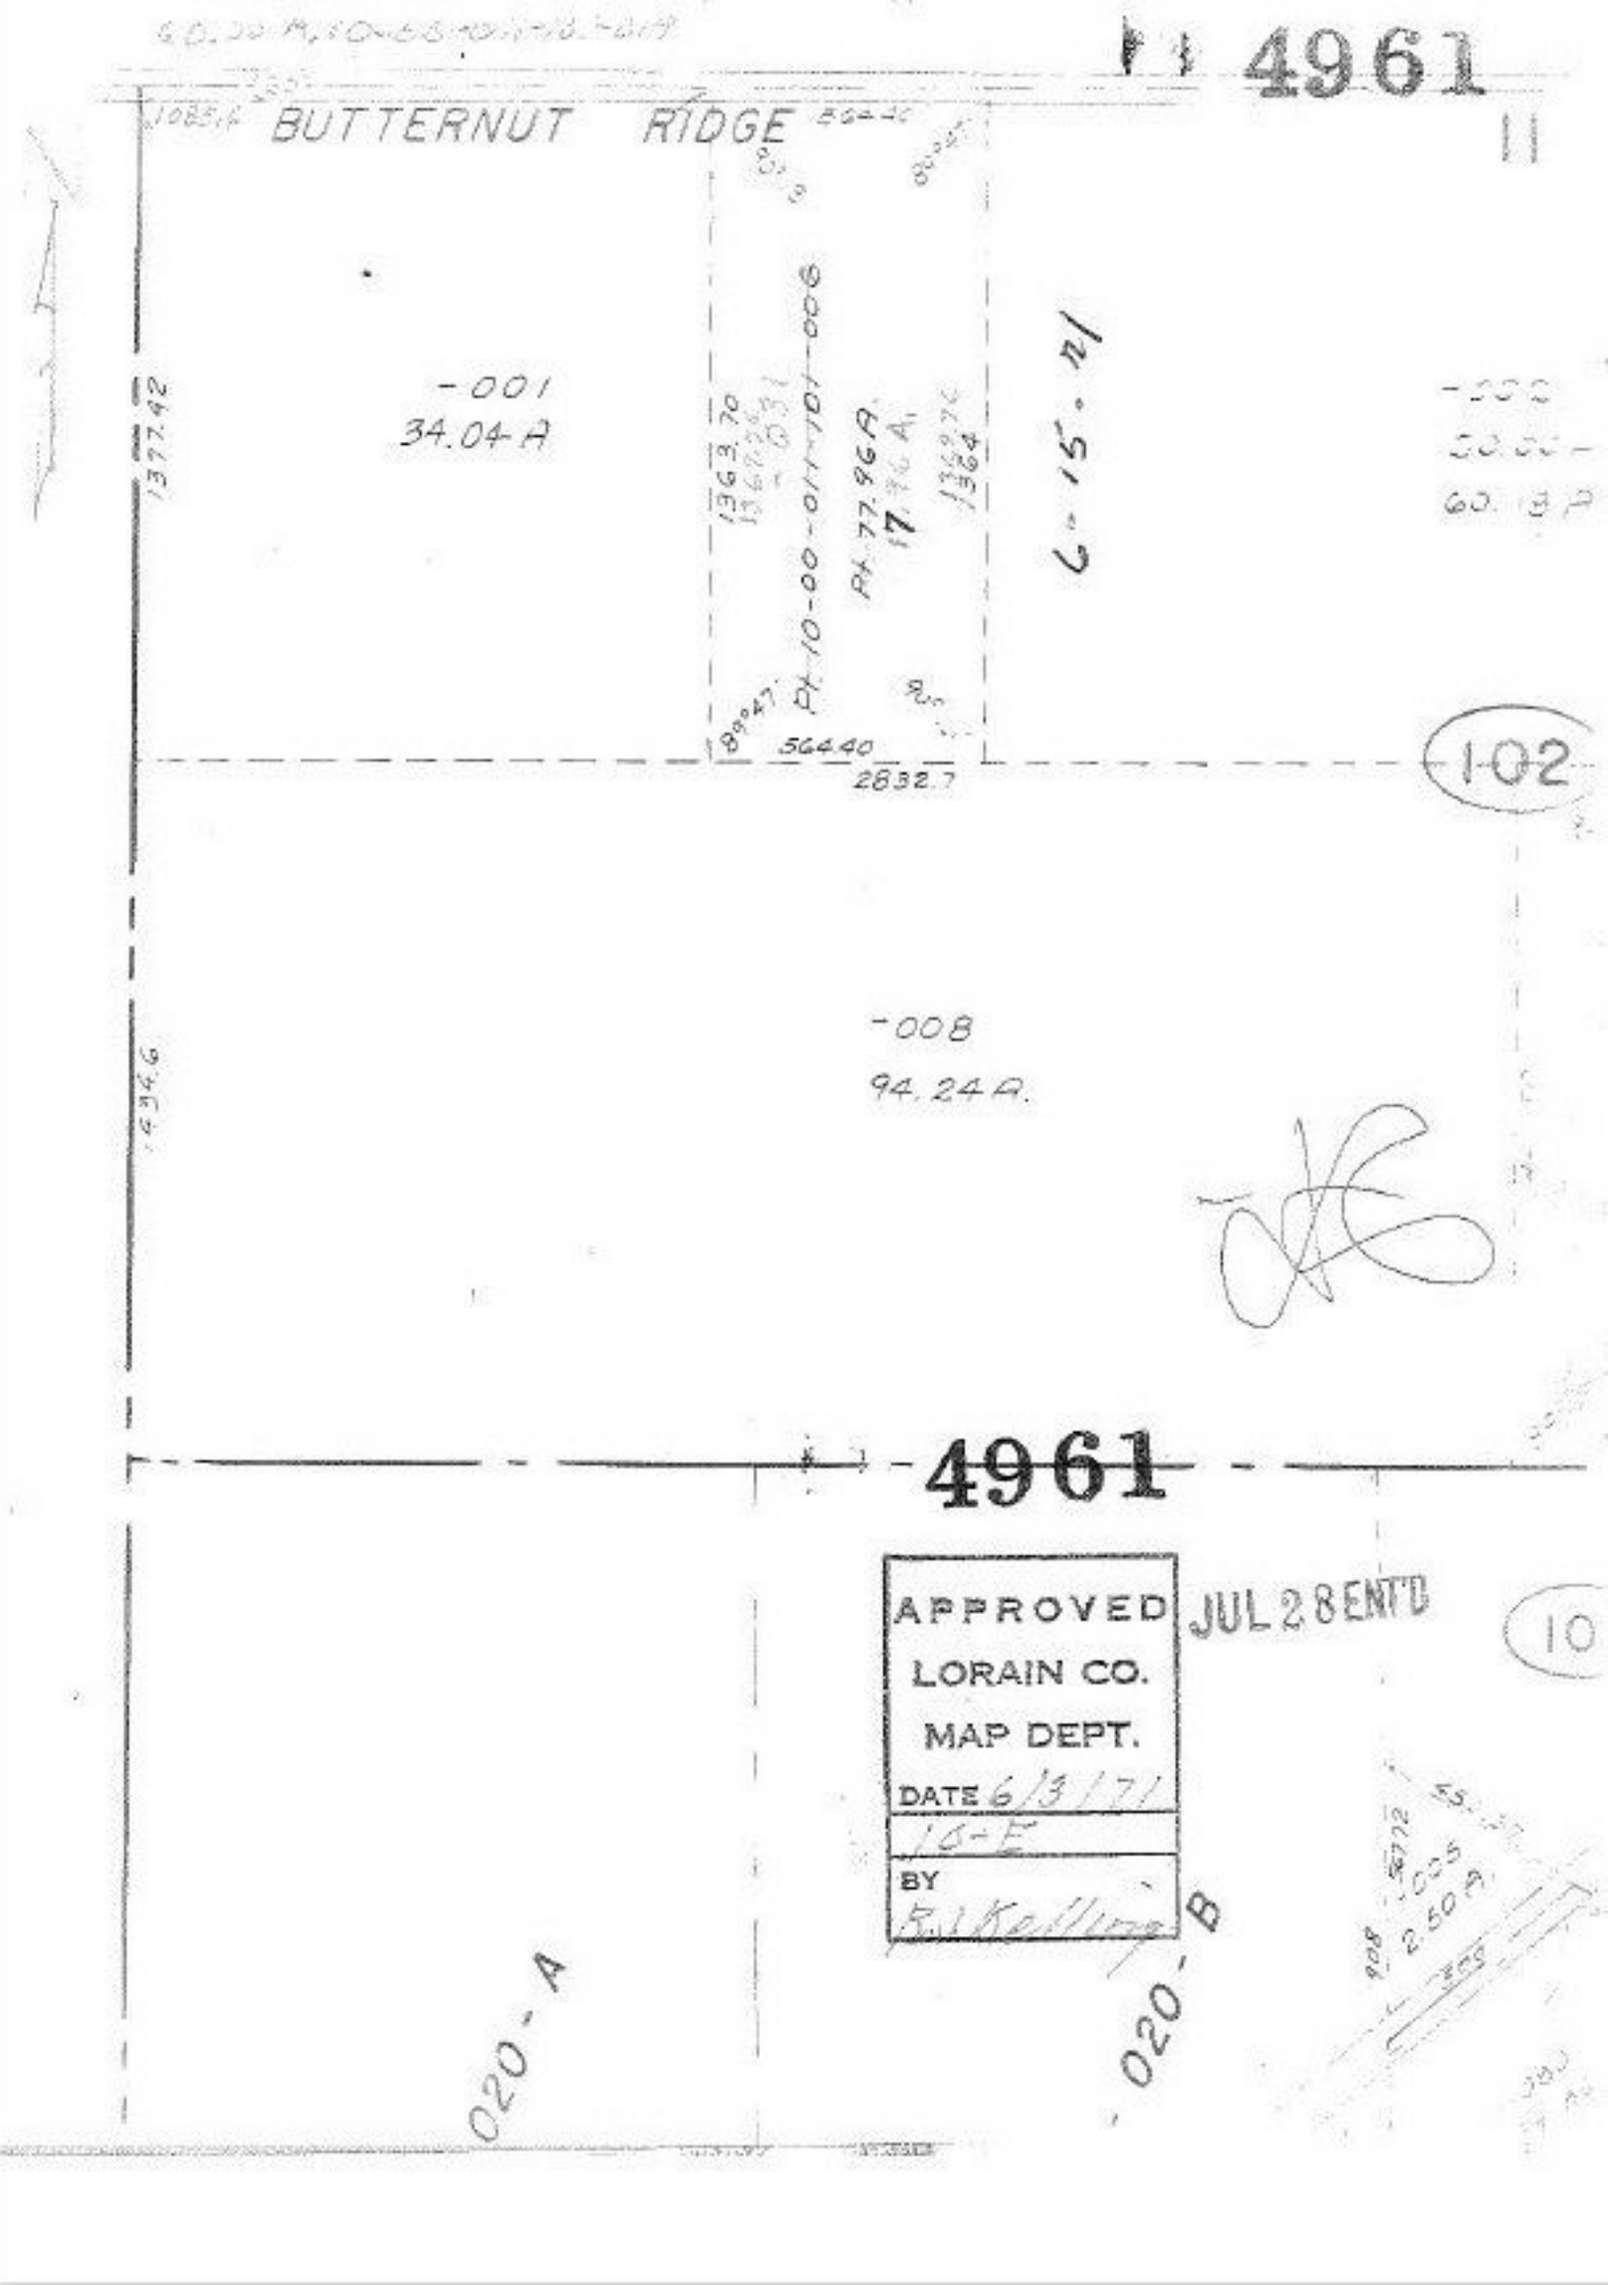
4961
11
BUTTERNUT RIDGE
-001
34.04 A
1377.42
1363.70
Pt. 10-00-011-101-006
Pt. 77.96 A
17.96 A
1364
6-15-71
564.40
2832.7
102
-008
94.24 A.
4961
APPROVED
LORAIN CO.
MAP DEPT.
DATE 6/3/71
10-E
BY
JUL 28 ENT'D
10
020-A
020-B
2.50 A