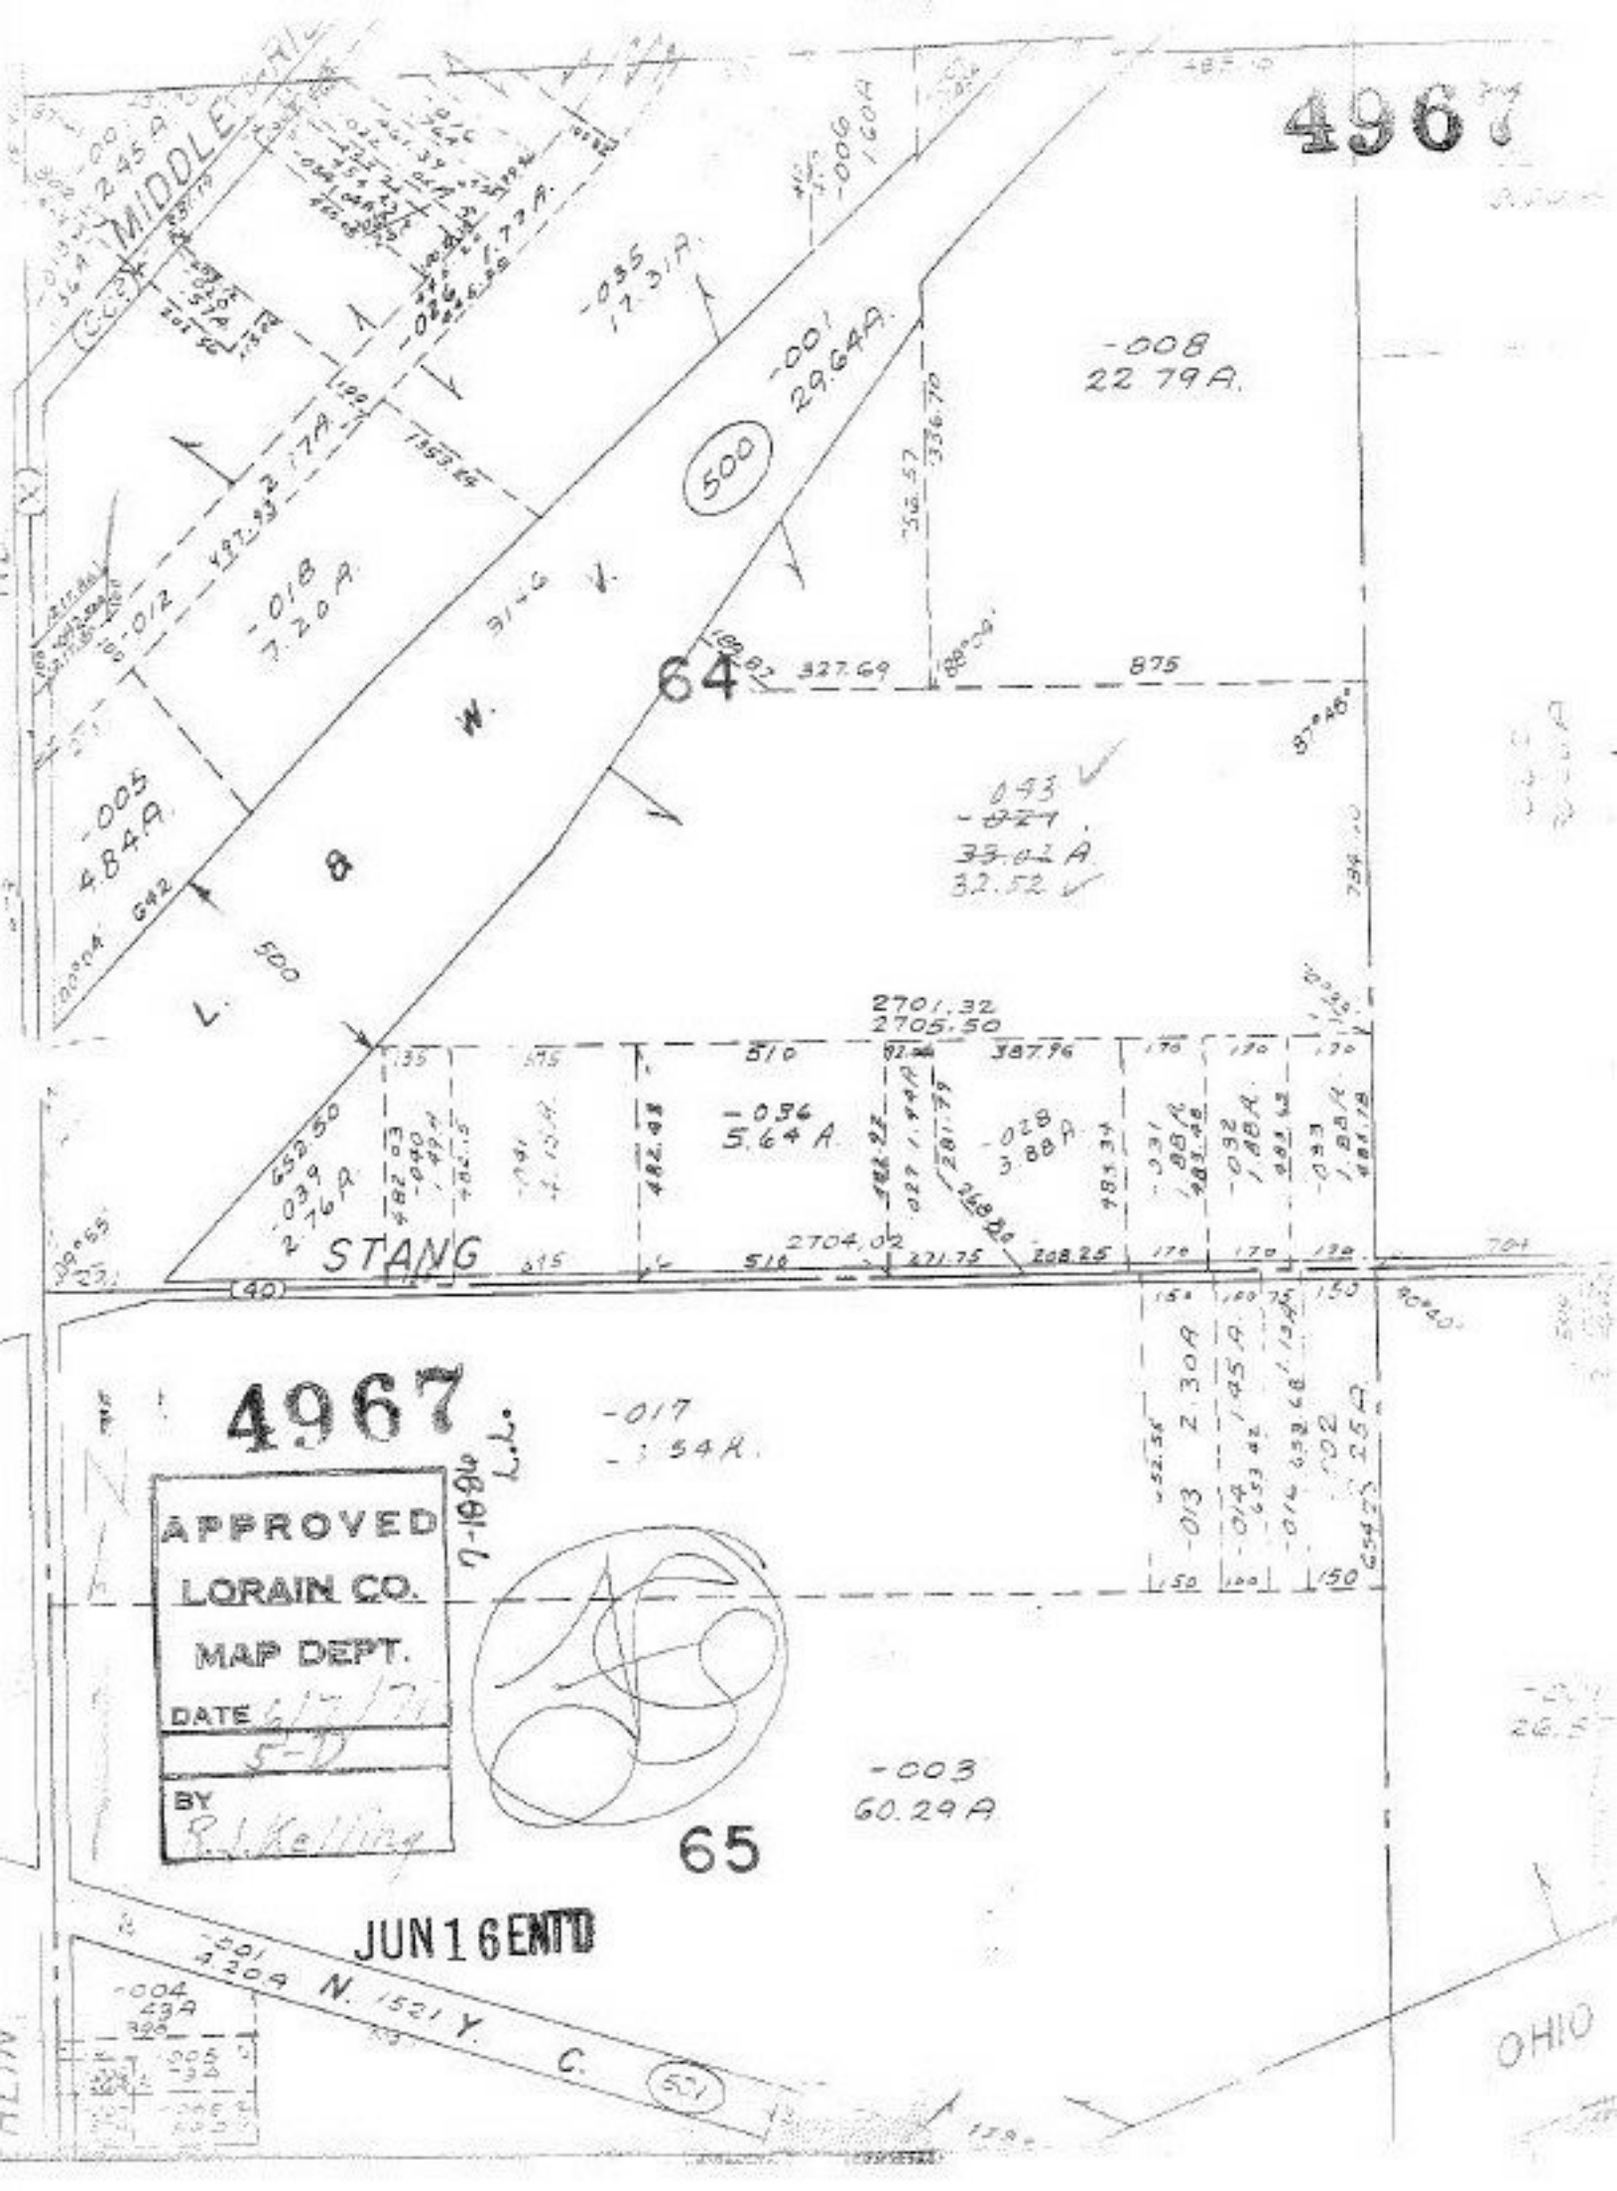
4967
MIDDLE
-035
17.31A
-001
29.64A
-008
22.79A
500
-018
7.20A
64
327.69
875
-005
4.84A
-043
32.52
L. B. W. V.
500
2701.32
2705.50
510
387.96
-036
5.64A
-028
3.88A
-039
2.76A
STANG
2704.02
510
271.75
208.25
4967
-017
-003
60.29A
65
APPROVED
LORAIN CO.
MAP DEPT.
DATE
BY
JUN 16 ENT'D
N. 1521 Y. C.
OHIO