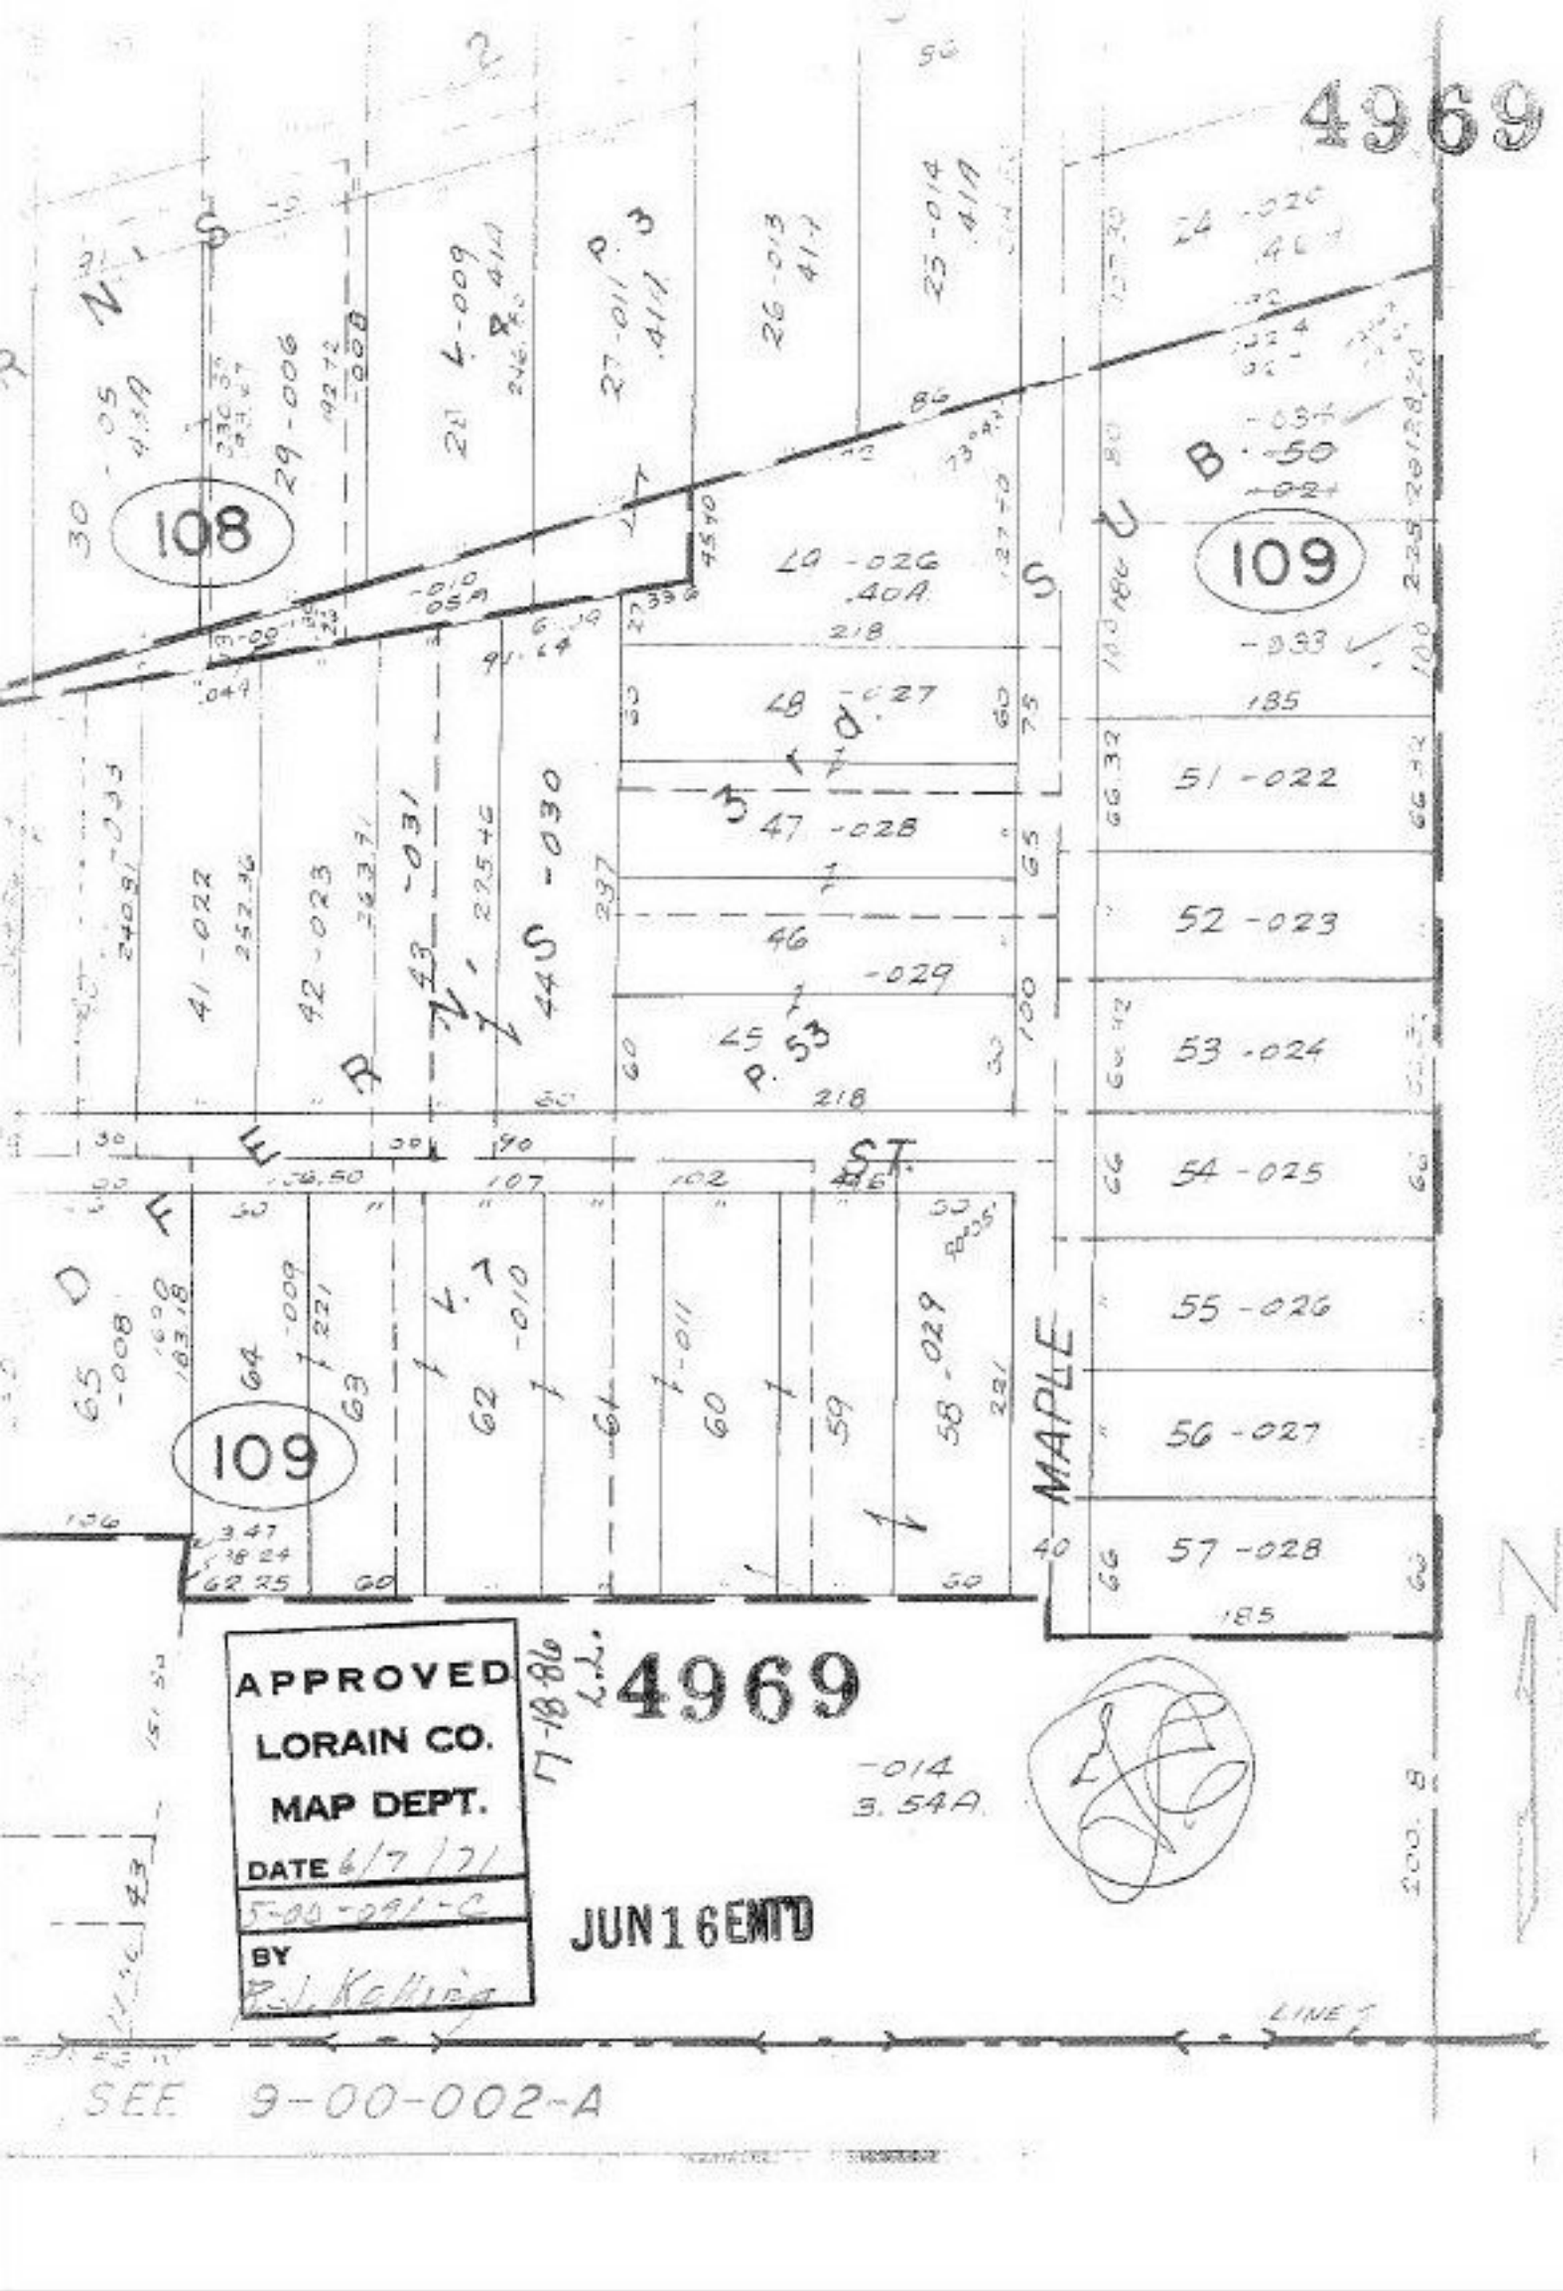
4969
108
109
109
MAPLE ST.
APPROVED
LORAIN CO.
MAP DEPT.
DATE 6/7/71
BY P.J. Kalina
JUN 16 ENTD
7-18-86
4969
SEE 9-00-002-A