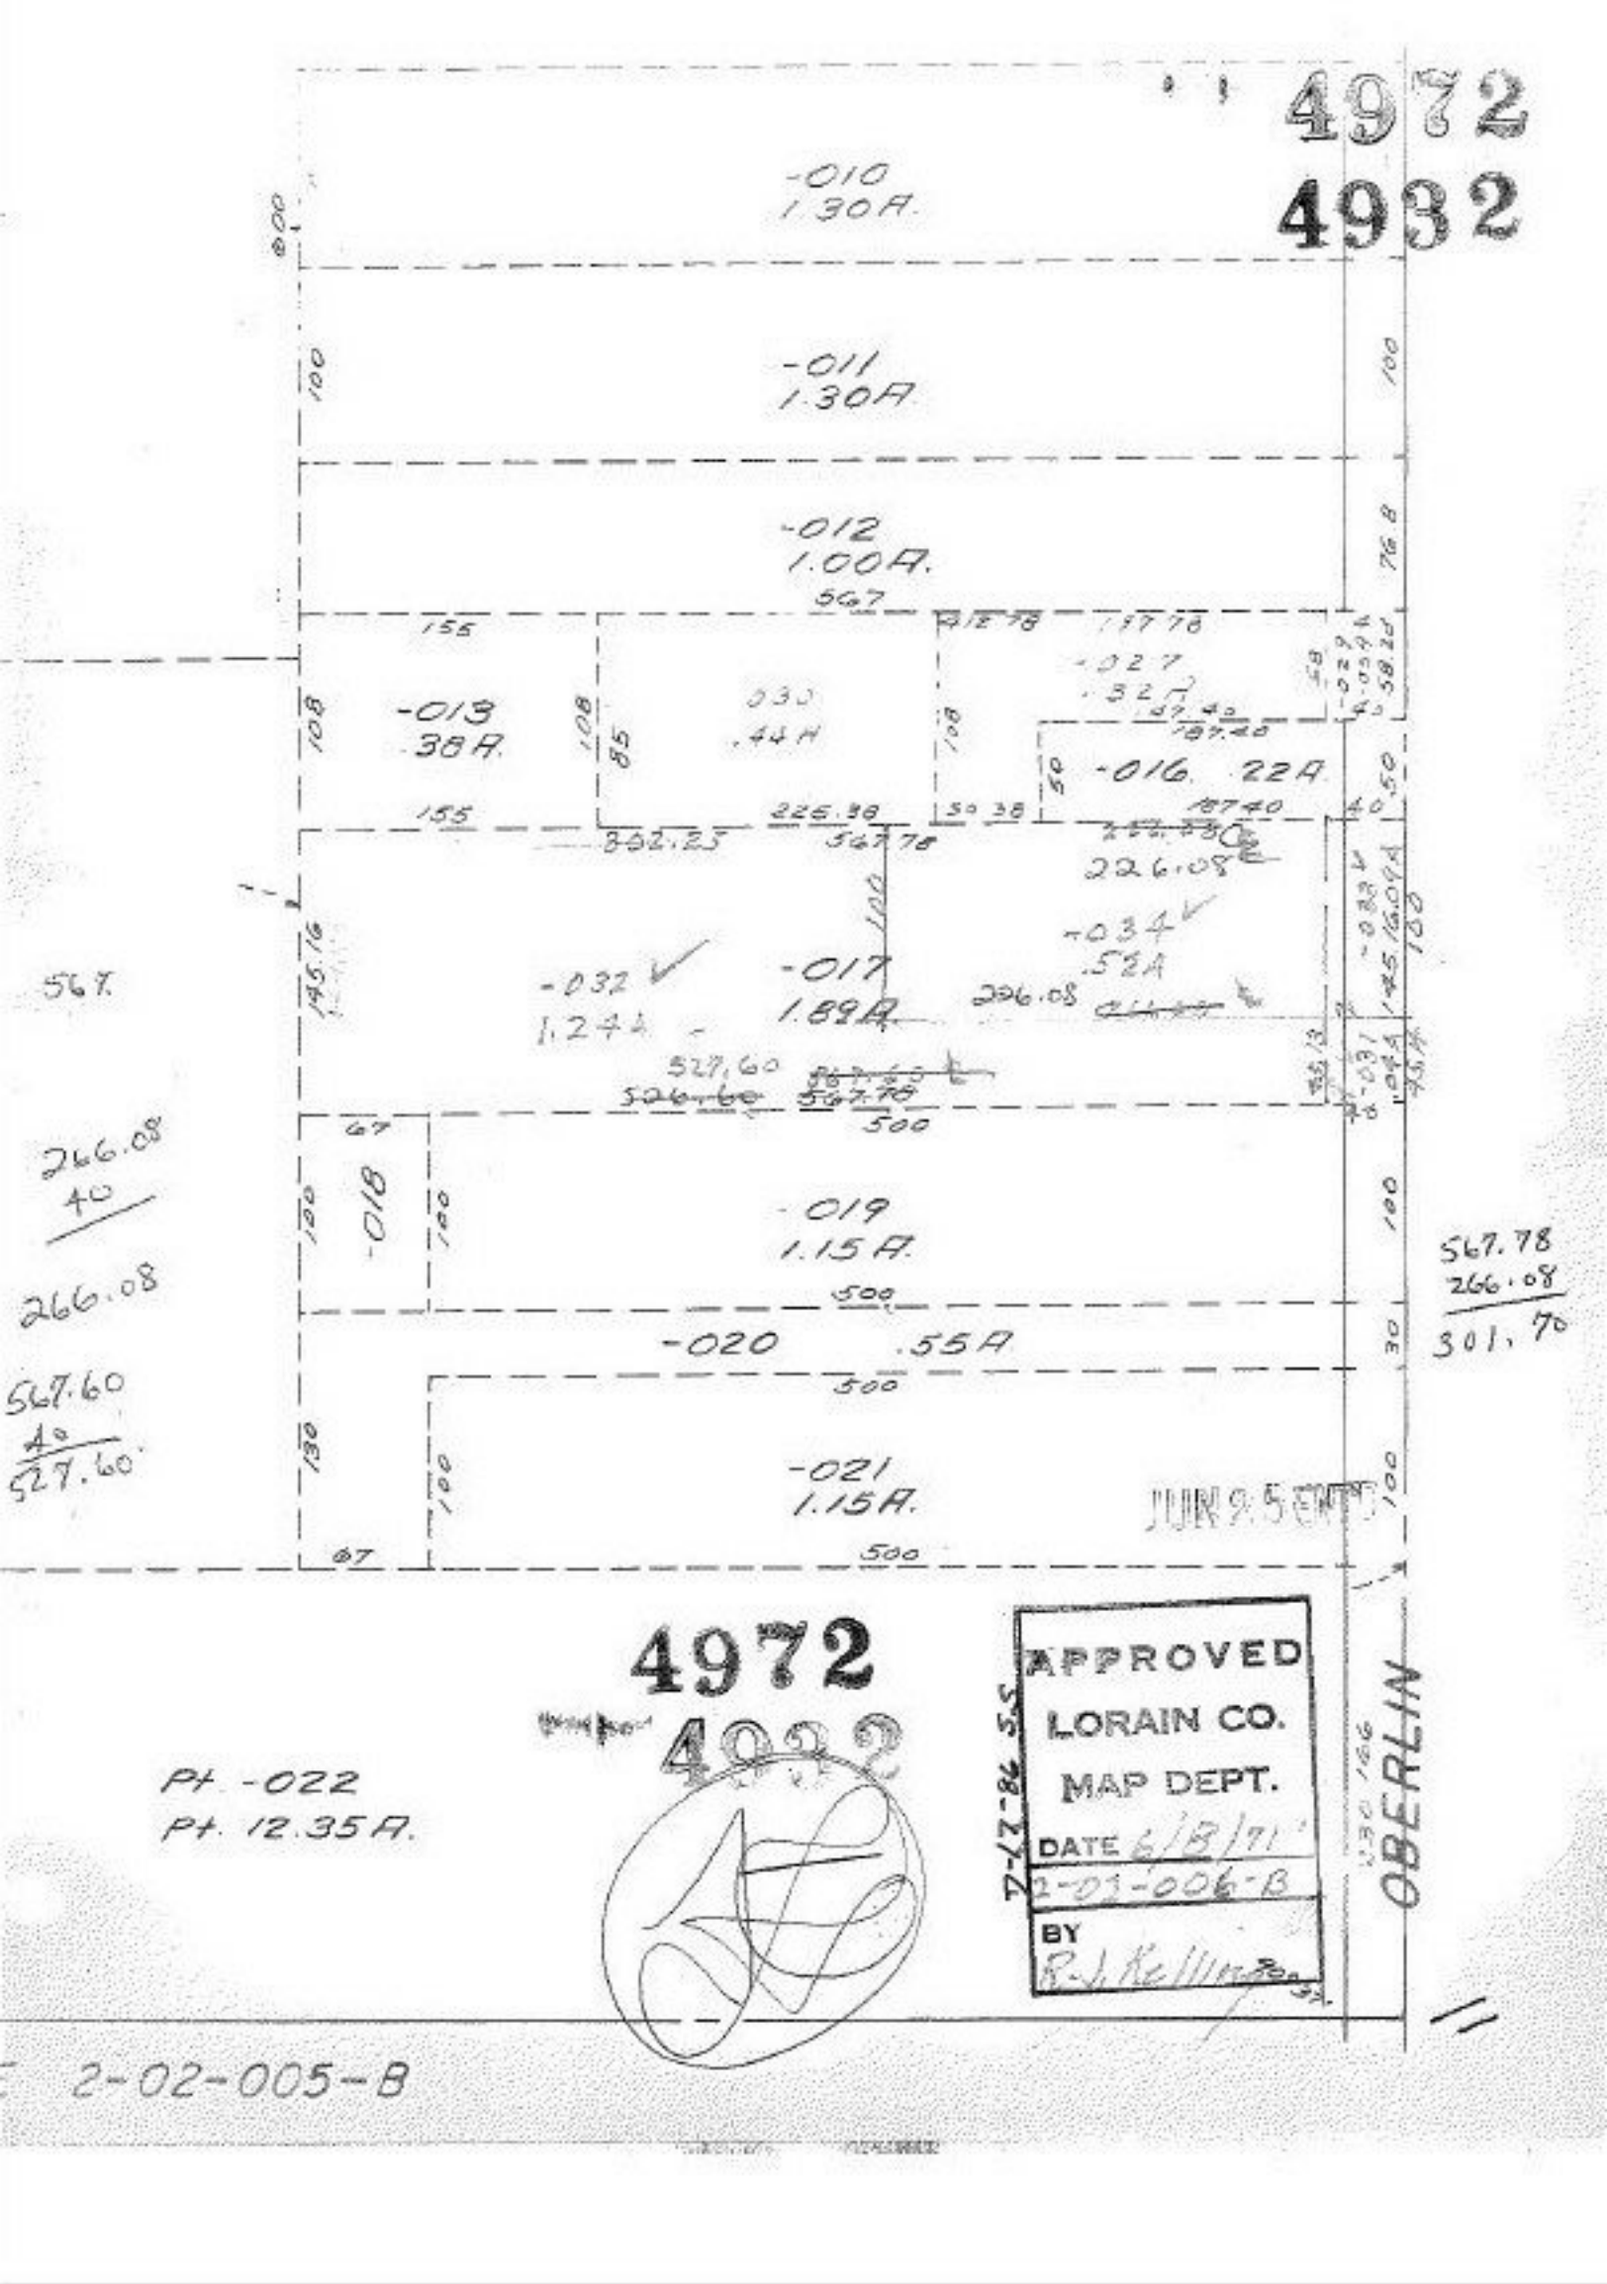
4972
4932
-010
1.30A.
-011
1.30A.
-012
1.00A.
-013
.38A.
-016 .22A
-017
1.89A.
-018
-019
1.15A.
-020 .55A
-021
1.15A.
-027
.32A.
-032
1.24A.
-034
.52A
567.78
266.08
40
301.70
527.60
4972
4932
Pt. -022
Pt. 12.35A.
APPROVED
LORAIN CO.
MAP DEPT.
DATE 6/8/71
2-01-006-B
BY R.J. Kellington
7-12-86 SS
OBERLIN
2-02-005-B