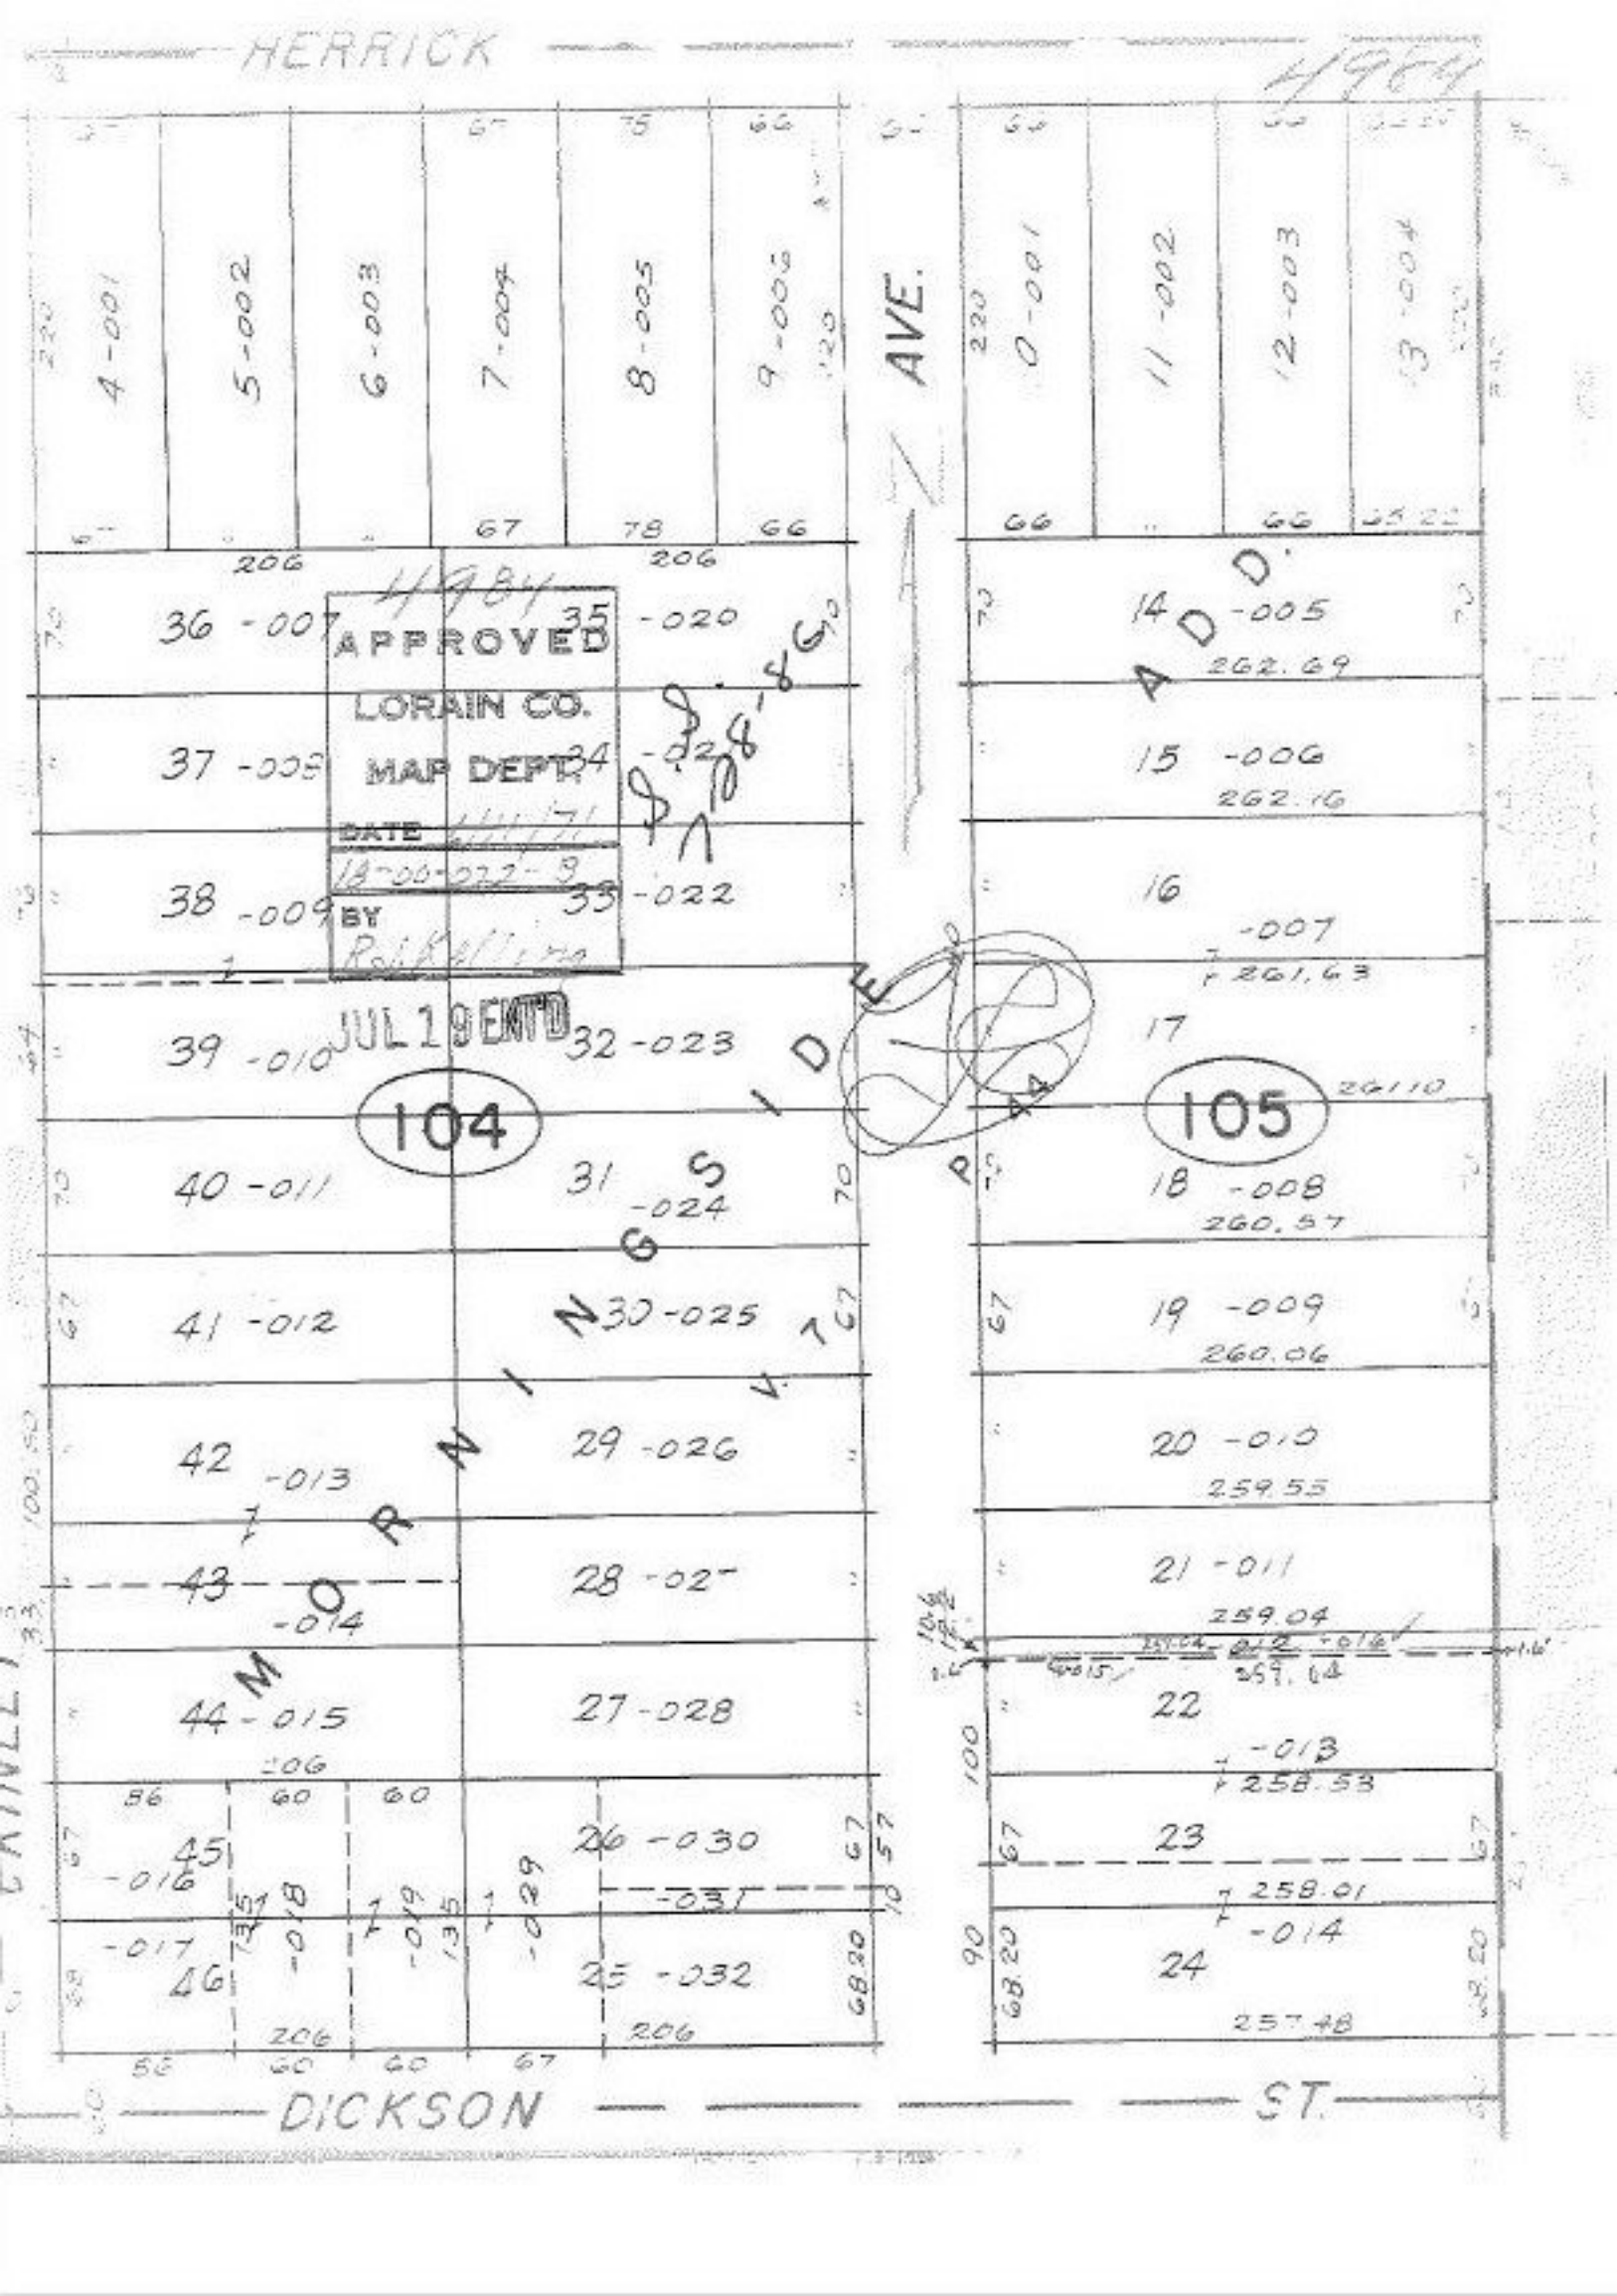
HERRICK
4964
4-001
5-002
6-003
7-004
8-005
9-006
0-001
11-002
12-003
13-004
AVE.
4984
APPROVED
LORAIN CO.
MAP DEPT.
DATE
18-00-022-8
BY
JUL 19 ENT'D
104
105
MORNINGSIDE
ADD.
36 -007
35 -020
37 -008
34 -021
38 -009
33 -022
39 -010
32 -023
40 -011
31 -024
41 -012
30 -025
42 -013
29 -026
43 -014
28 -027
44 -015
27 -028
45 -016
26 -030
-031
46 -017
25 -032
14 -005
262.69
15 -006
262.16
16 -007
261.63
17
261.10
18 -008
260.57
19 -009
260.06
20 -010
259.55
21 -011
259.04
22 -013
258.53
23
258.01
24 -014
257.48
DICKSON
ST.