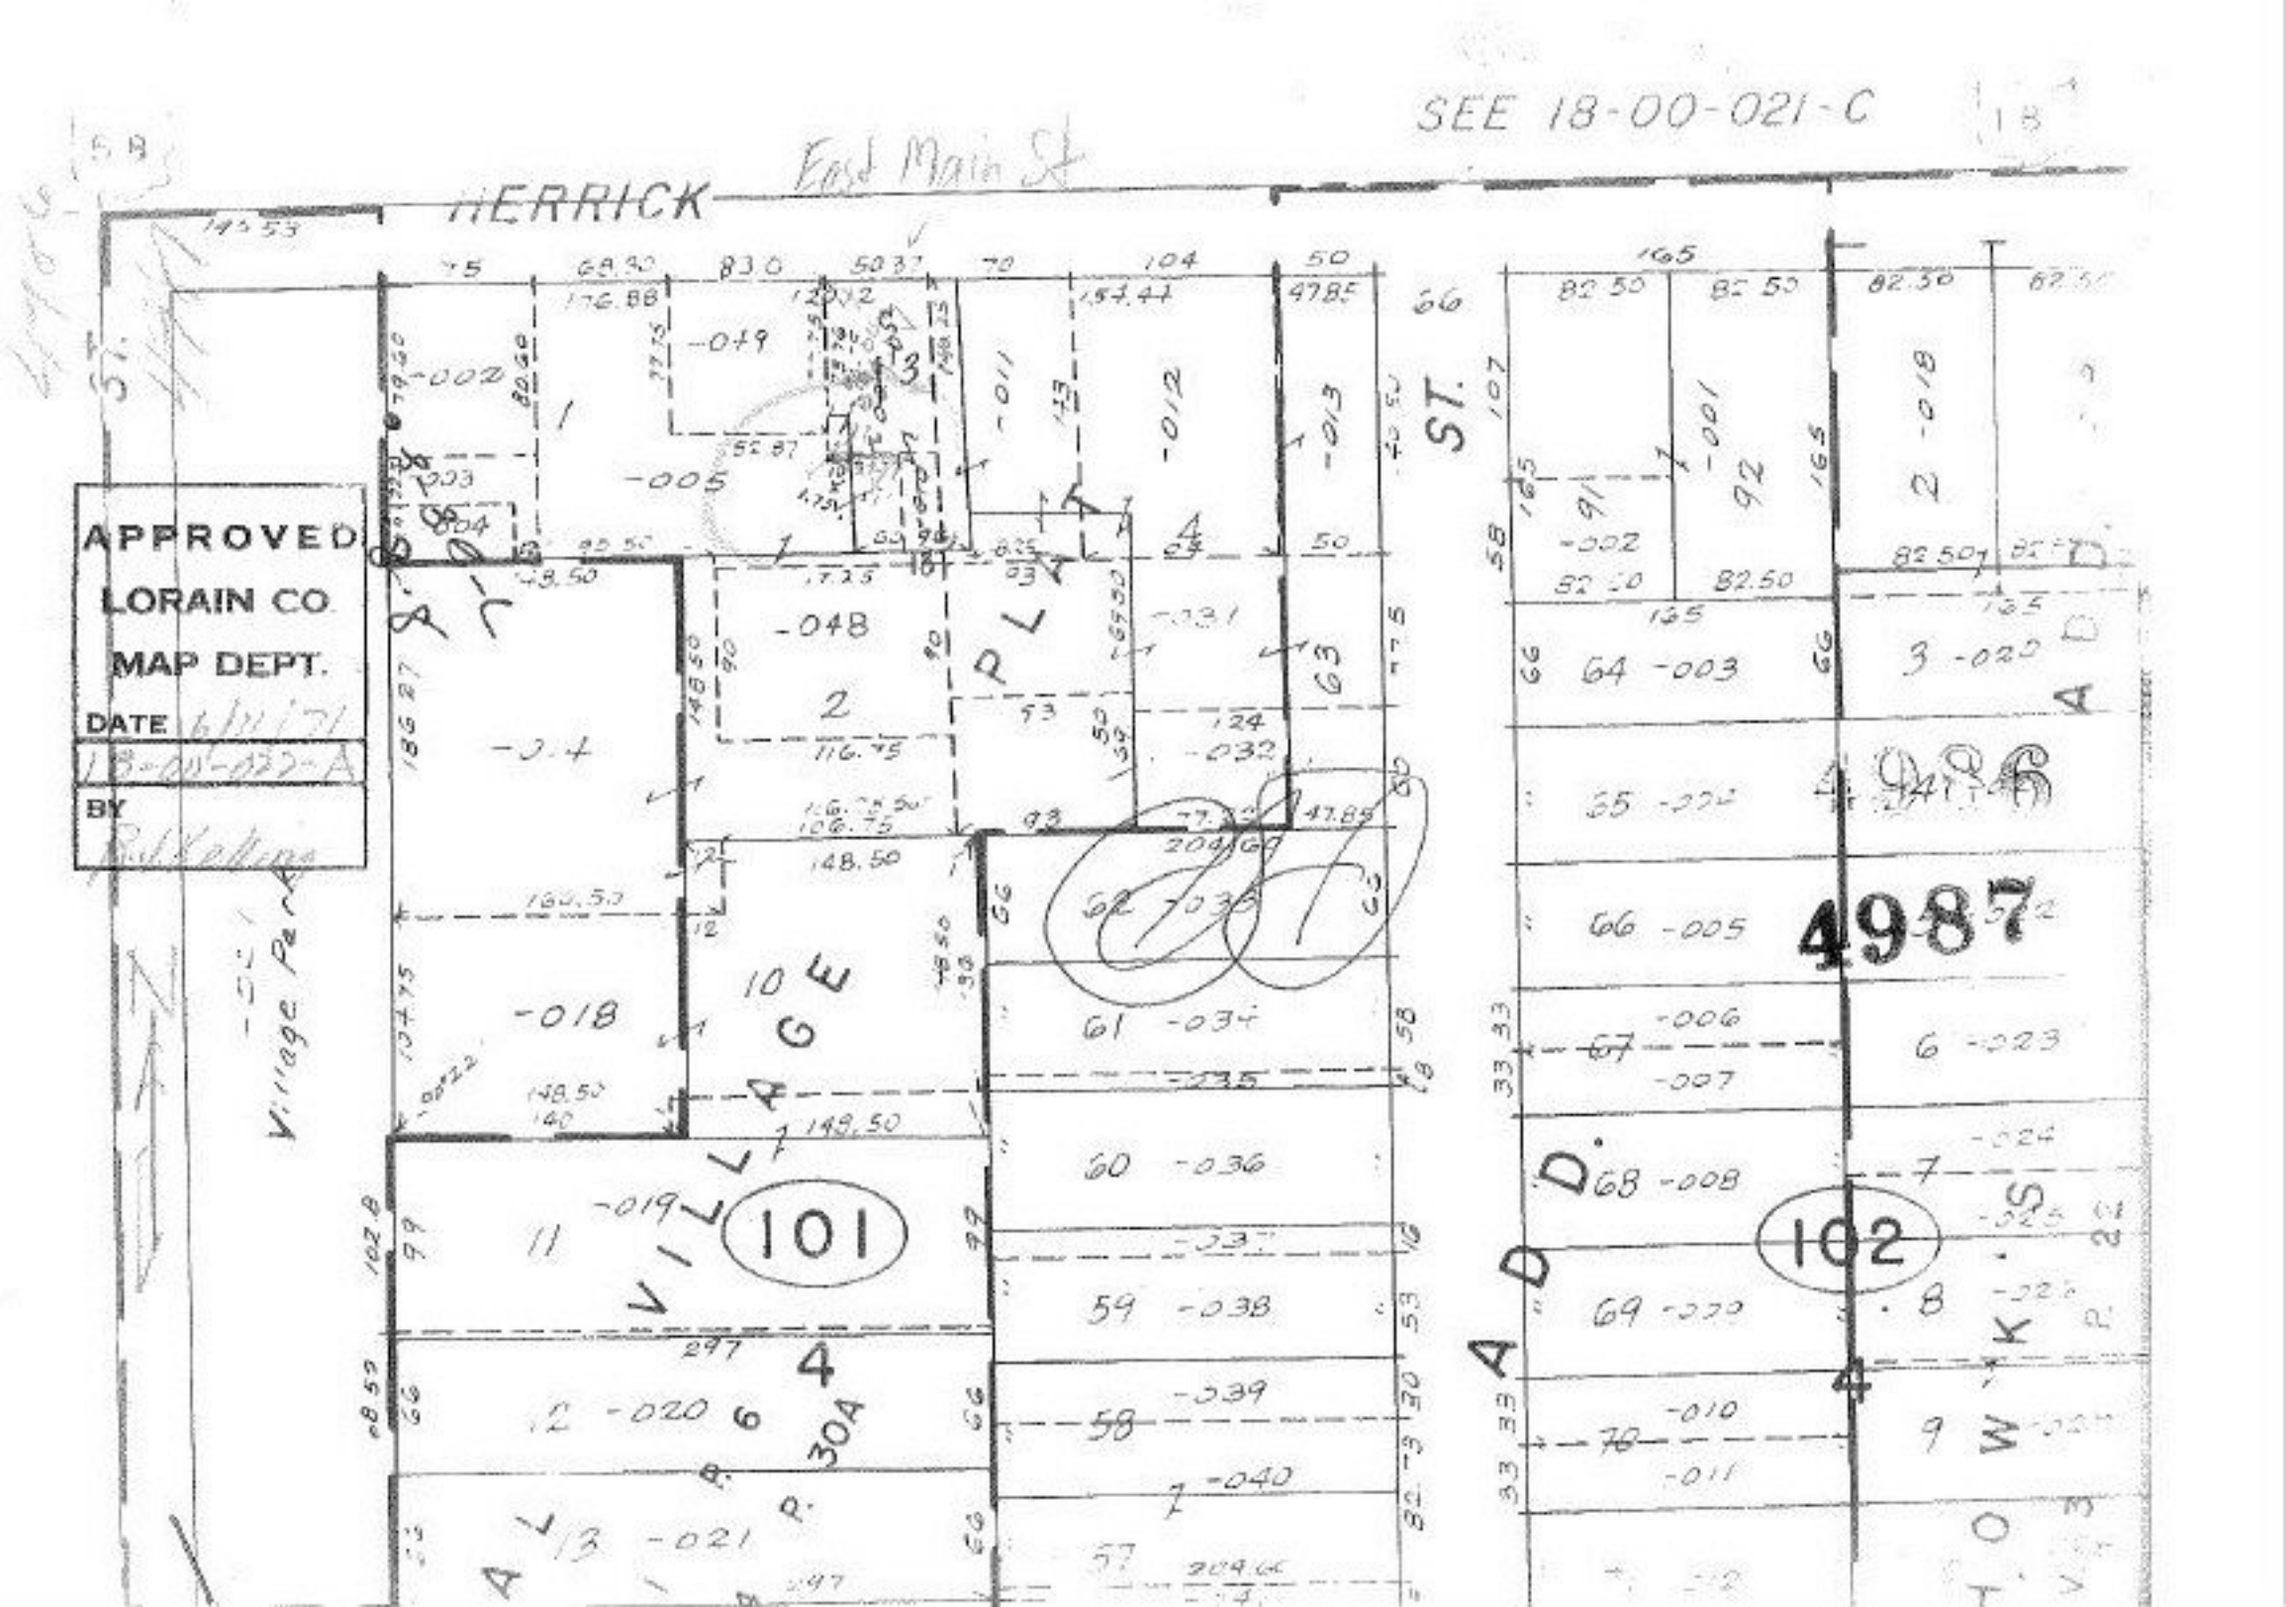
SEE 18-00-021-C
HERRICK
East Main St
APPROVED
LORAIN CO.
MAP DEPT.
DATE 6/11/71
18-00-022-A
BY
Village Park
VILLAGE
PLAT
ST.
ADD.
101
102
4987
4986