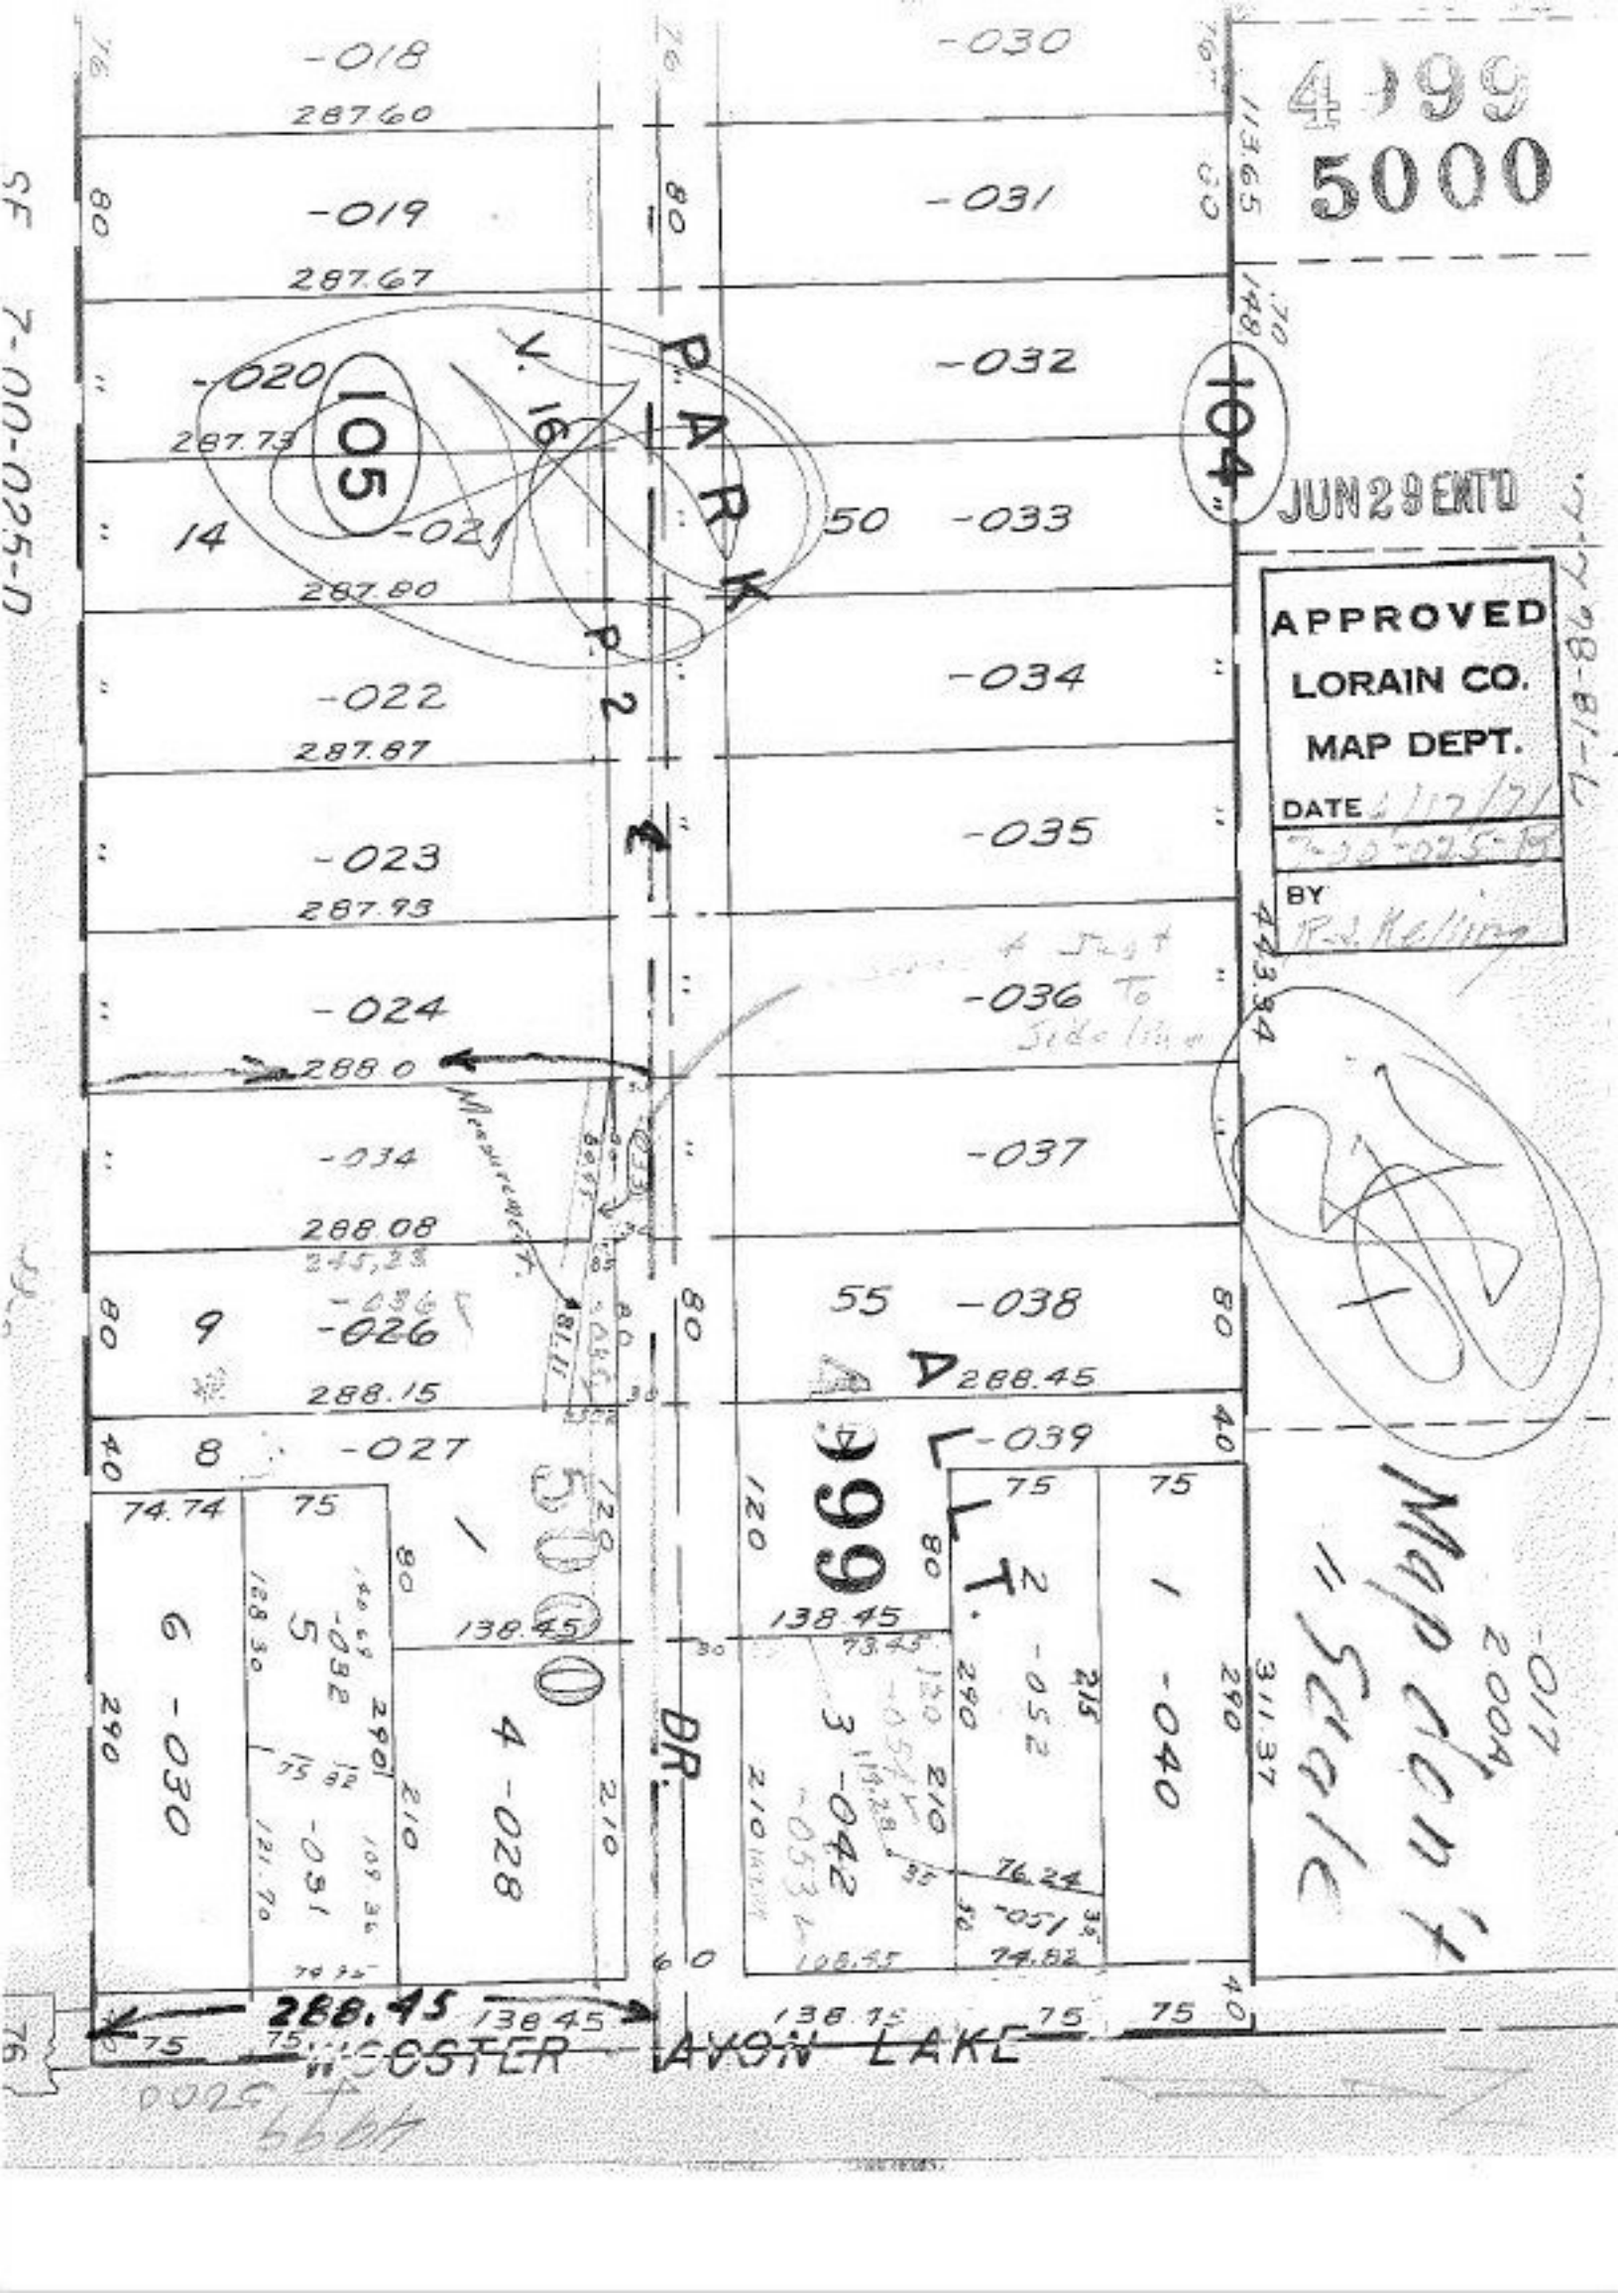
-018
287.60
-019
287.67
-020
287.73
-021
287.80
-022
287.87
-023
287.93
-024
288.0
-034
288.08
-026
288.15
-027
-030
-031
-032
-033
-034
-035
-036 To Side line
-037
-038
-039
105
104
PARK
V. 16
P. 2
4199
5000
JUN 29 ENTD
APPROVED
LORAIN CO.
MAP DEPT.
DATE 7/12/71
BY R.J. Kelling
Map Out
Street
288.45
138.45
AVON LAKE
BR.
LT.