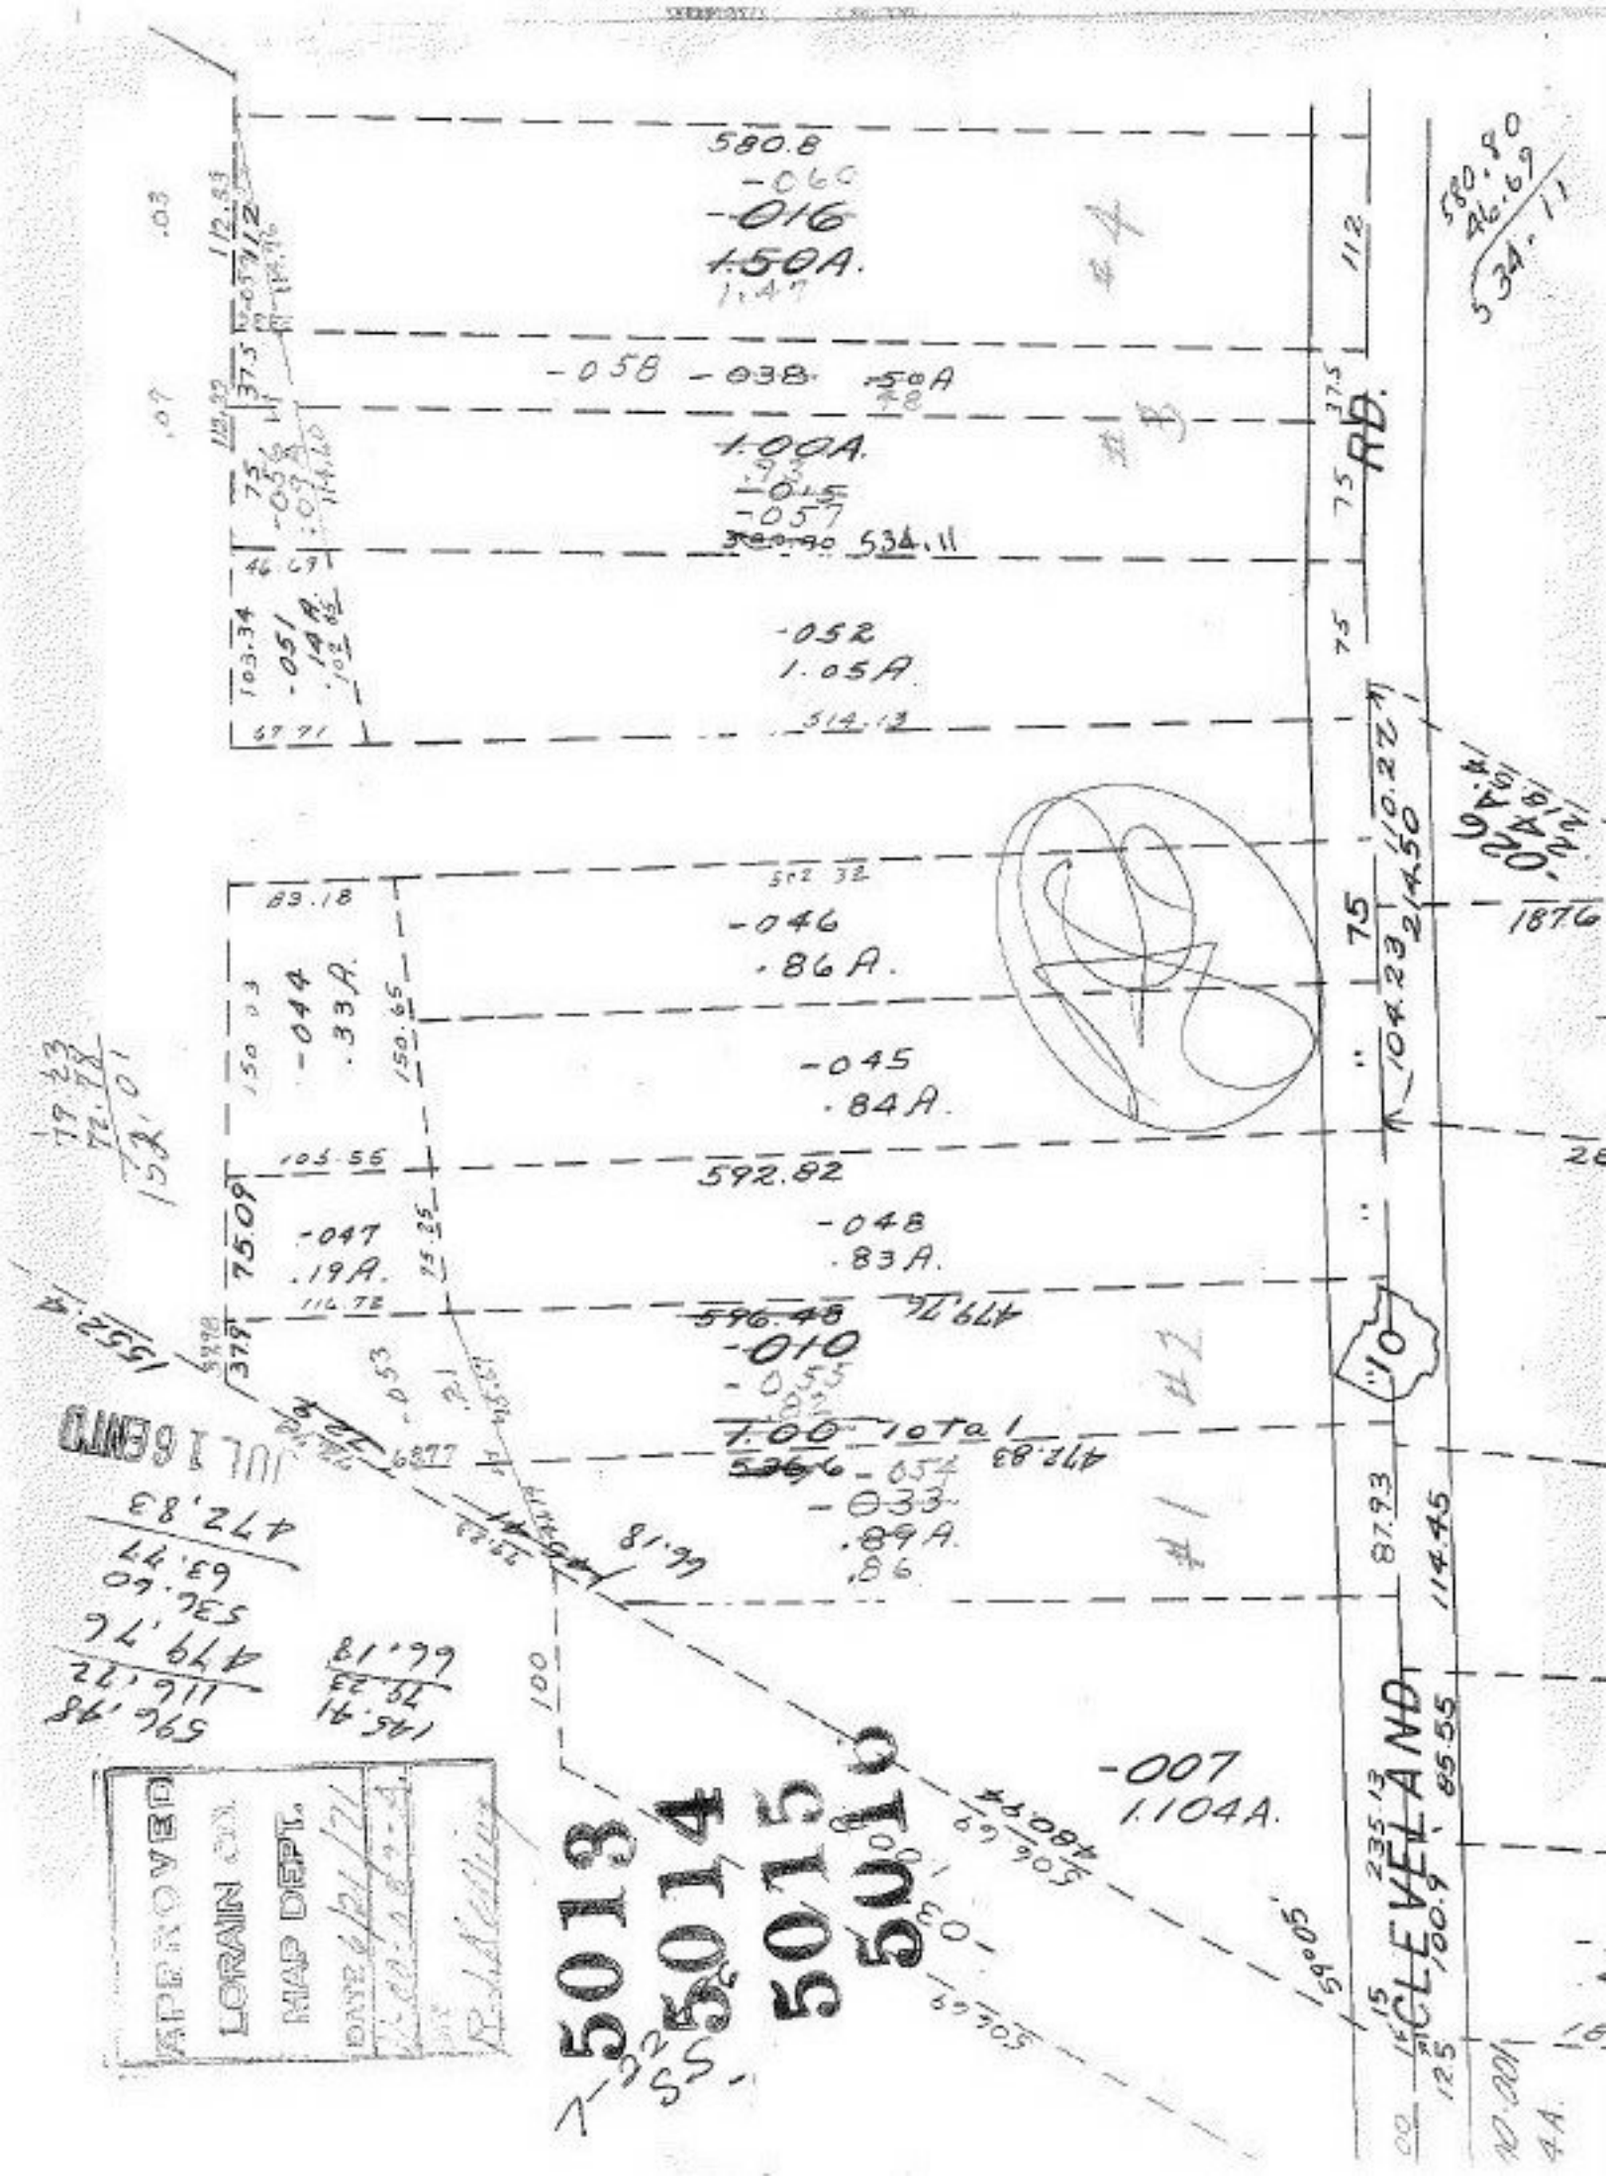

580.8
-060
-016
1.50A.
1.47
-058
-038
.50A
1.00A.
-015
-057
534.11
-052
1.05A.
514.13
-046
.86A.
-045
.84A.
592.82
-048
.83A.
-047
.19A.
596.48
-010
-055
1.00 total
-054
-033
.89A.
.86
-007
1.104A.
RD.
CLEVELAND
JUL 16 ENTD
APPROVED
LORAIN CO.
MAP DEPT.
DATE
5013
5014
5015
5016