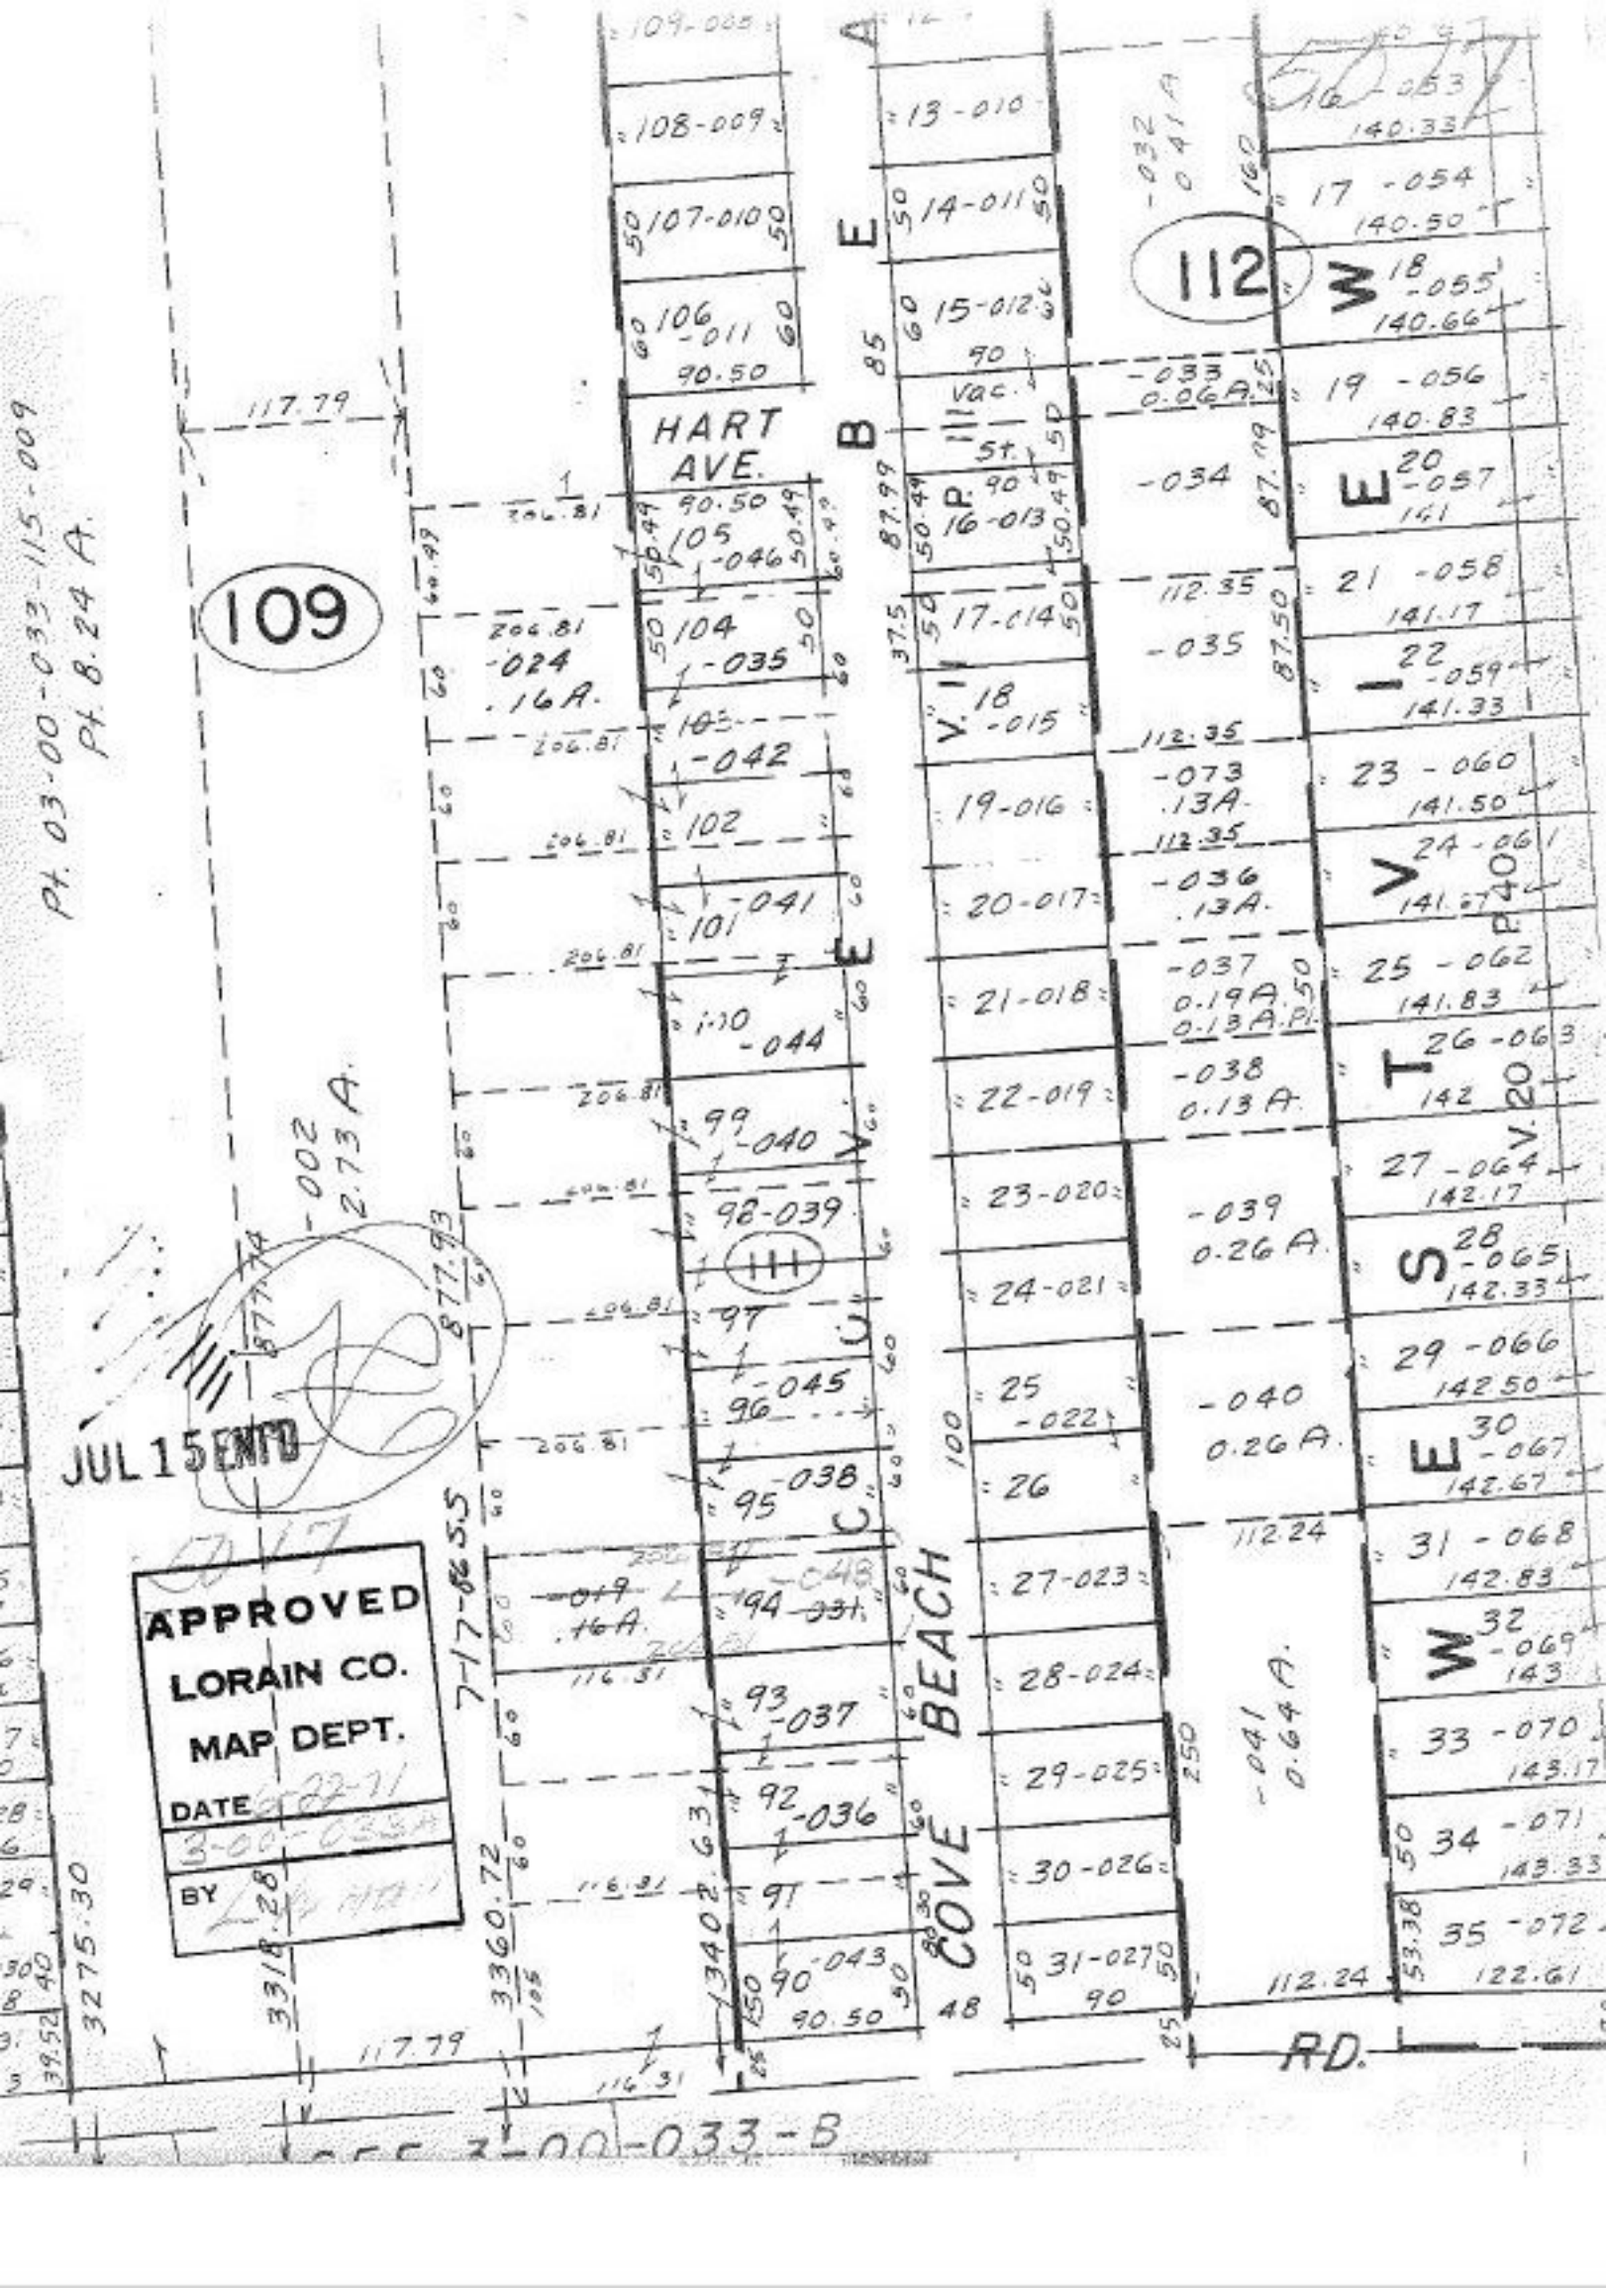
109
112
HART AVE.
BEACH
COVE
RD.
APPROVED
LORAIN CO.
MAP DEPT.
DATE 6-22-71
BY
JUL 15 ENTD
7-17-86 S.S.
3-00-033-B