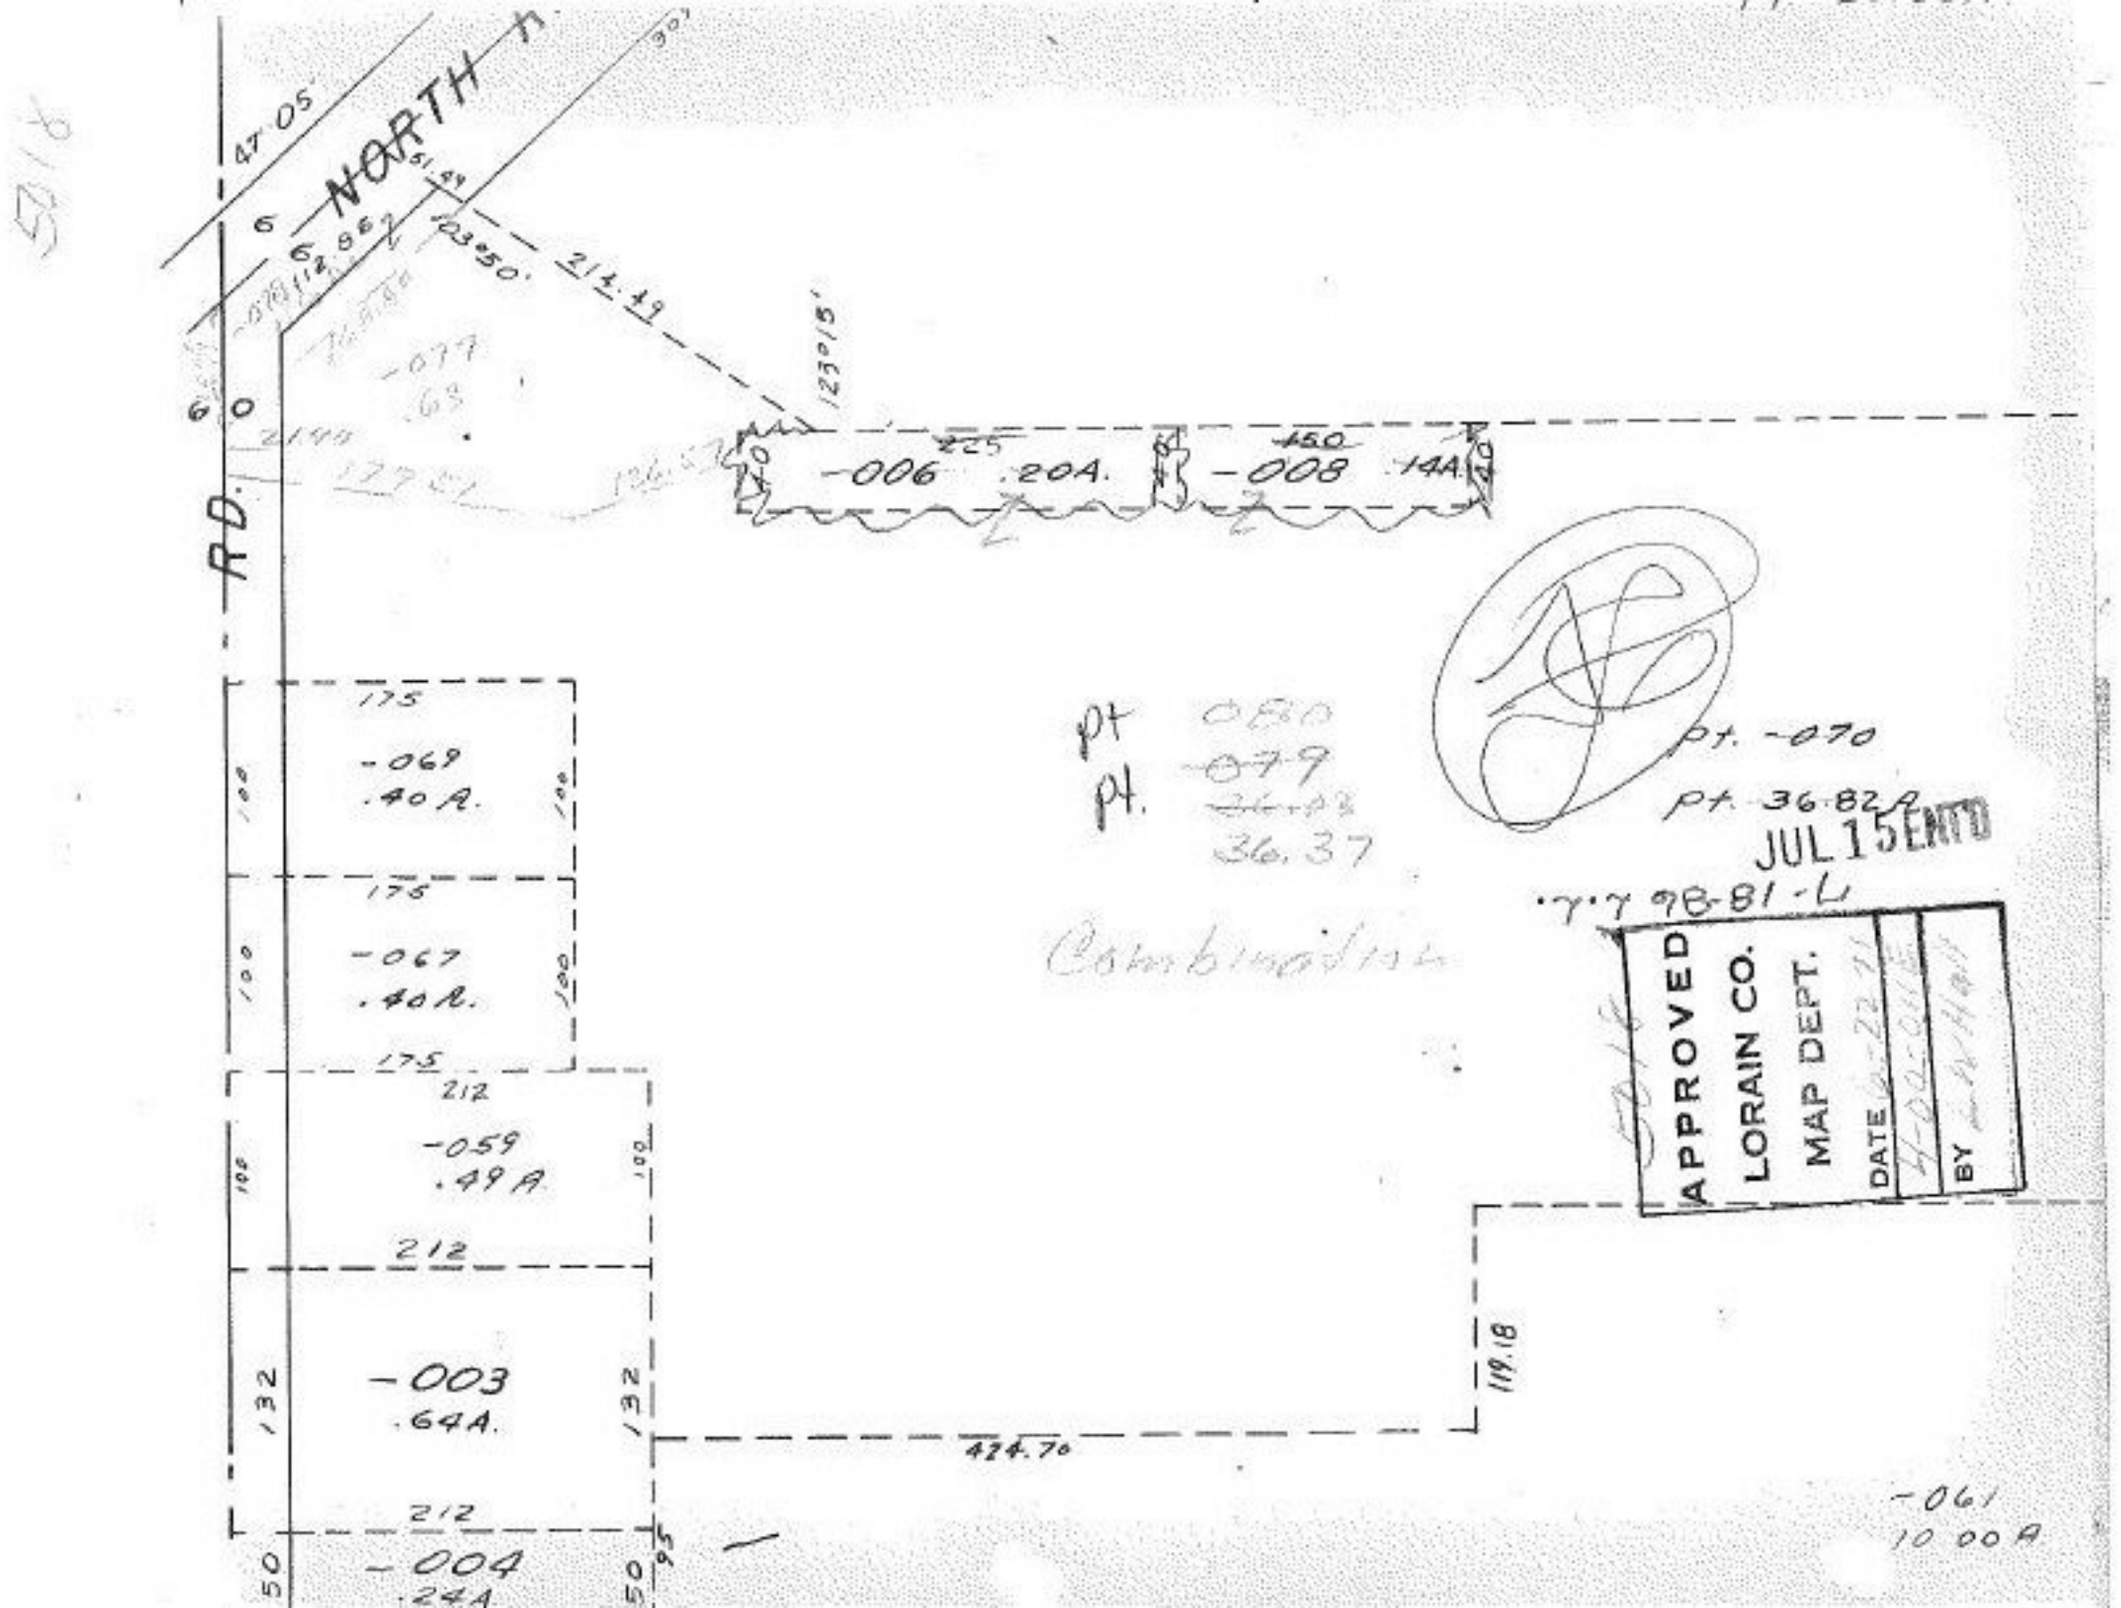
NORTH
RD.
47.05'
51.49
103°50'
214.49
123°15'
-006 .20A.
225
-008 .14A.
150
-079
.63
175
-069
.40 A.
100
175
-067
.40 A.
100
175
212
-059
.49 A
100
212
-003
.64A.
132
132
212
-004
.24A
50
50
474.70
119.18
pt. 080
pt. 079
pt. 36.37
pt. -070
pt. 36.82A
JUL 15 ENTD
APPROVED
LORAIN CO.
MAP DEPT.
DATE
BY
-061
10.00A