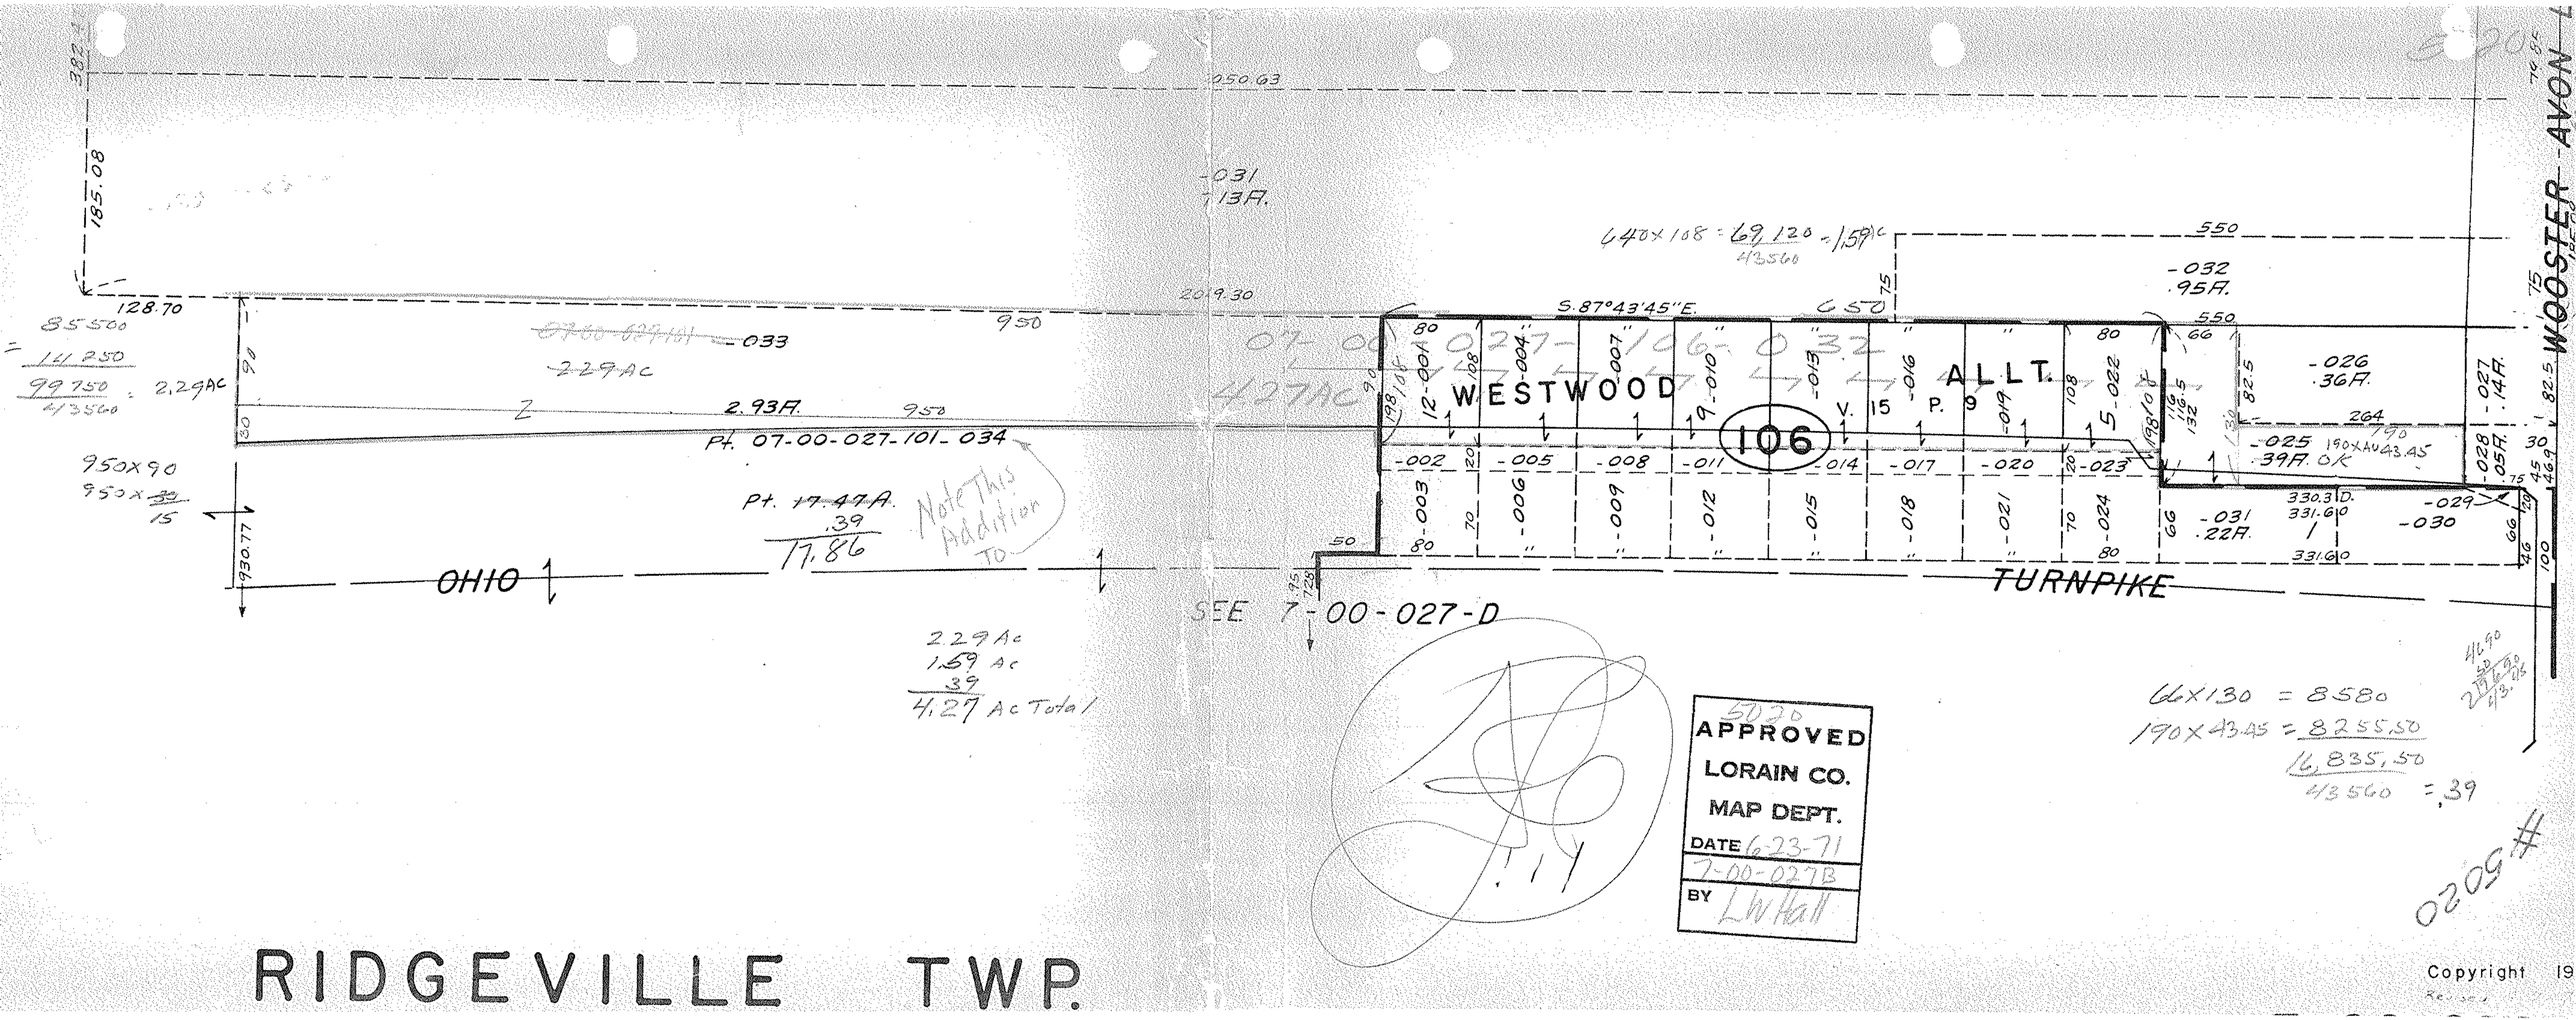

RIDGEVILLE TWP.

Copyright 19