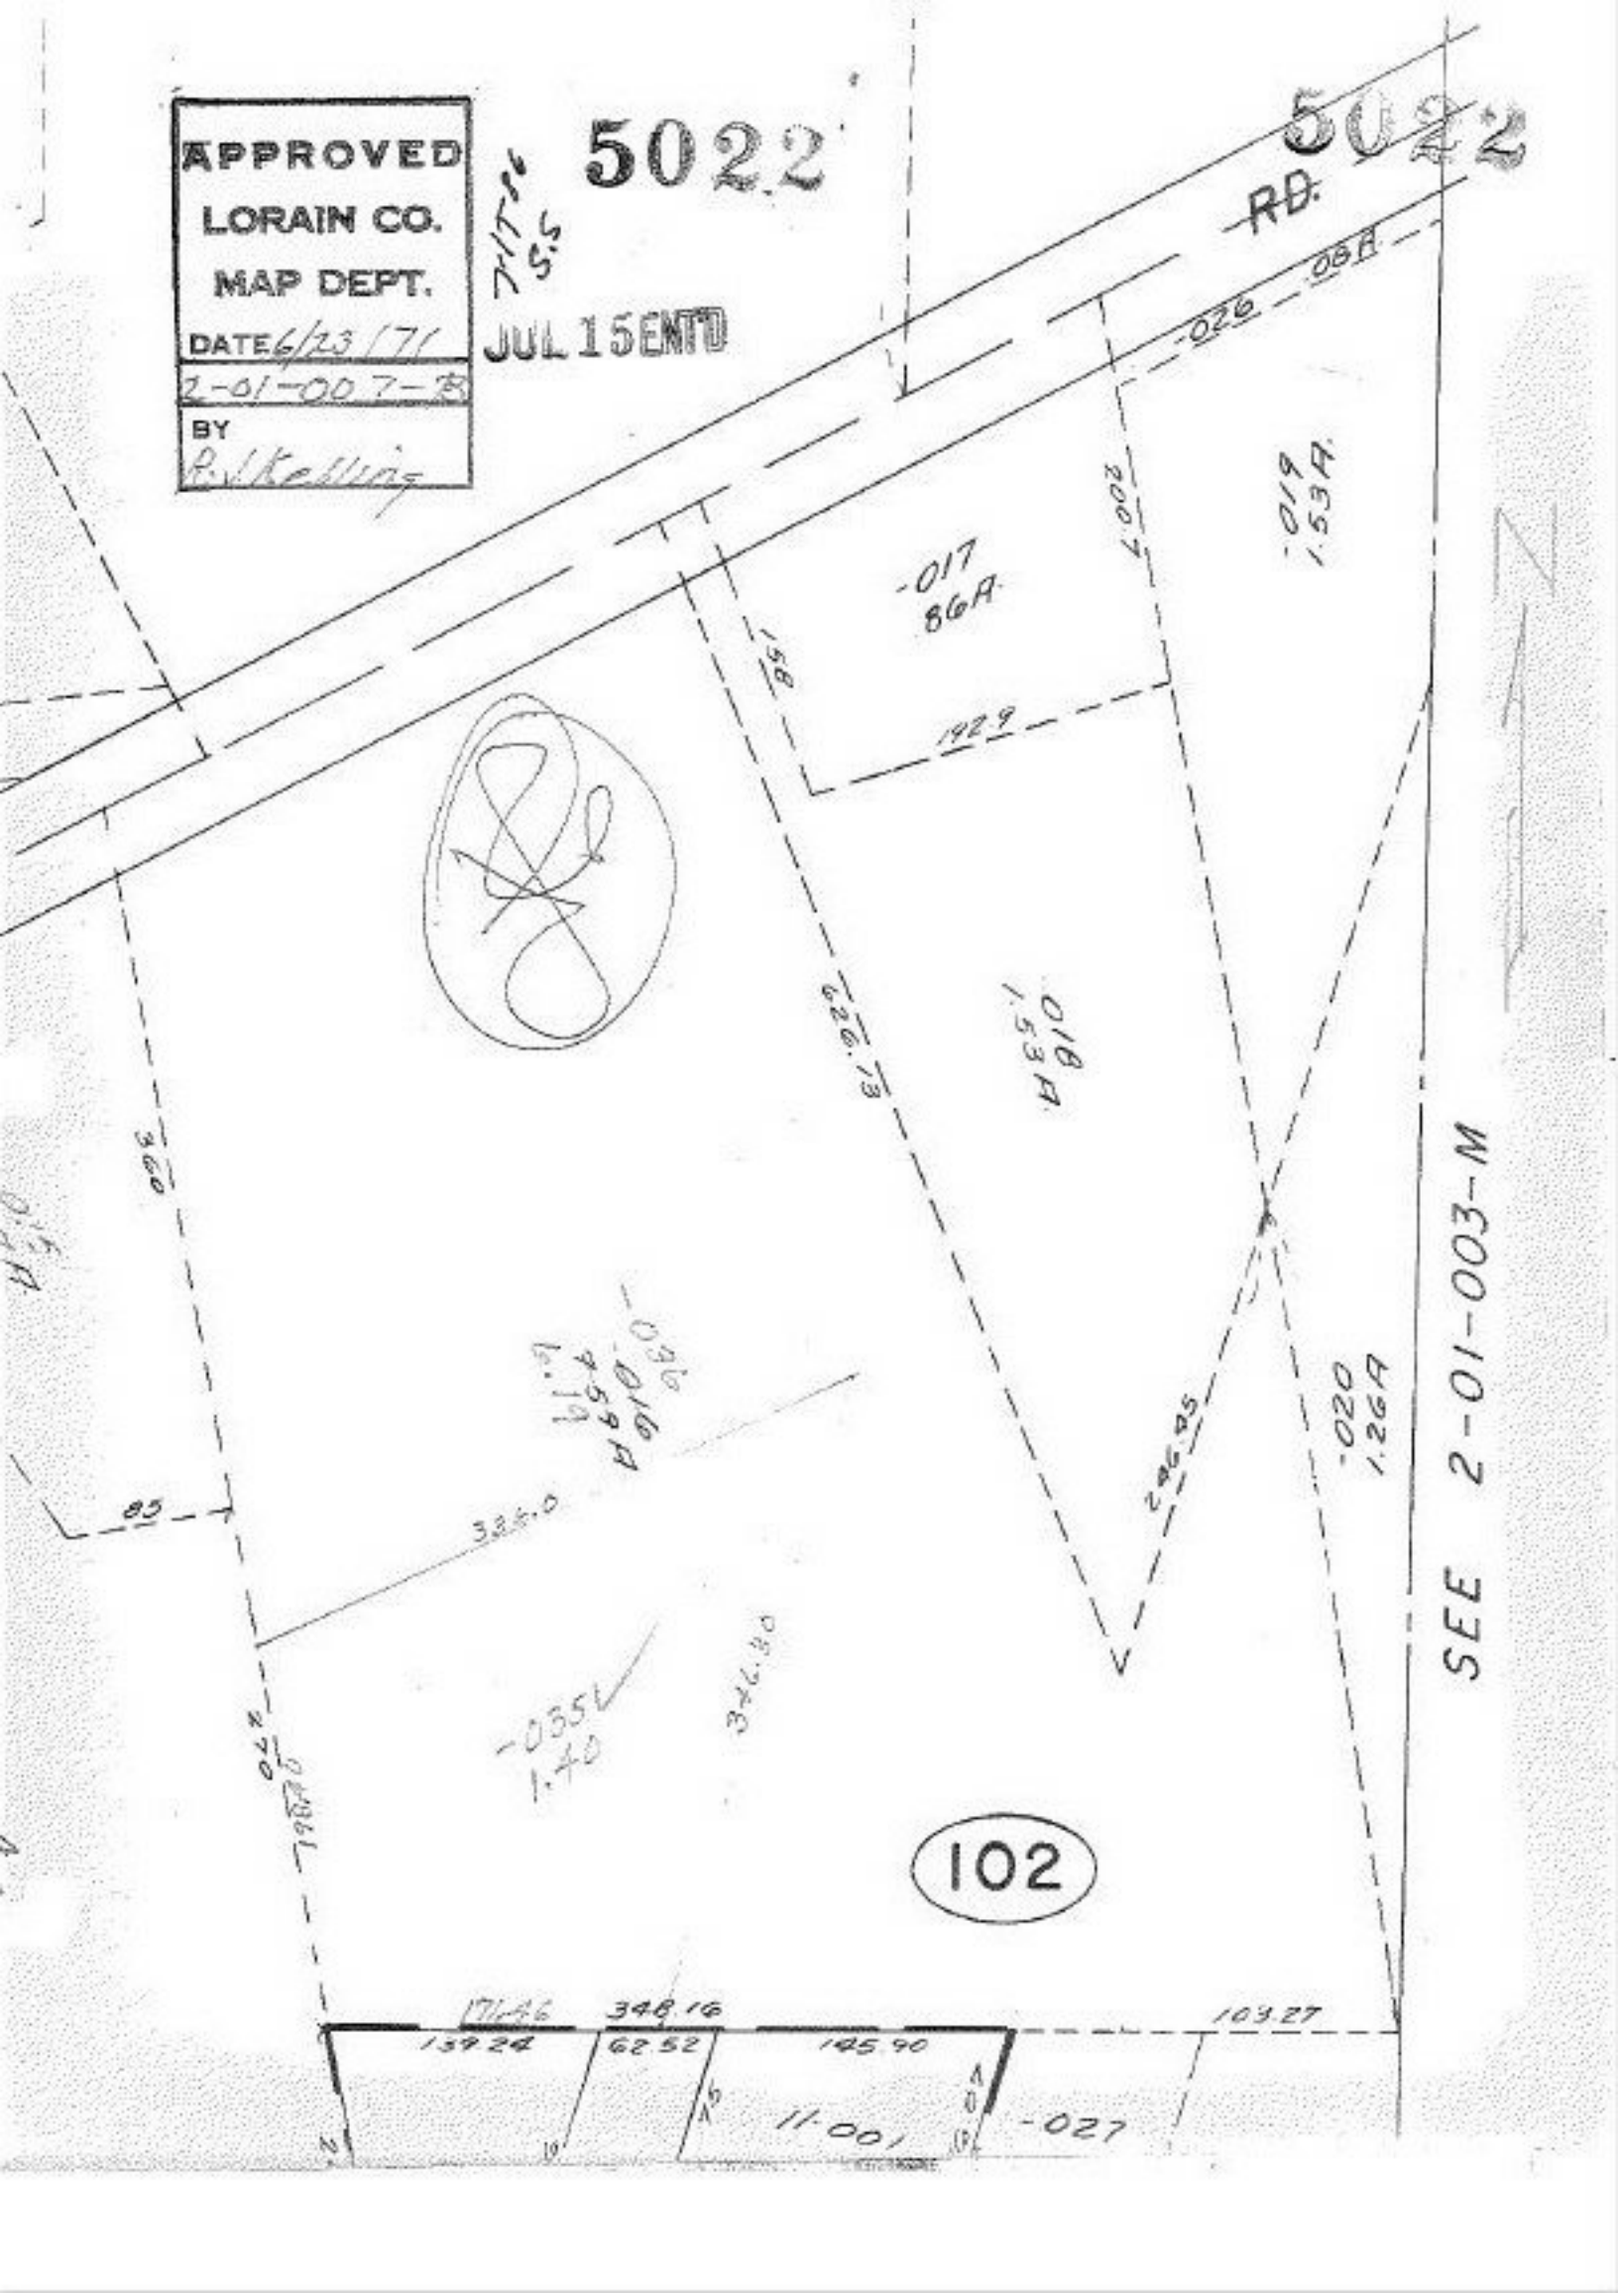
APPROVED
LORAIN CO.
MAP DEPT.
DATE 6/23/71
2-01-007-B
BY
R.J. Kelling
5022
JUL 15 ENTD
5022
RD.
-026
.08A
-017
86A
-019
1.53A
200.7
158
192.9
626.73
.018
1.53A
360
-036
.016
7.59A
6.19
85
336.0
246.45
-020
1.26A
SEE 2-01-003-M
-035
1.40
346.30
102
171.46
348.16
103.27
139.24
62.52
145.90
11-001
-027