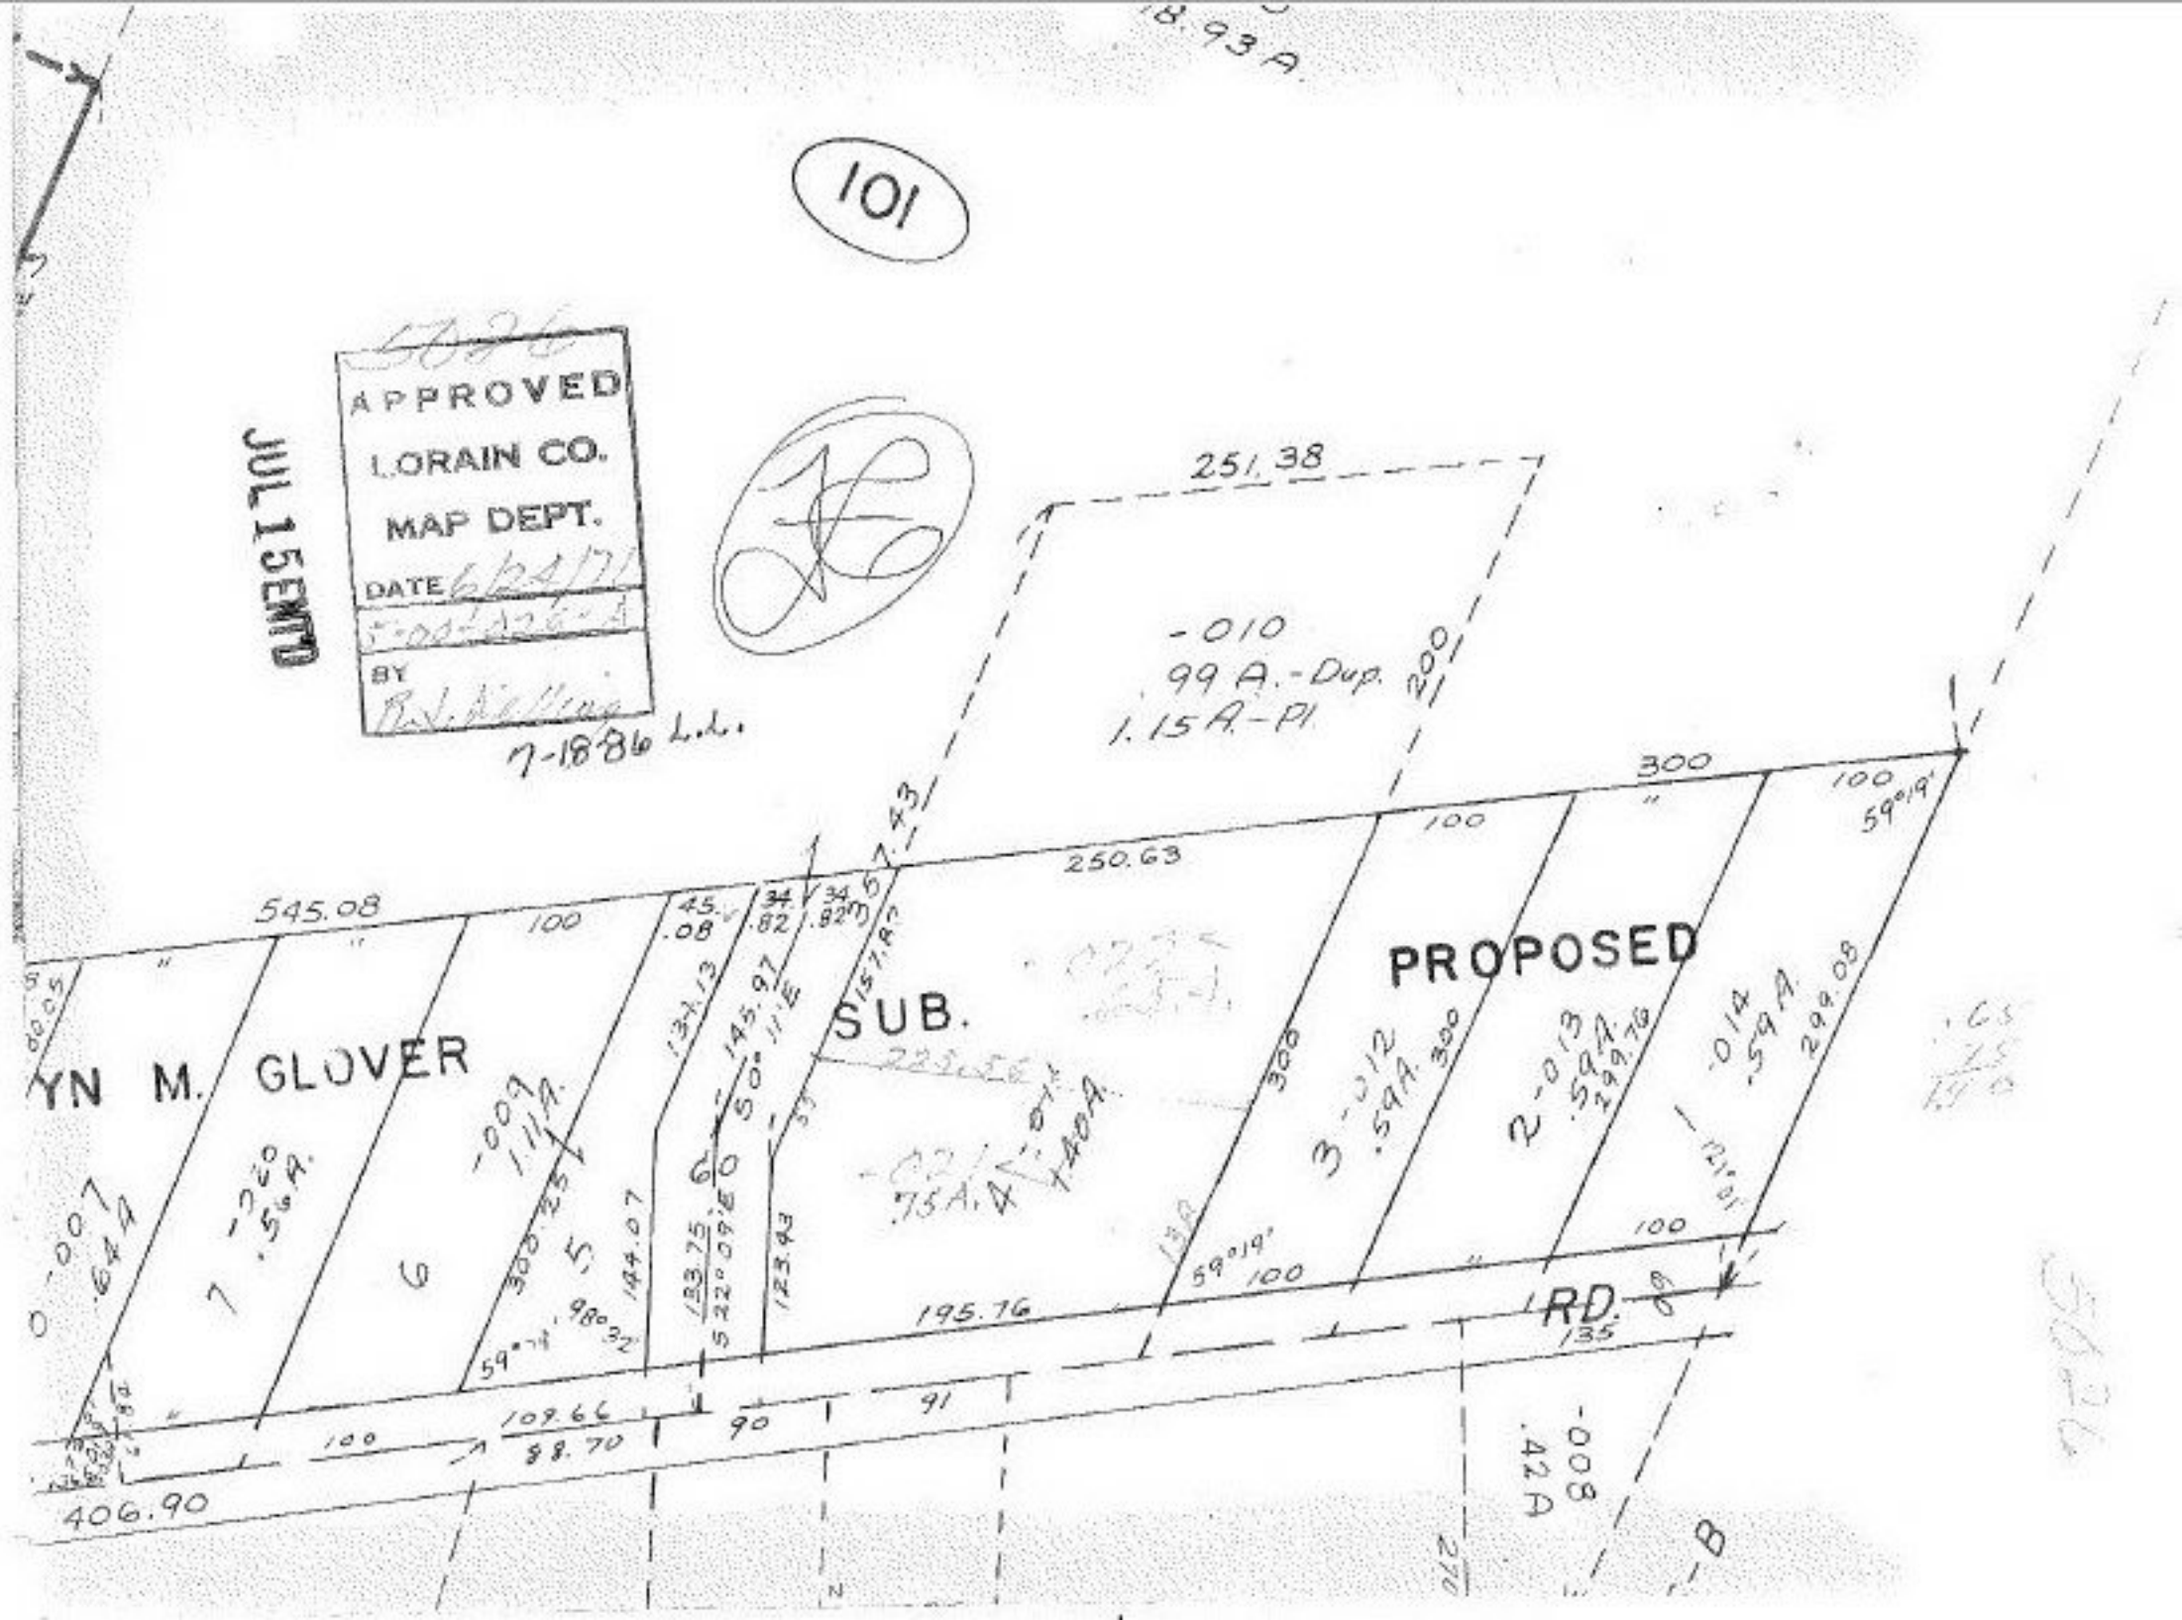
101
APPROVED
LORAIN CO.
MAP DEPT.
DATE 6/24/71
BY
JUL 15 1971
7-1886 L.L.
251.38
-010
99 A.-Dup.
1.15 A.-Pl.
200
300
100
59°19'
250.63
545.08
100
45.08
34.82
34.82
35.43
151.1
SUB.
PROPOSED
YN M. GLOVER
-007
.64A
7
-020
.56A.
6
-009
1.11A.
5
134.13
145.97
50° 11' E
-021
.75A.
-014
.59A
299.08
3
-012
.59A.
300
2
-013
.59A.
299.76
308.23
144.07
183.75
S 32° 09' E
123.93
59° 19'
100
195.76
RD.
135
59° 19' 98° 32'
109.66
88.70
90
91
100
406.90
-008
.42A
270
B