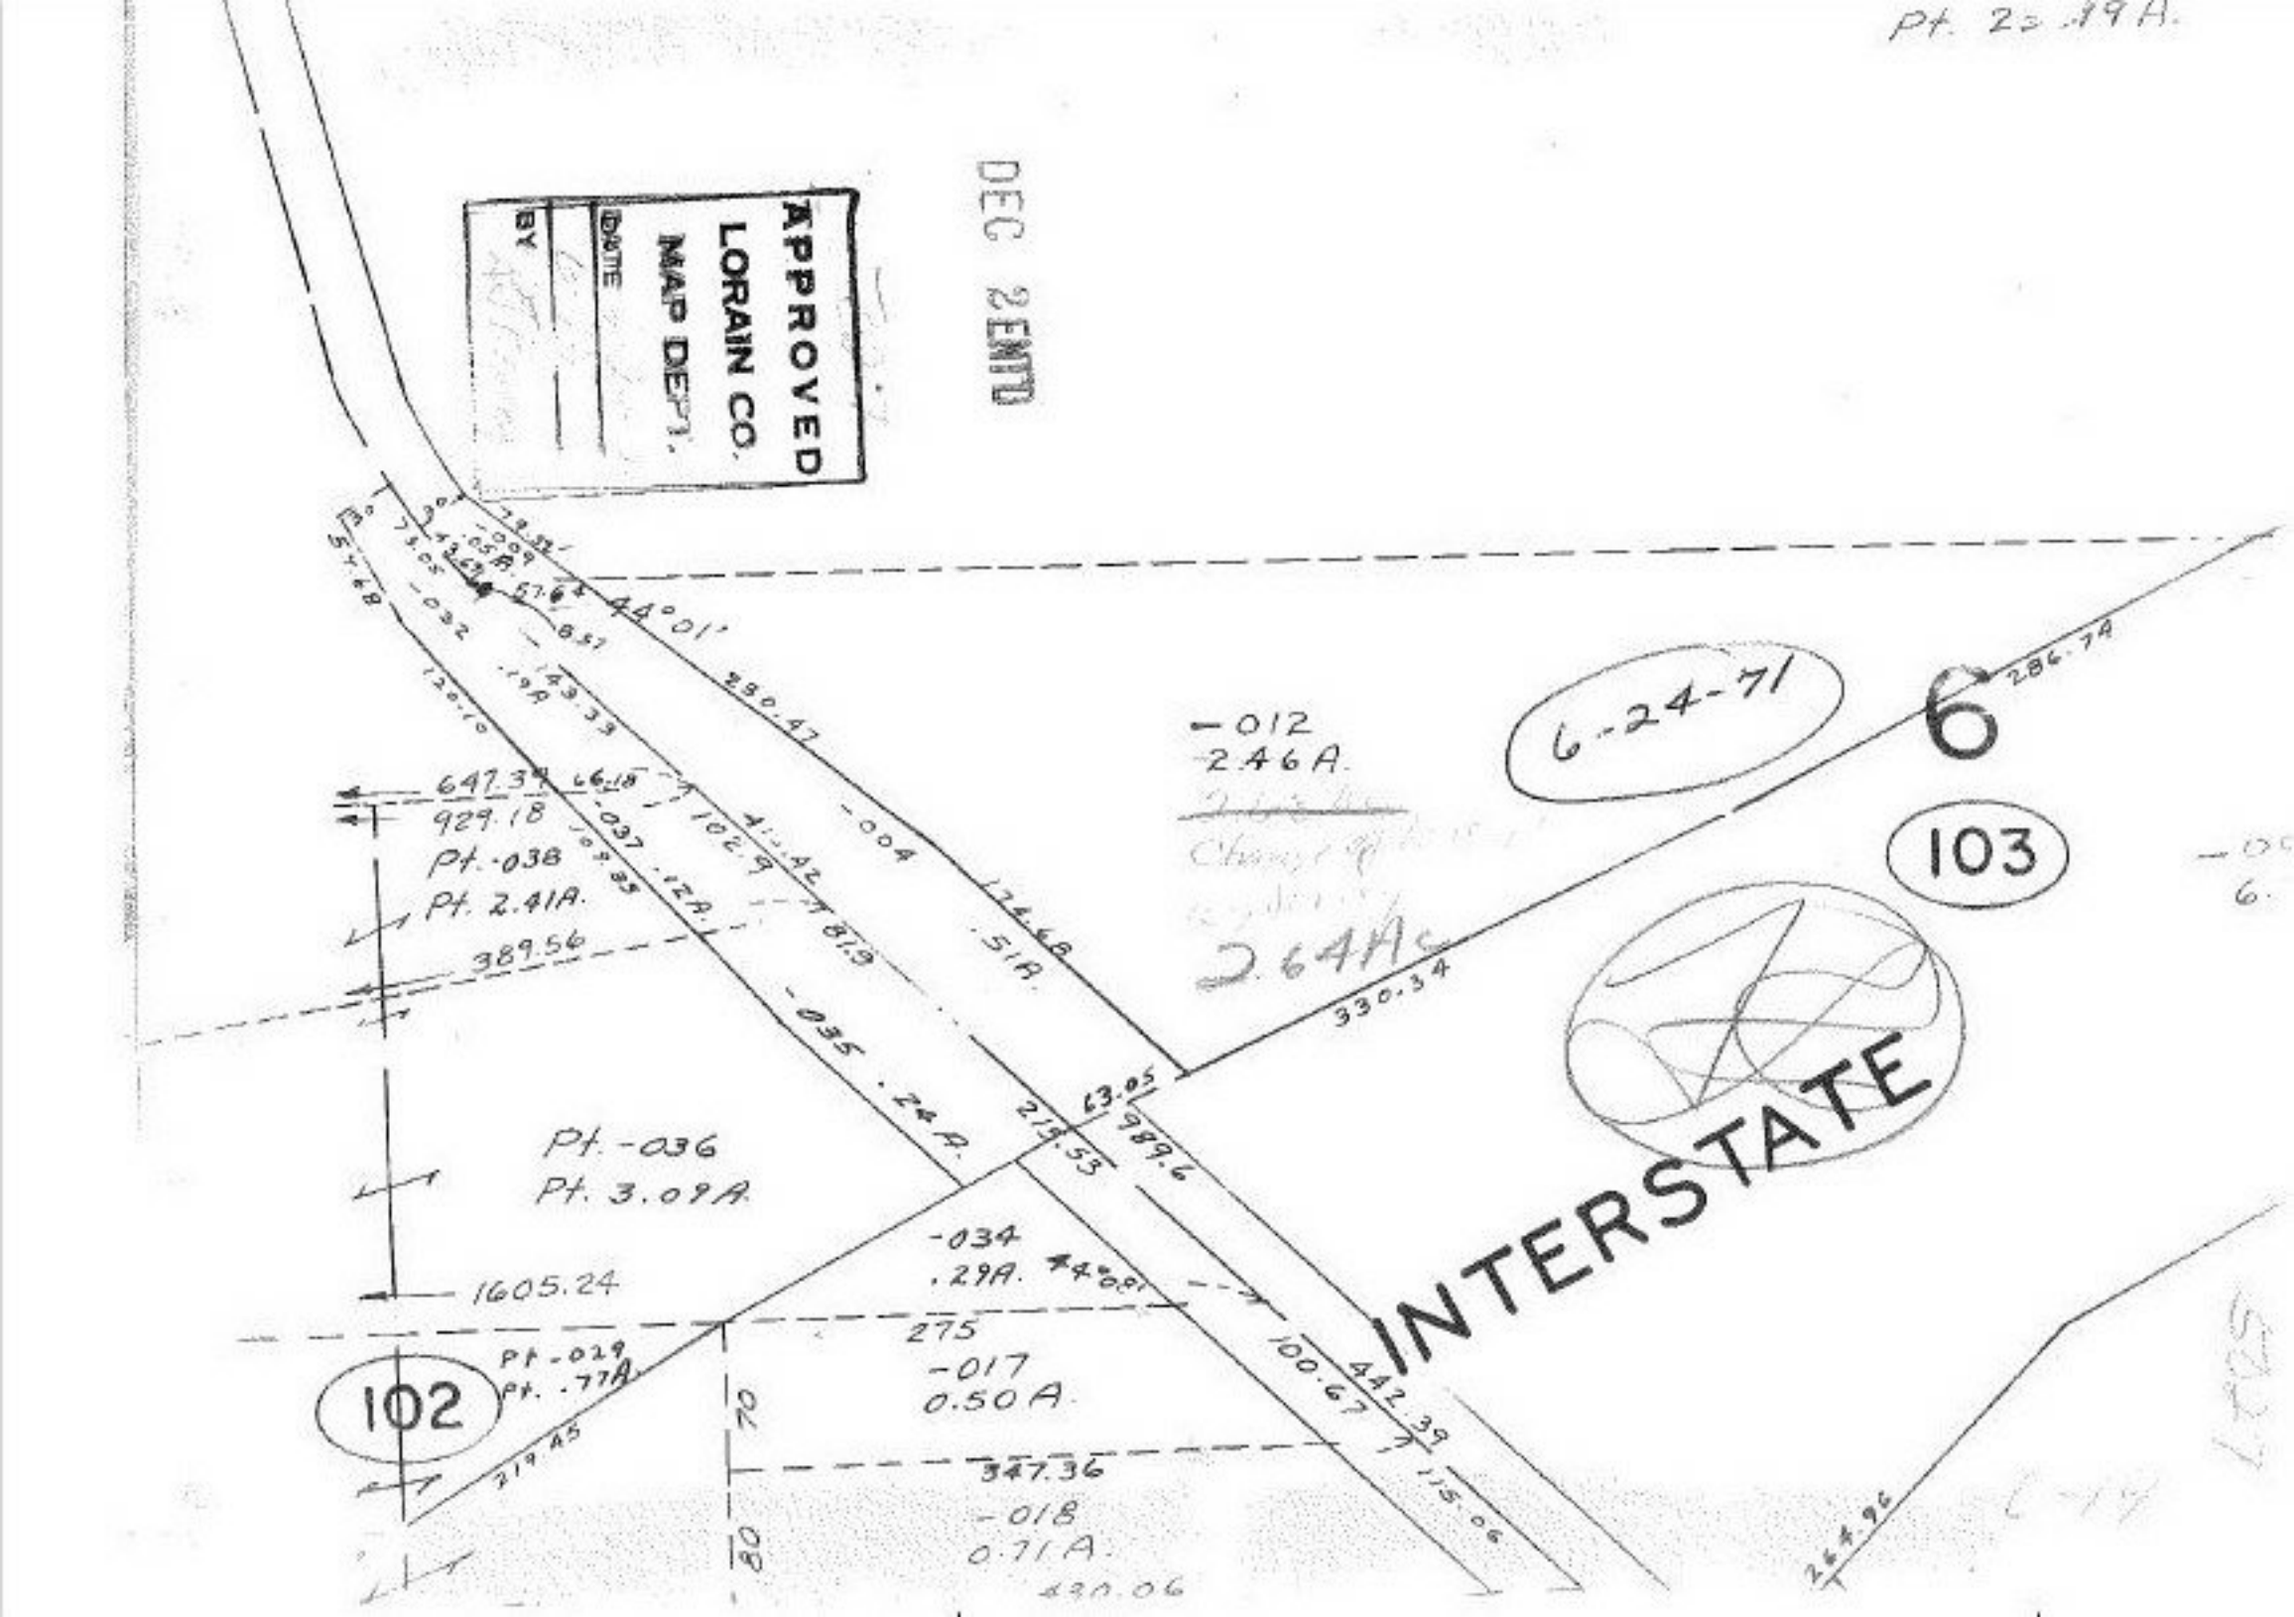
Pt. 2= .19A.
APPROVED
LORAIN CO.
MAP DEPT.
DATE
BY
DEC 2 EMTD
6-24-71
6
103
102
INTERSTATE
-012
2.46A.
2.64As
-004
.51A.
-035
.24A.
-036
Pt. 3.09A.
-034
.29A.
-017
0.50A.
-018
0.71A.
Pt. -038
Pt. 2.41A.
Pt. -029
Pt. .77A.
330.47
330.34
286.74
647.39
929.18
389.56
1605.24
219.45
347.36
275
442.39
264.96
120.10
102.9
81.9
219.53
989.6
100.67
115.06
43.39
43.05
44°01'