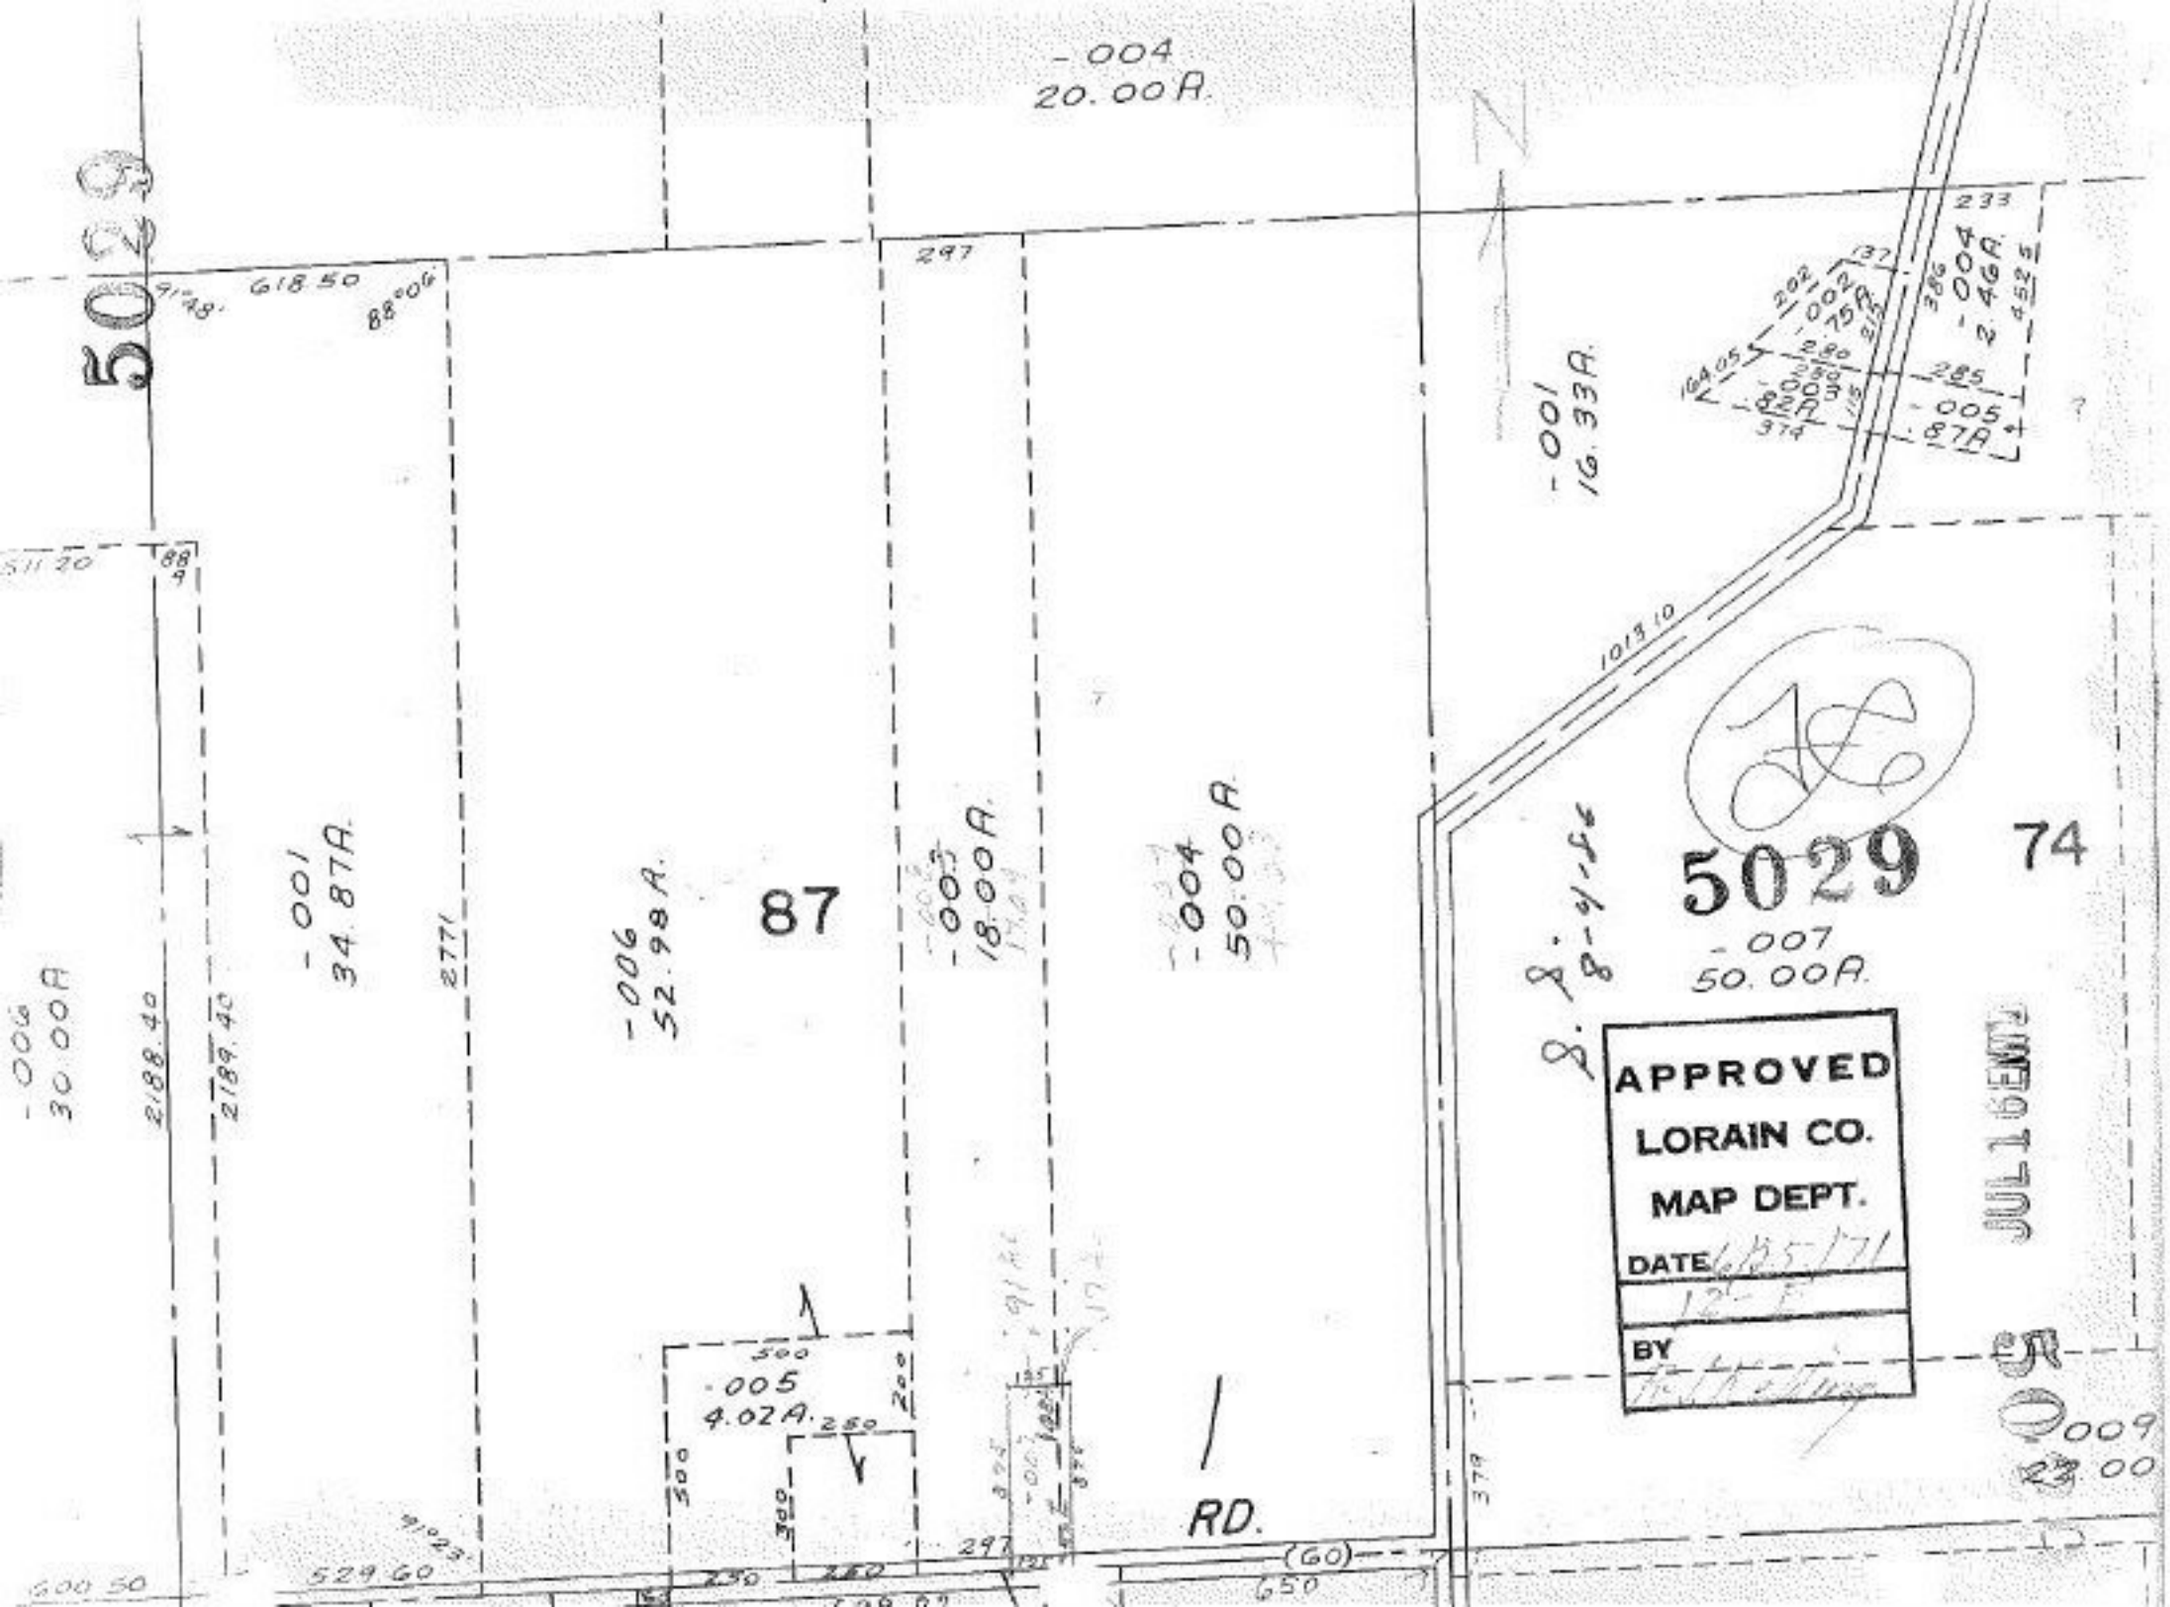

5029
-004
20.00A.
N
618.50
88°06'
297
233
-004
2.46A.
-001
16.33A.
-002
.75A.
-003
.82A.
-005
.87A.
1013.10
-001
34.87A.
-006
52.98A.
87
-003
18.00A.
-004
50.00A.
5029
74
-007
50.00A.
-006
30.00A.
2188.40
2189.40
2771
APPROVED
LORAIN CO.
MAP DEPT.
DATE
BY
JUL 16 EMT
-005
4.02A.
RD.
(60)
529.60
600.50
650
-009
23.00