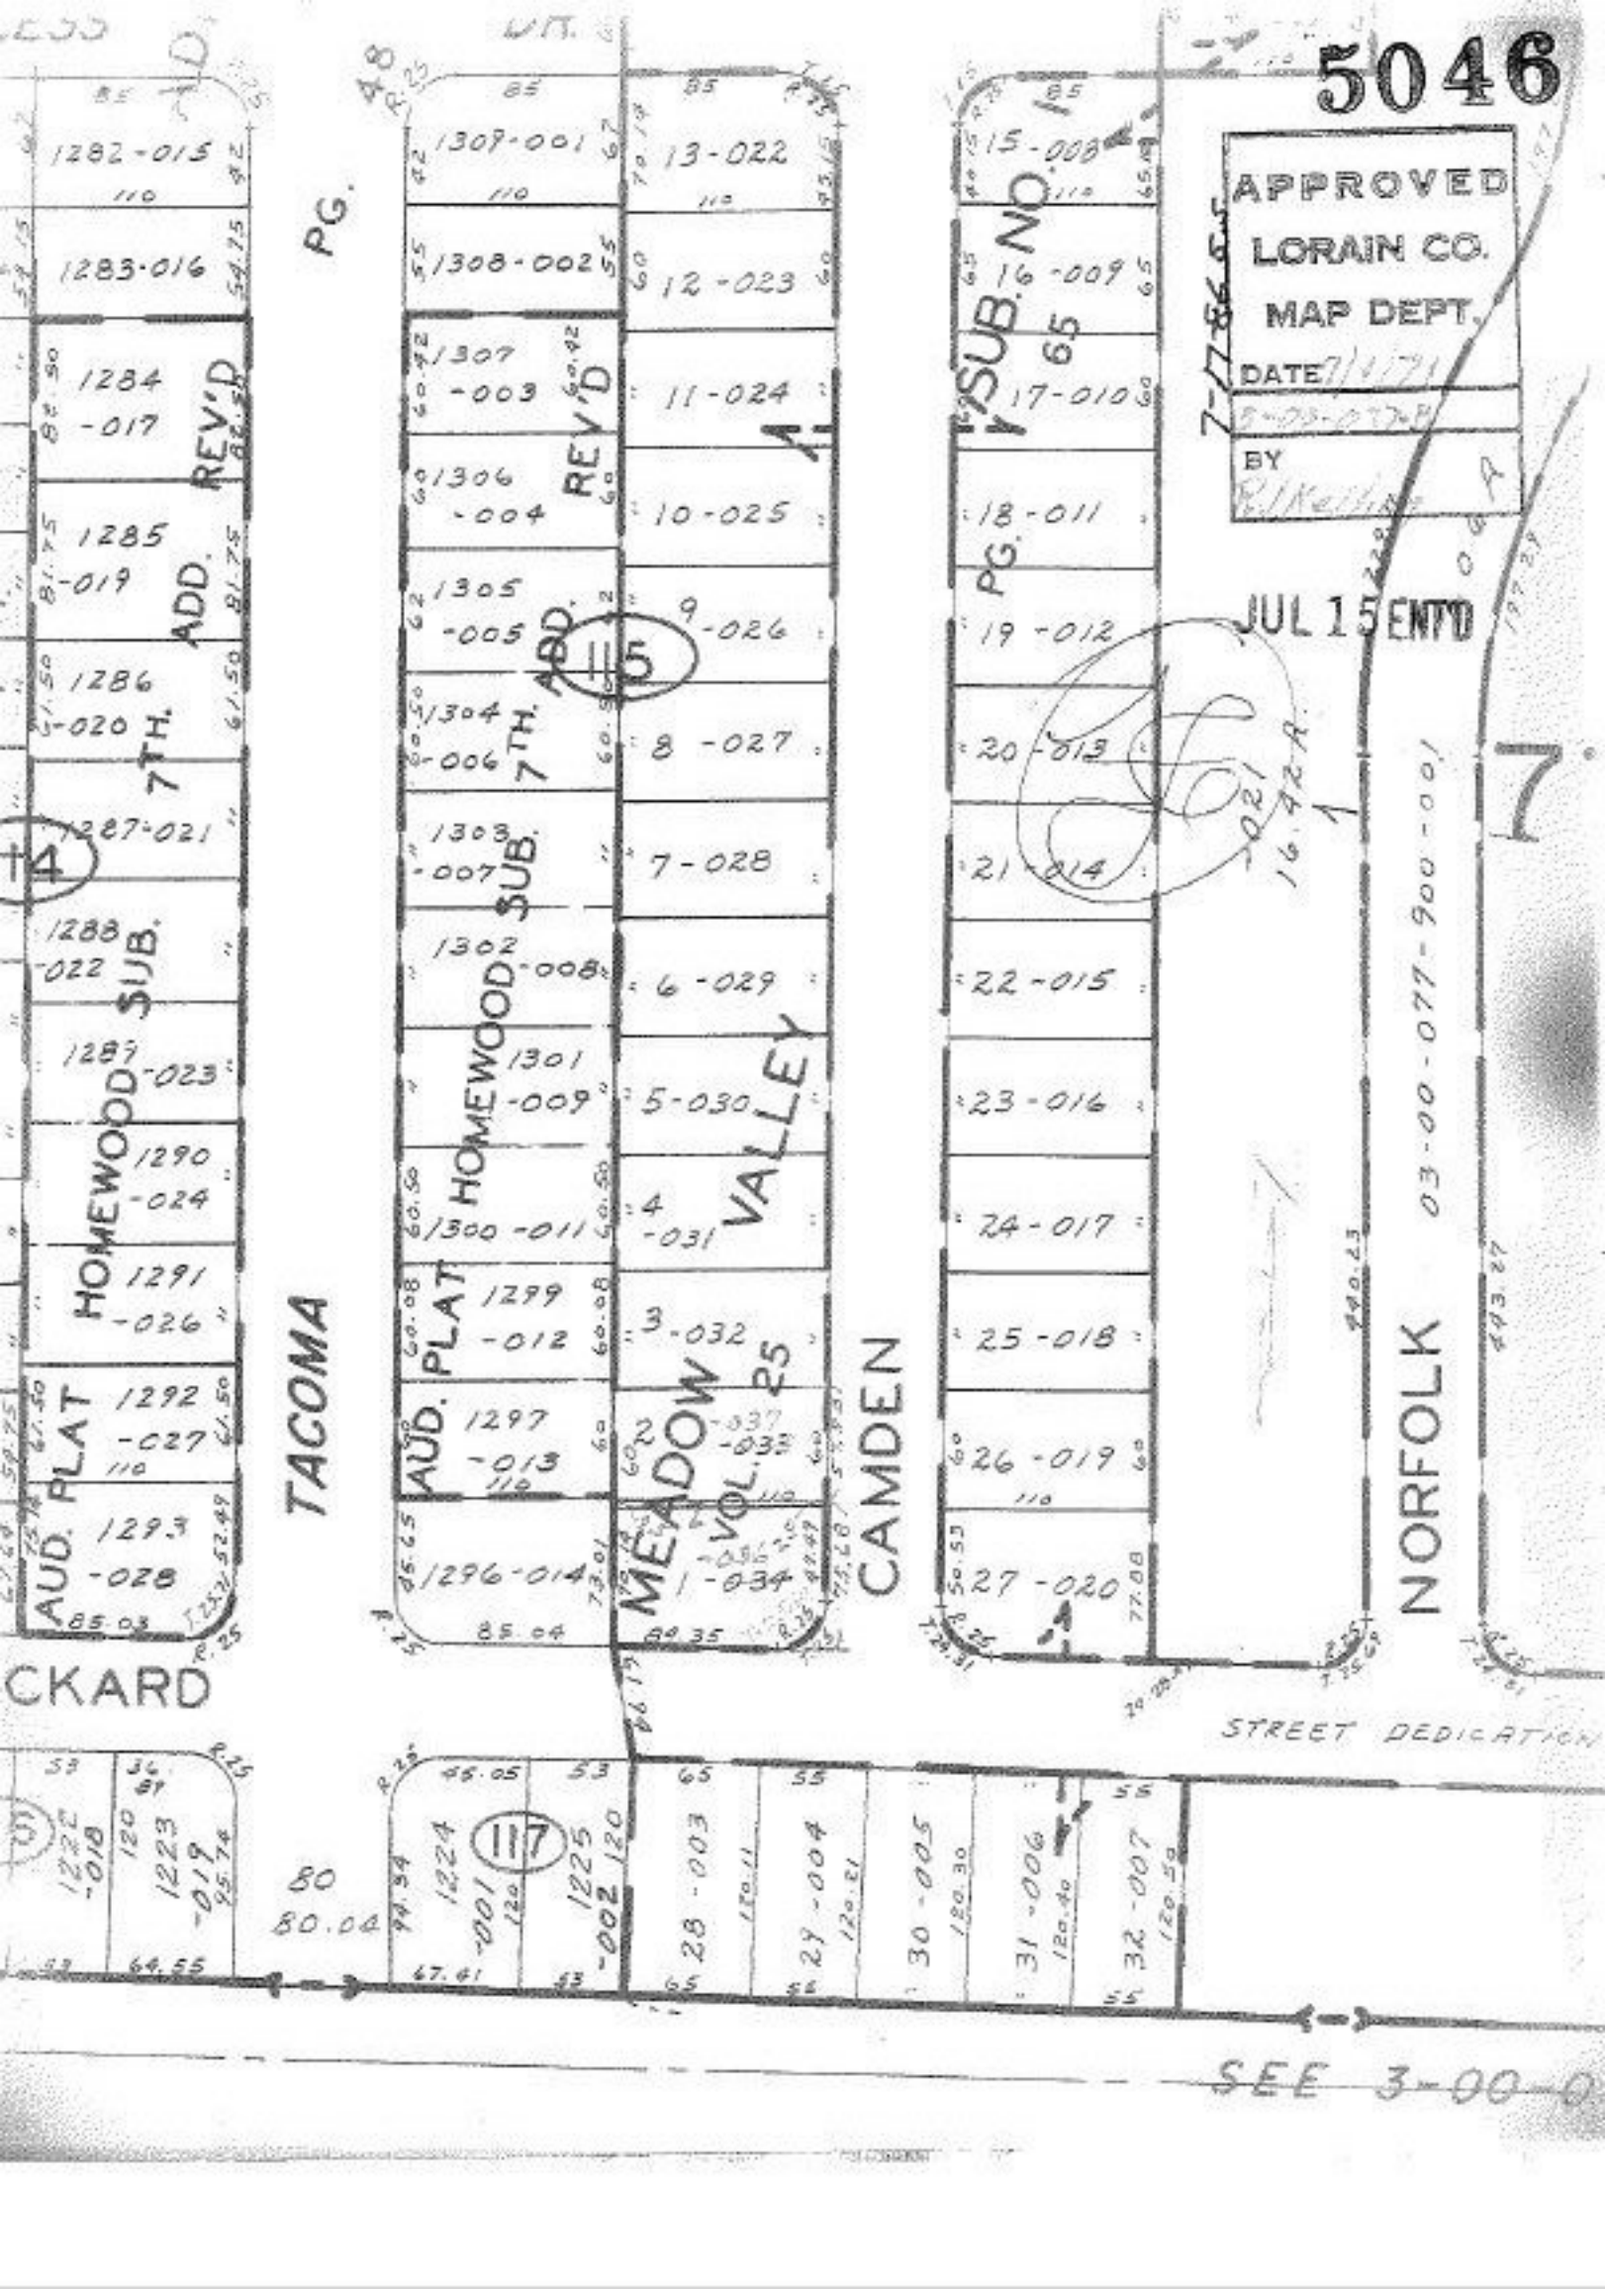
5046
APPROVED
LORAIN CO.
MAP DEPT.
DATE
BY
JUL 15 ENT'D
TACOMA
CAMDEN
NORFOLK
CKARD
HOMEWOOD SUB. 7TH. ADD. REV'D
AUD. PLAT
MEADOW VALLEY
VOL. 25
PG. 48
PG. 65
SUB. NO. 1
03-00-077-900-001
STREET DEDICATION
SEE 3-00-0