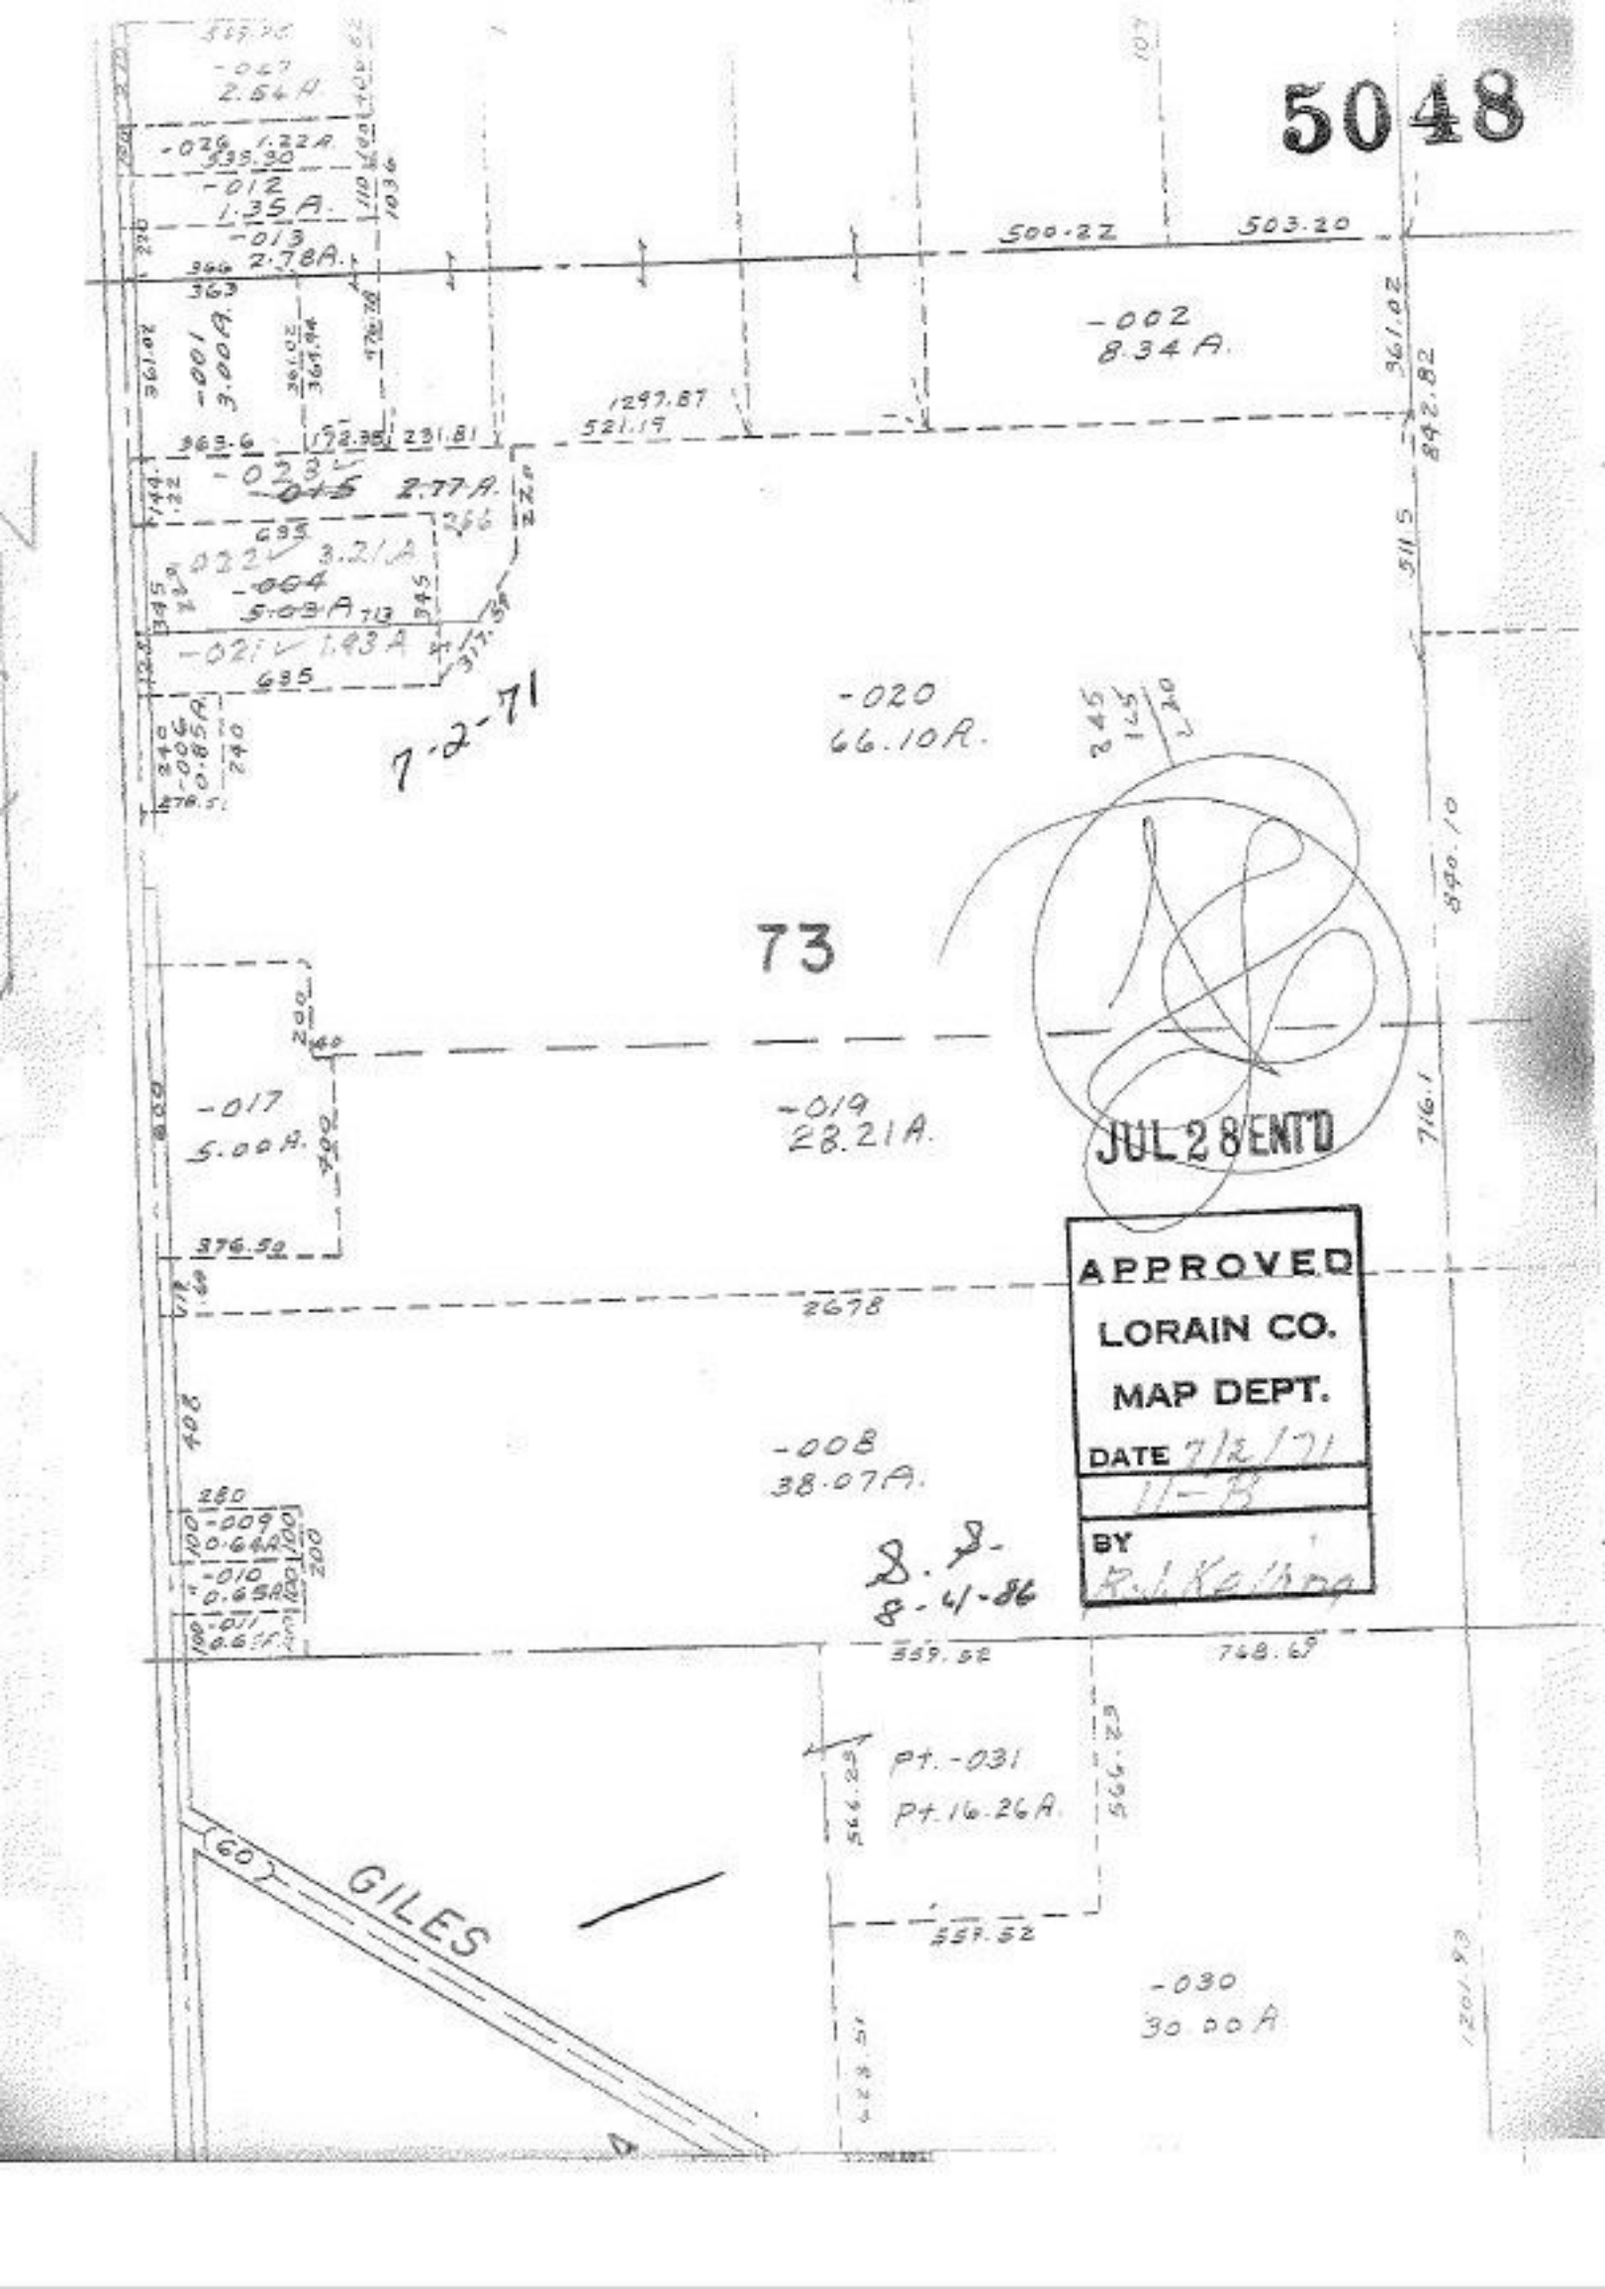
5048
-002
8.34 A.
-001
3.00A.
-003
2.77A.
-004
5.08A
-017
5.00A.
-019
28.21A.
-020
66.10A.
-008
38.07A.
-030
30.00A
Pt.-031
Pt.16.26A.
73
7-2-71
JUL 28 ENT'D
APPROVED
LORAIN CO.
MAP DEPT.
DATE 7/2/71
11-B
BY
8-4-86
GILES
60'
500.22
503.20
1297.87
521.19
842.82
716.1
540.10
559.52
768.69
566.29
1201.93