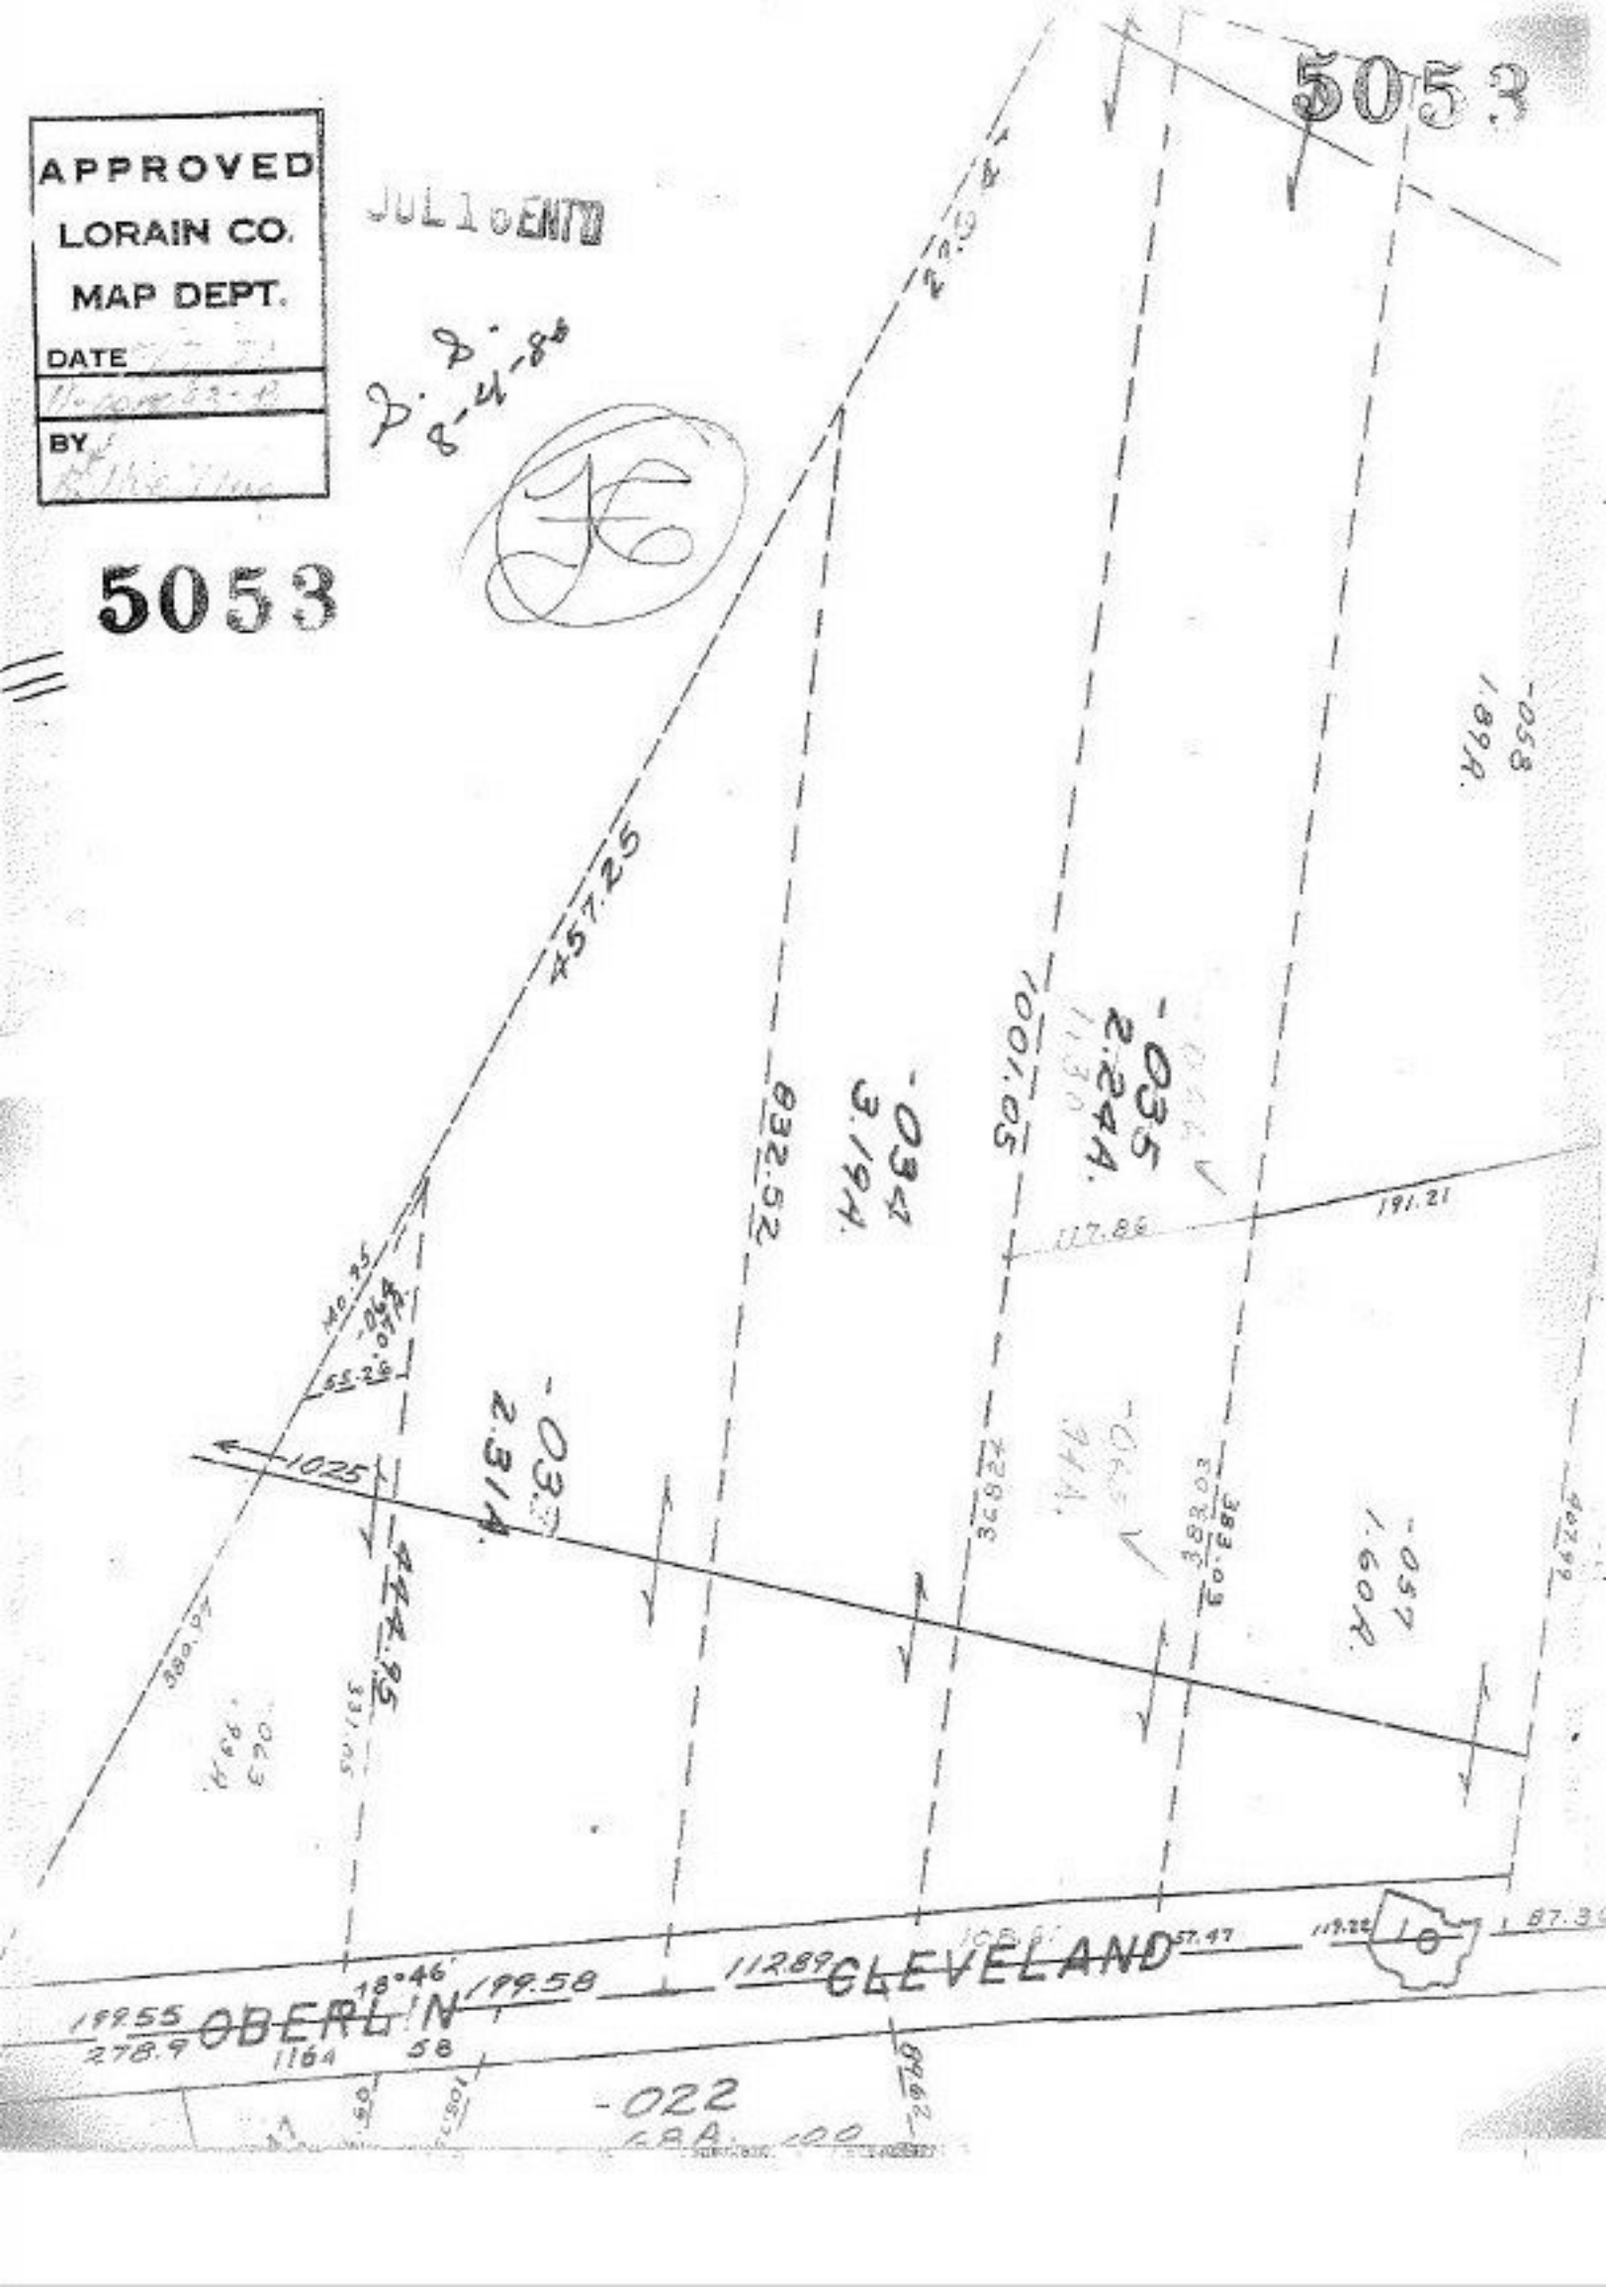
APPROVED
LORAIN CO.
MAP DEPT.
DATE
BY
JUL 10 ENTD
5053
5053
457.25
3.194
-034
932.52
100.05
2.24A
-035
1025
-033
2.31A
444.85
380.97
191.21
117.86
38.27
383.03
60.38E
1.60A
-057
1.69A
-058
OBERLIN
CLEVELAND
278.9
1164
58
-022
CRA.
-00