

5054

JUL 28 ENT'D

APPROVED
LORAIN CO.
MAP DEPT.

DATE 7/7/71


11-00-081 & 11-00-100B
8.11A.

BY
R. J. Kelling

S. S.
7-23-86



180	-023 .46A.	180	-025 .41A.	180	-027 .41A.	180	-029 .41A.
110		100		100		100.63	

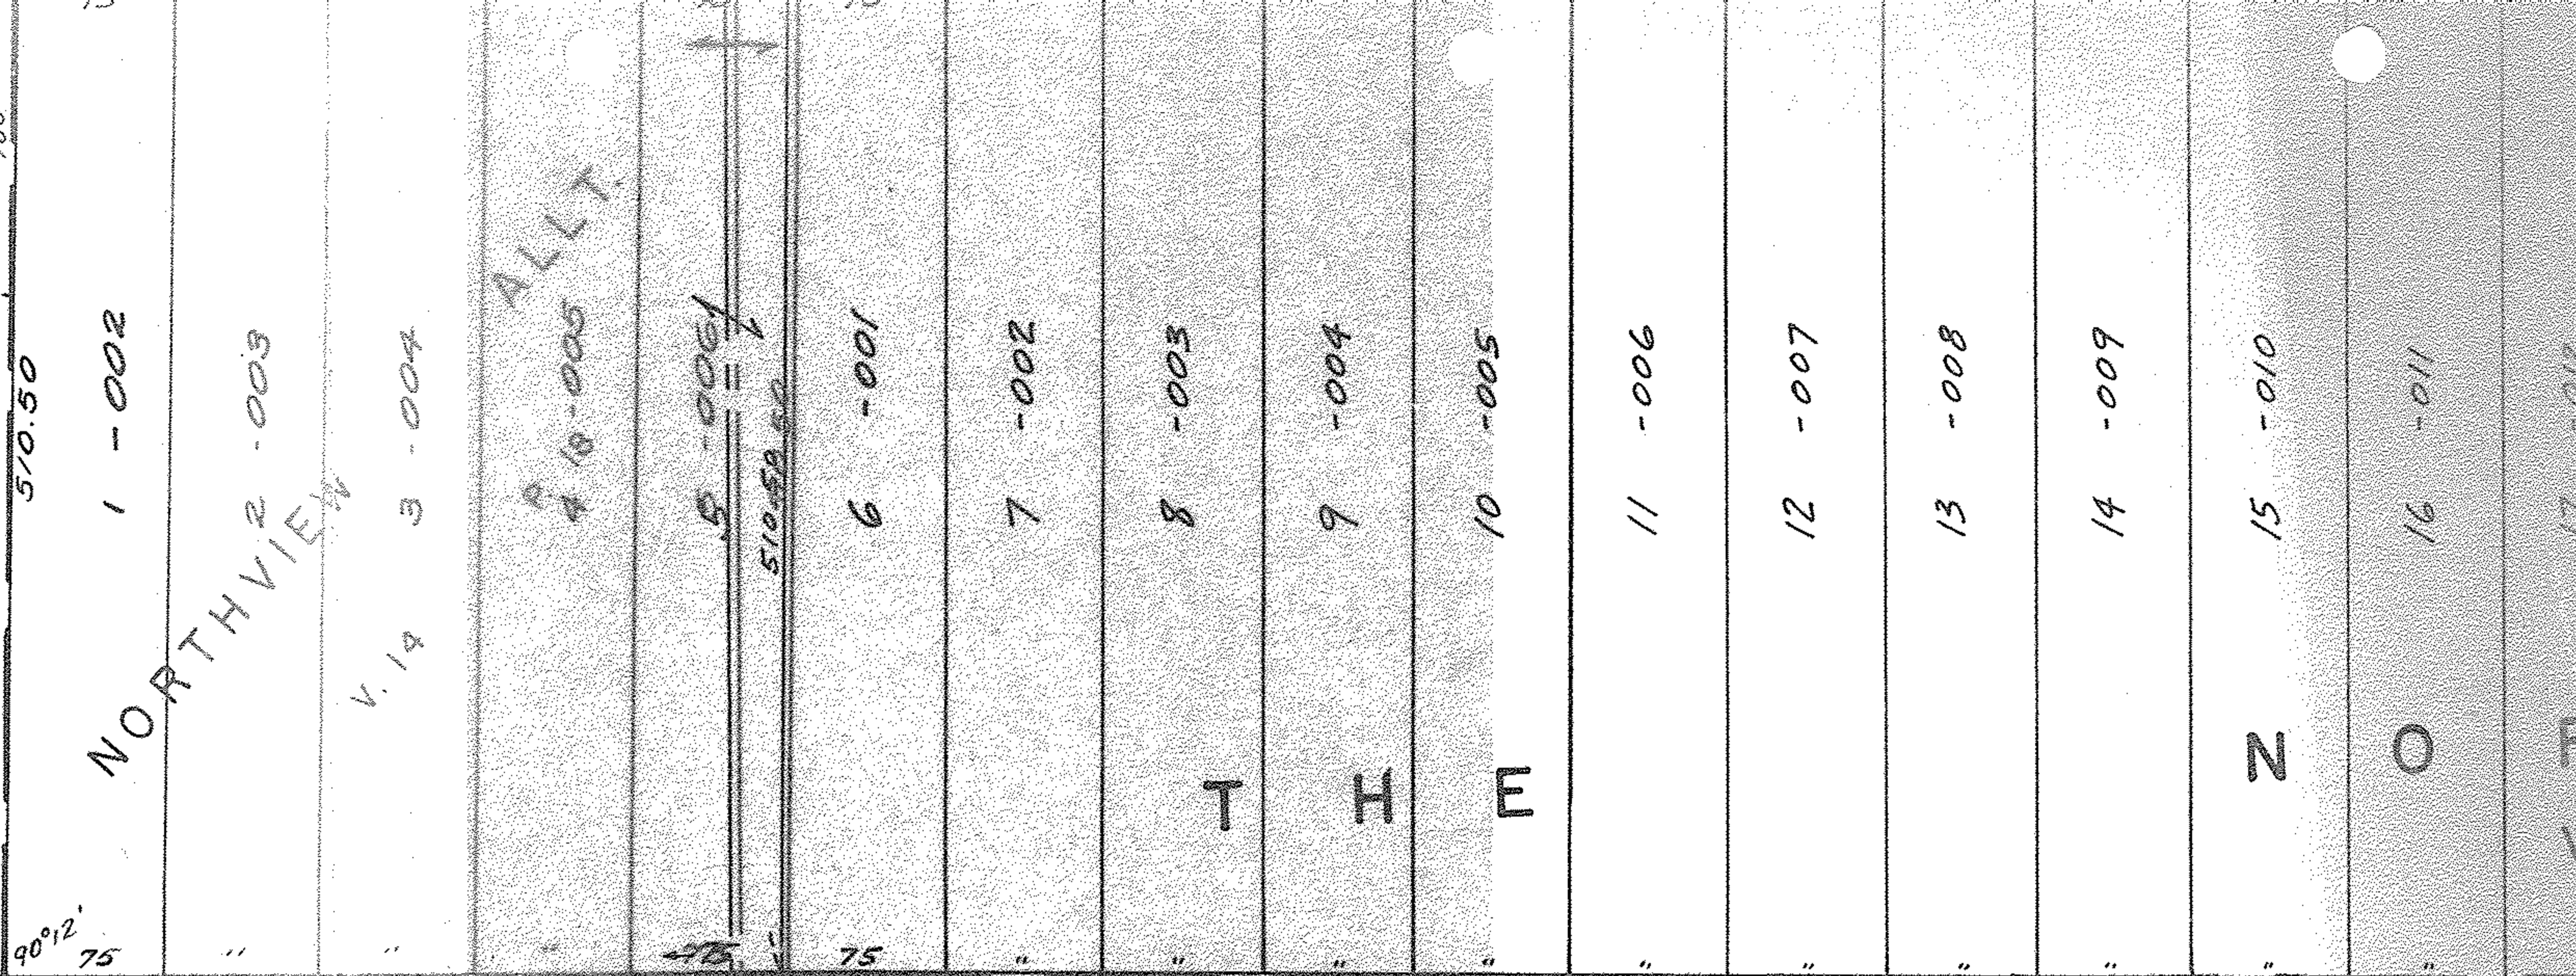

529.59

100°46'

233.76
232.52

-021
5.94 A.

1833.40

1799.03

585.24

~~Total~~
9.58

7-8-71

2559.84 → 2559.84
3375.26 → 3375.26

3334.33 → 3334.33
1792.78 → 1792.78

-051
3.64A.

280

-052
8.13A