

5705

5065

APPROVED
LORAIN CO.
MAP DEPT.
DATE 7/8/71
7-00-018-A
BY Paul Holling

7-18-86
L.H.

-006
6.00 F.

-032
-007
16.00 F.
15.23

233.64
233.64



-033
Calculated by 15
TIA.

217.84
217.84

SEE 7-00-018-C

1745.70
1753.18
Not To Scale

Not To Scale
15 18.94

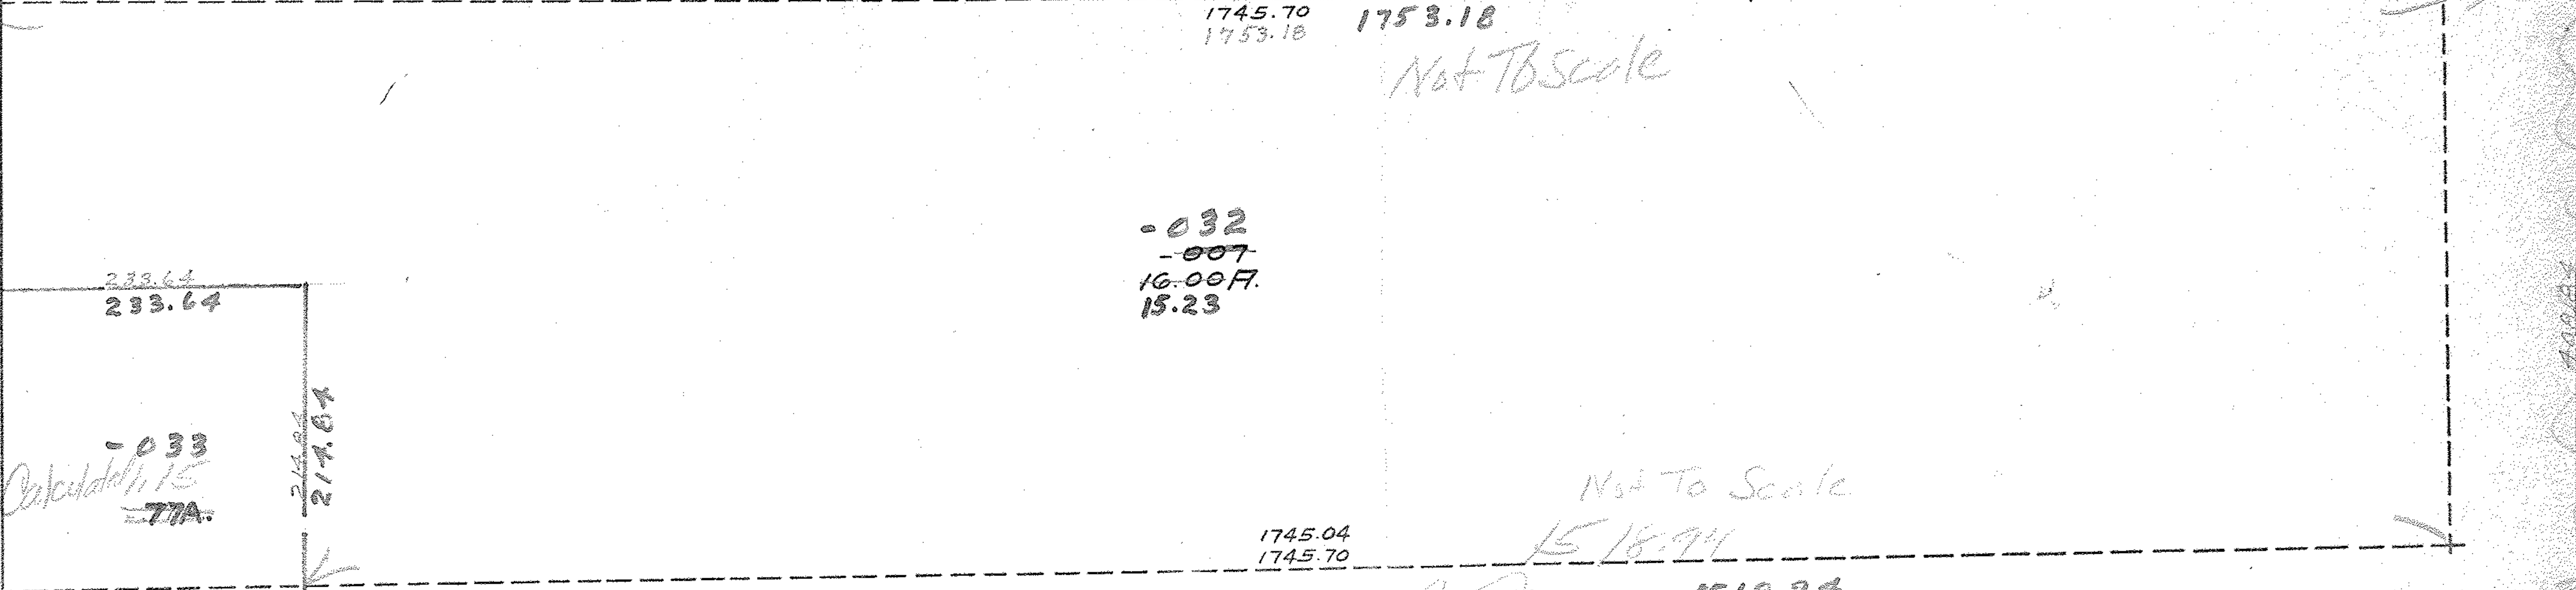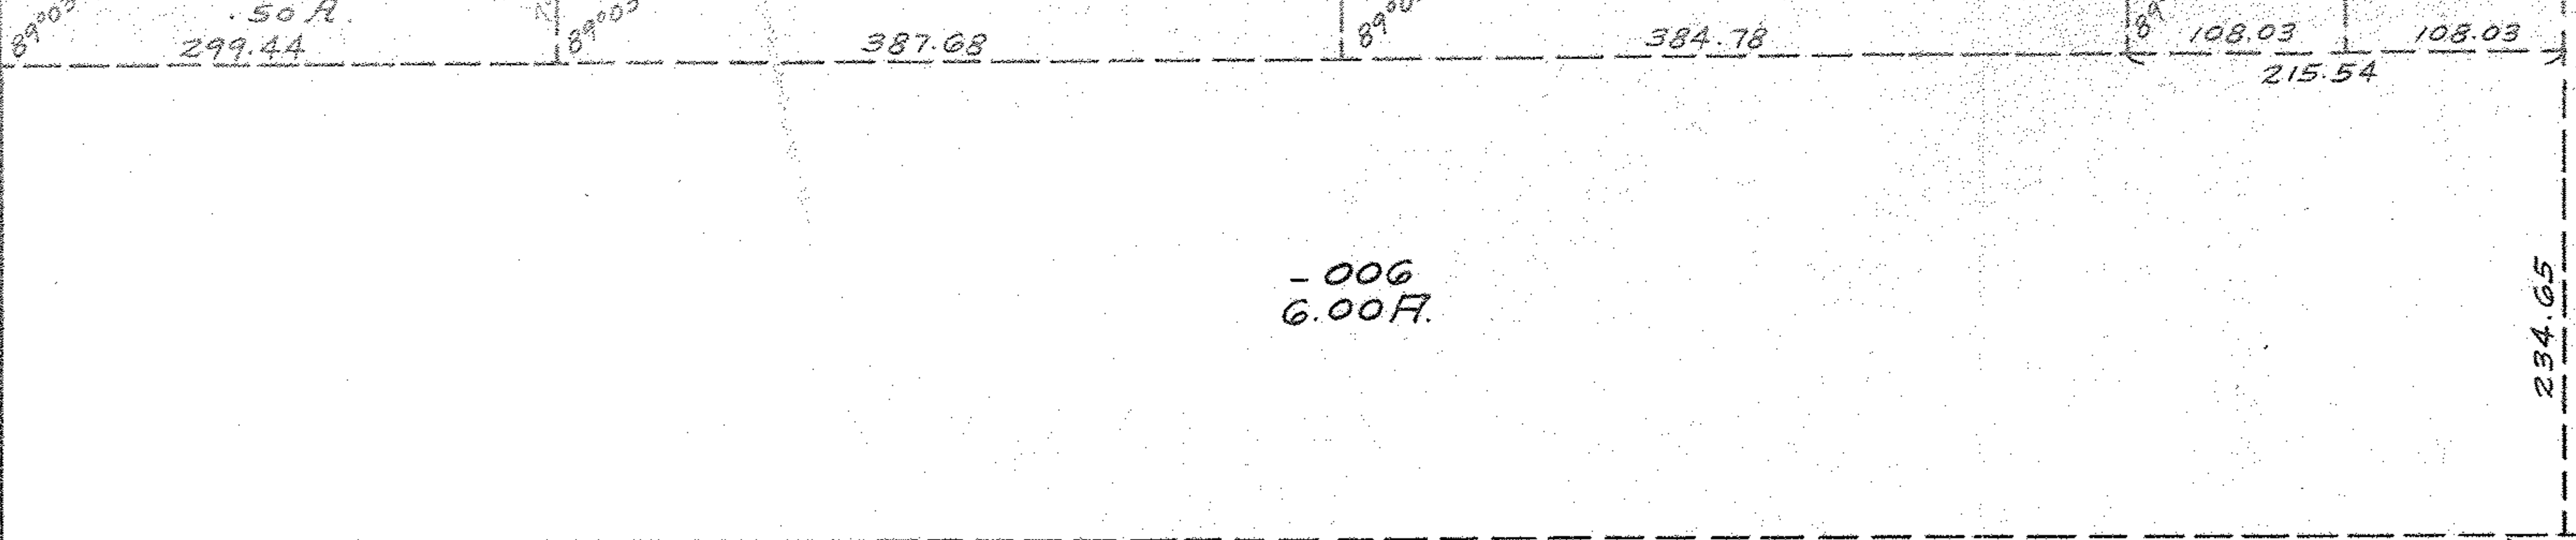

JAYGOX 192.86

JAYGOX 408.84

5065