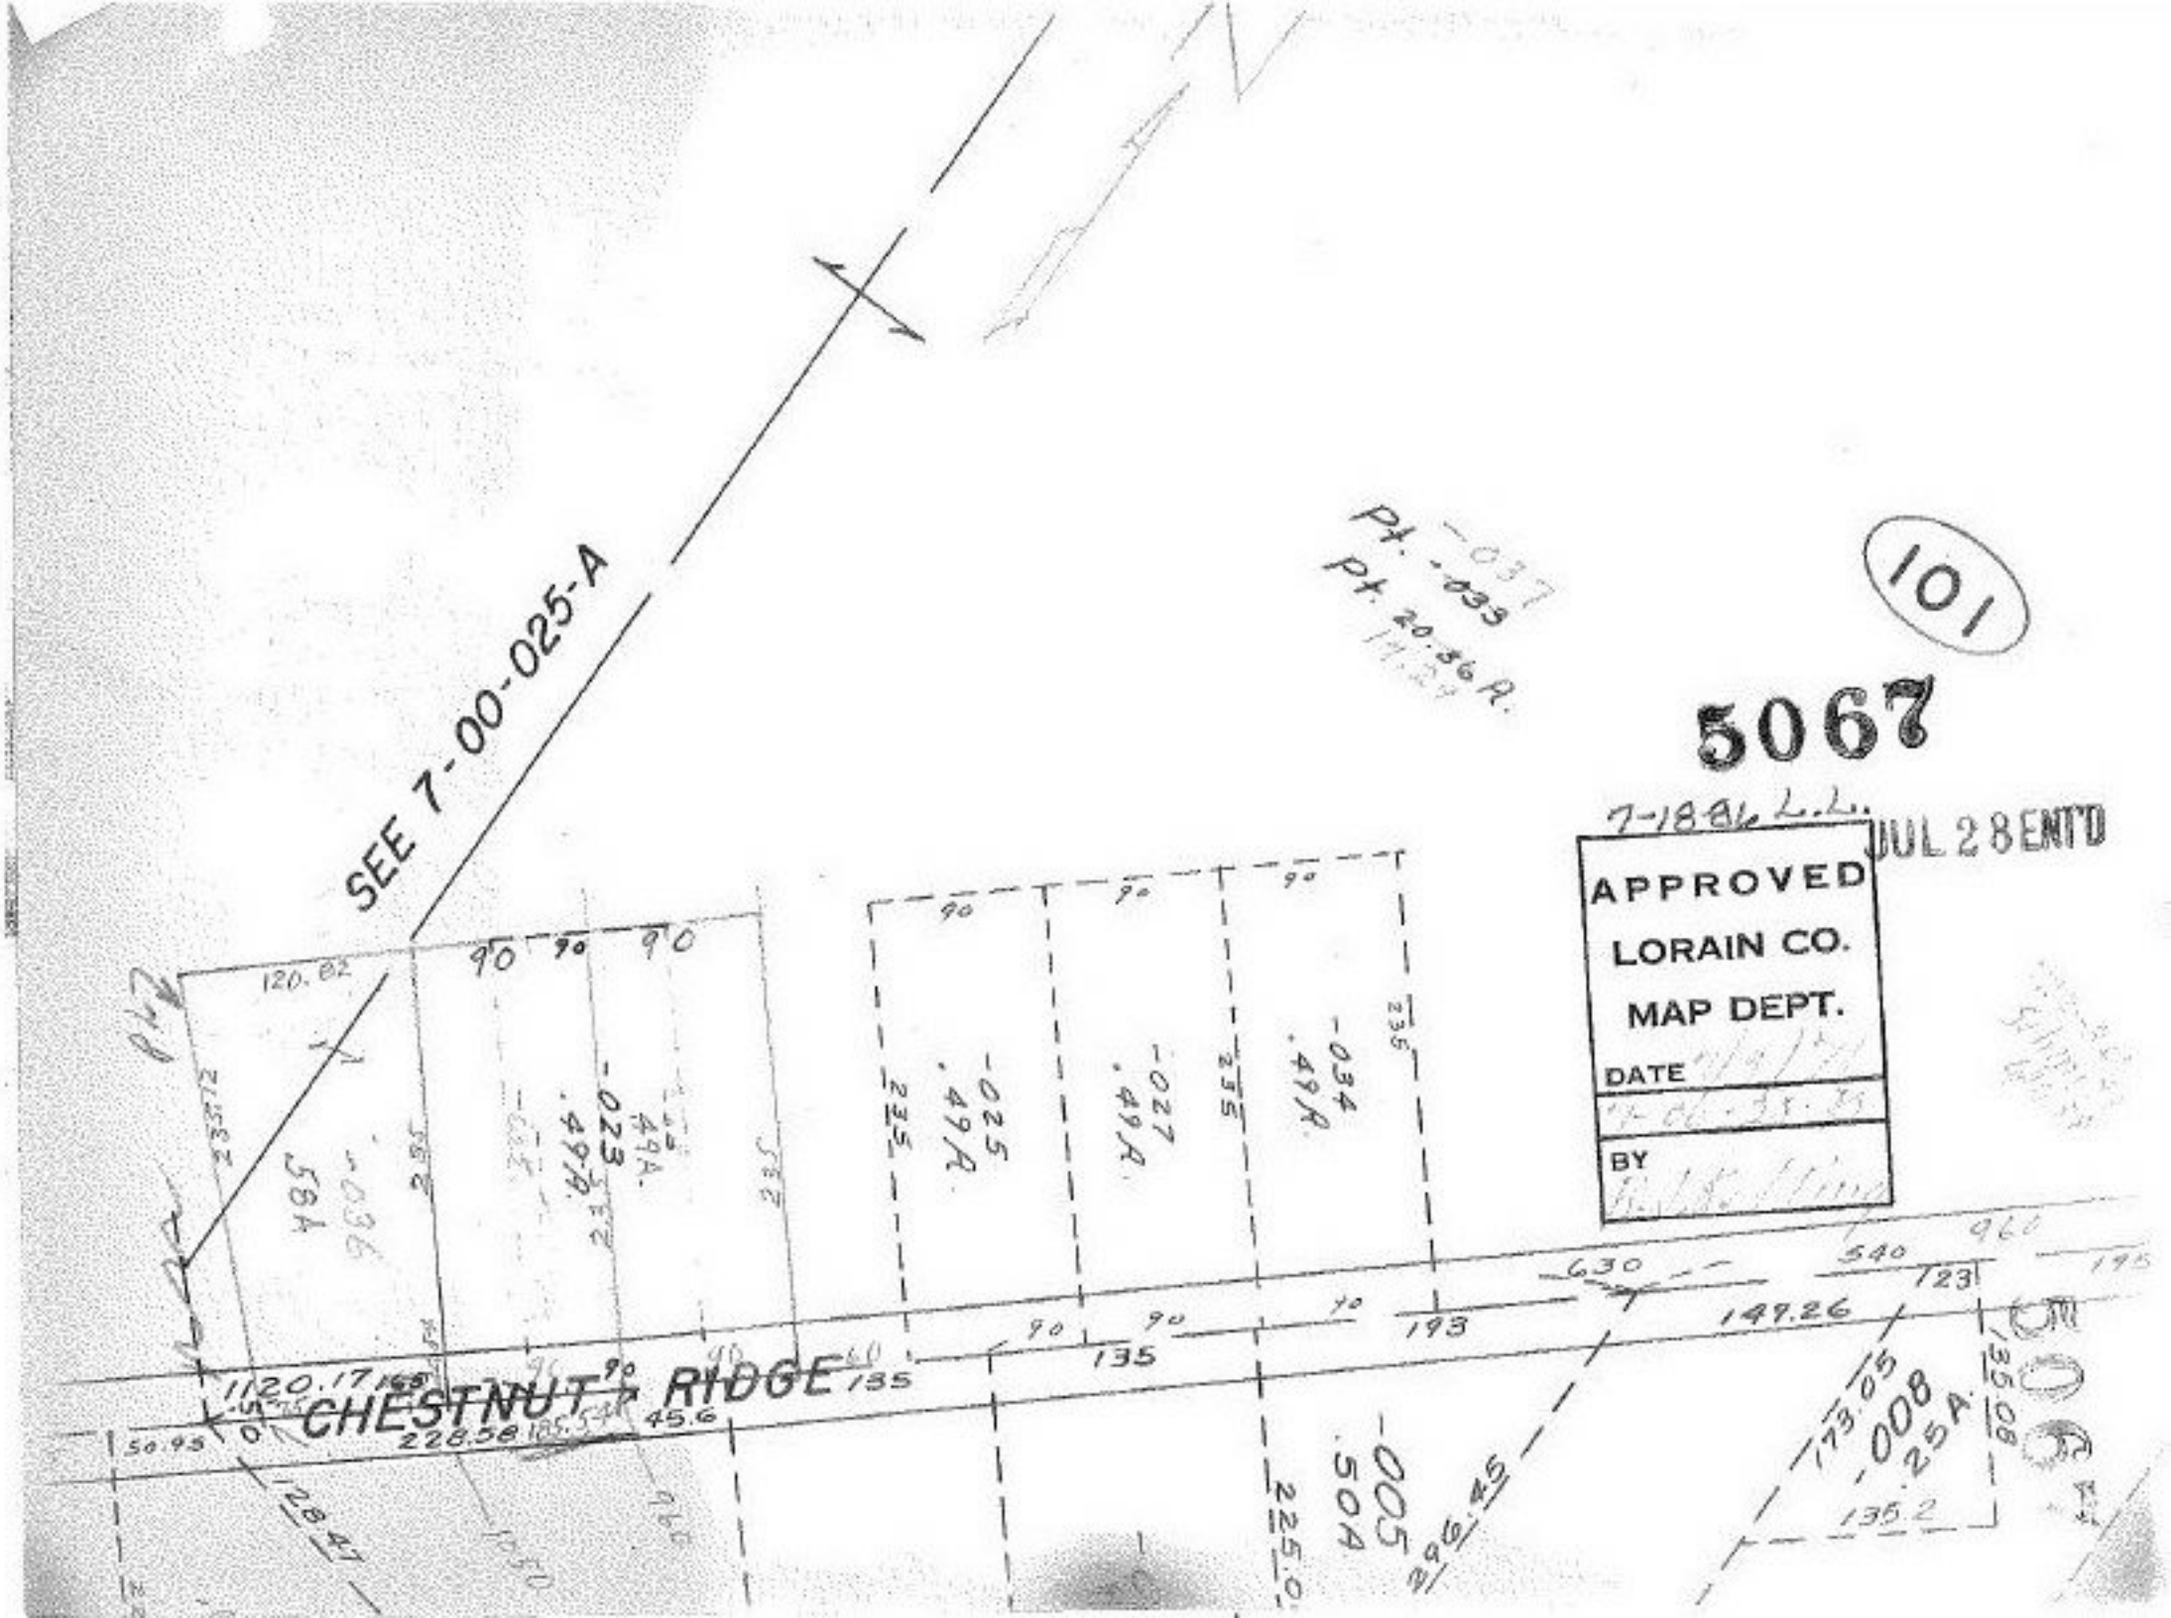
SEE 7-00-025-A
pt. -037
pt. -033
pt. 20.56 A.
101
5067
7-18-81 L.L.
JUL 28 ENT'D
APPROVED
LORAIN CO.
MAP DEPT.
DATE
BY
120.82
90
90
90
90
90
90
235.72
235
235
235
235
235
-023
.494 A.
-025
.494 A.
-027
.494 A.
-034
.494 A.
-005
.504 A.
-008
.25 A.
CHESTNUT RIDGE
1120.17
228.58
185.54
45.6
50.95
128.47
135
193
630
540
123
147.26
173.05
135.2
96.45
225.0
135.08