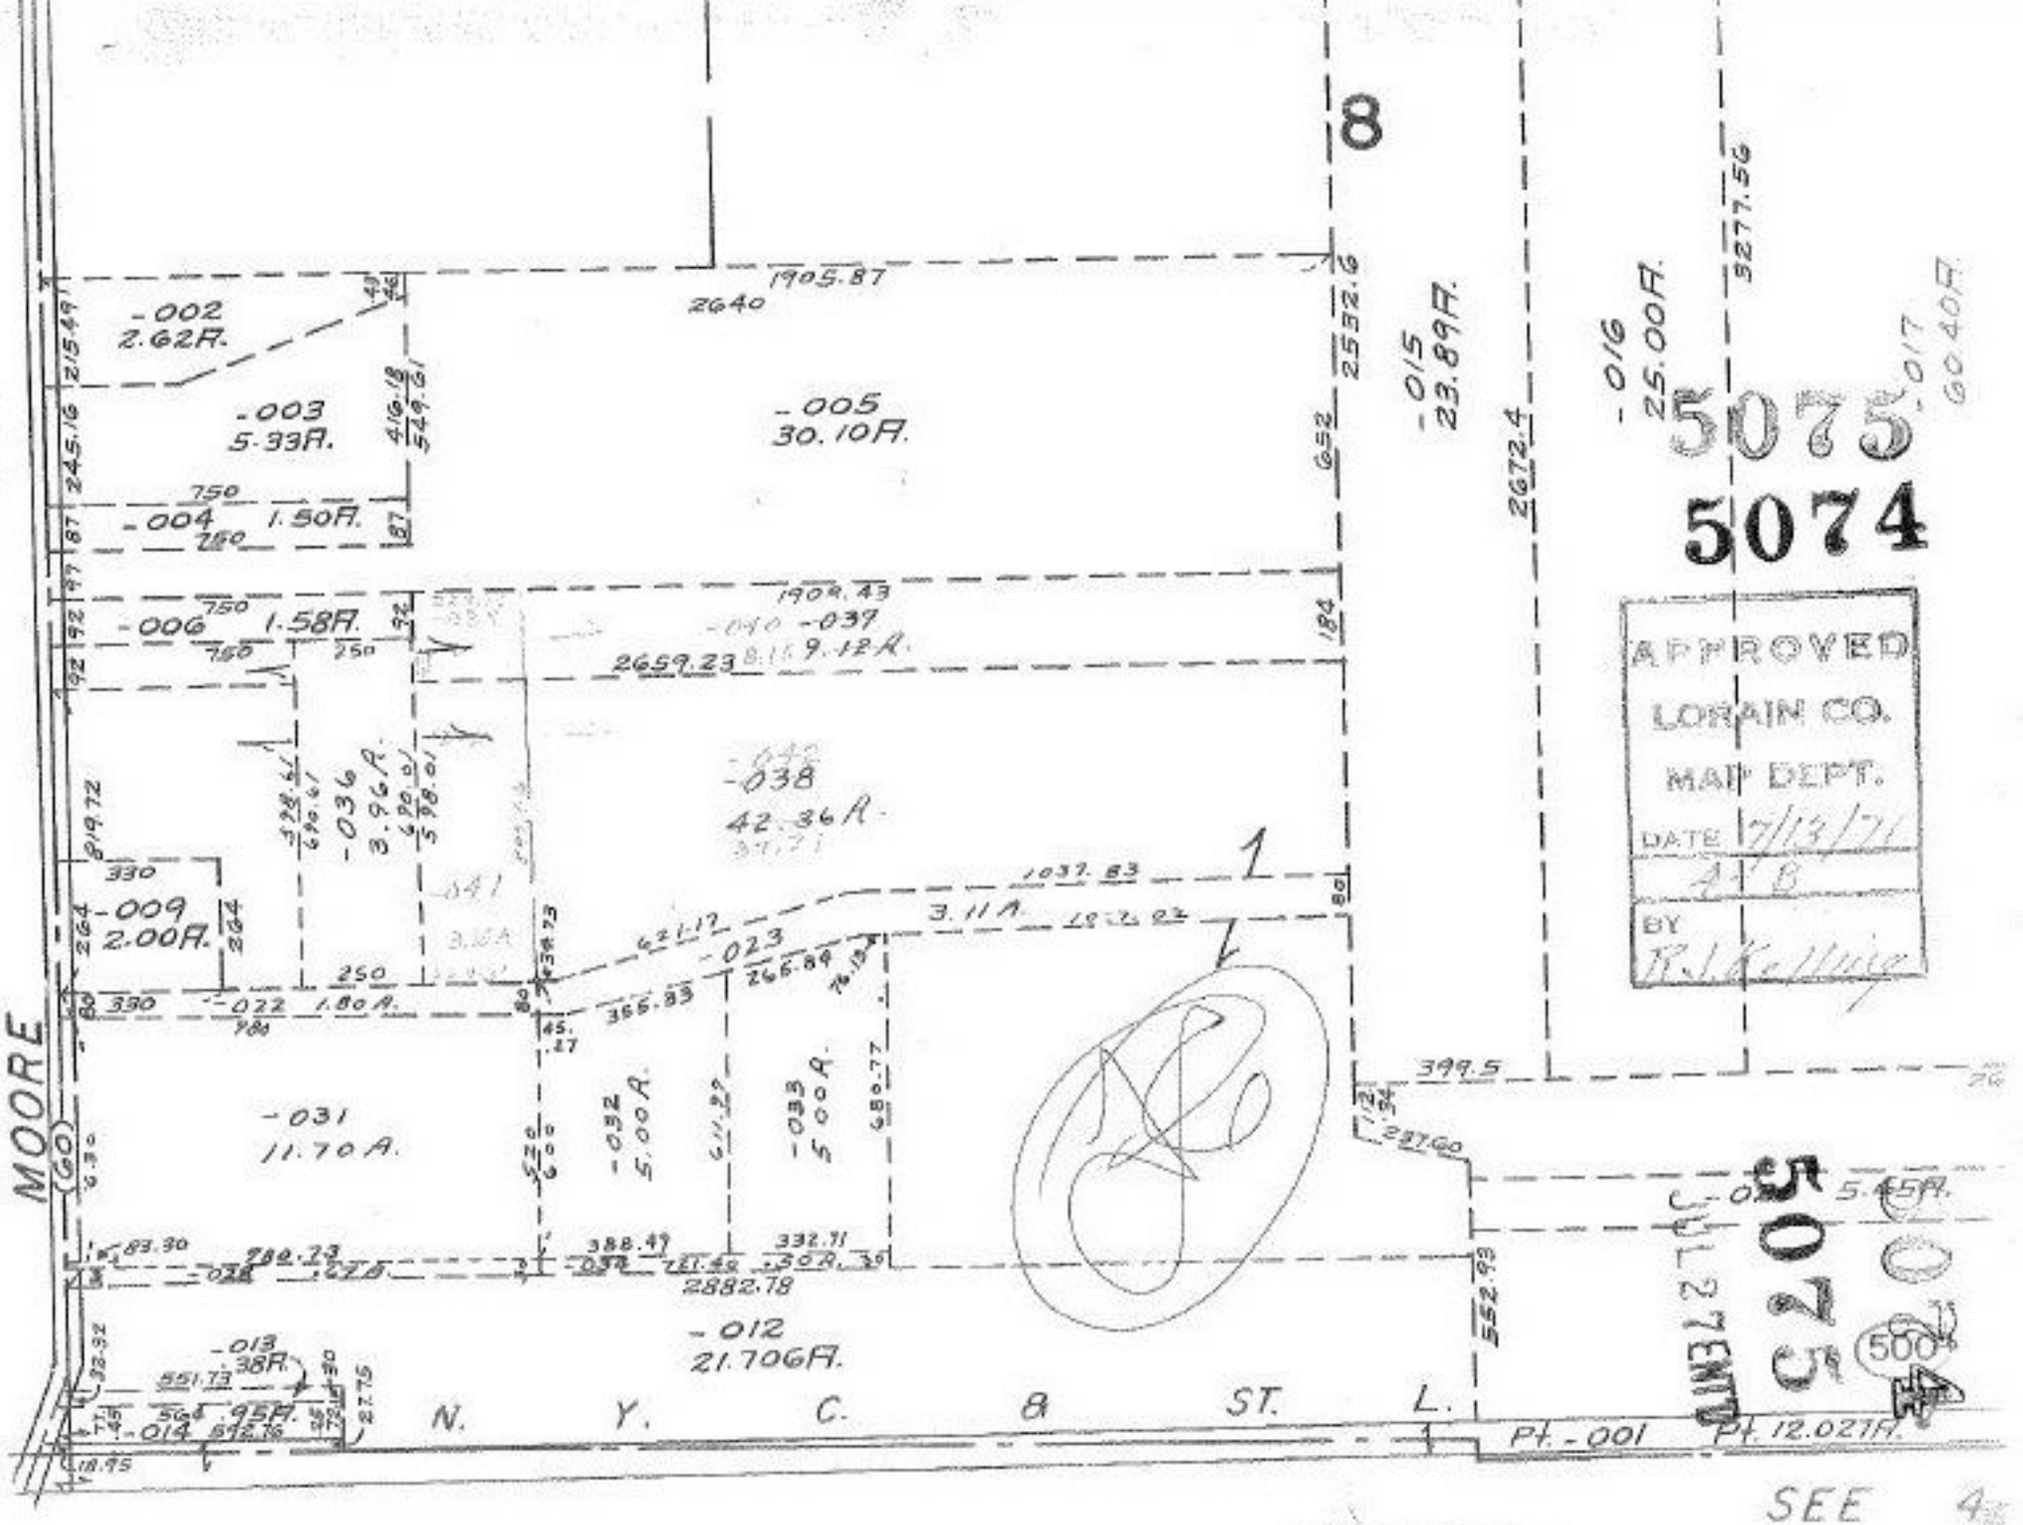
8
5075
5074
APPROVED
LORAIN CO.
MAP DEPT.
DATE 7/13/71
BY
-002
2.62A.
-003
5.33A.
-004 1.50A.
-005
30.10A.
-006 1.58A.
-009
2.00A.
-015
23.89A.
-016
25.00A.
-017
60.40A.
-036
3.96A.
-038
42.36A.
-031
11.70A.
-032
5.00A.
-033
5.00A.
-012
21.706A.
-013
.38A.
-014
-023
-022 1.80A.
-037
9.12A.
-040
-041
-042
-015
-016
-017
-023
-028
-028
-028
-014
-001
Pt. 12.027A.
Pt. -001
N. Y. C. & ST. L.
MOORE
(60)
1905.87
2640
2532.6
2672.4
3277.56
2659.23
1909.43
1037.83
3.11A.
399.5
2882.78
552.93
5.45A.
JUL 27 ENTD
500
SEE 4