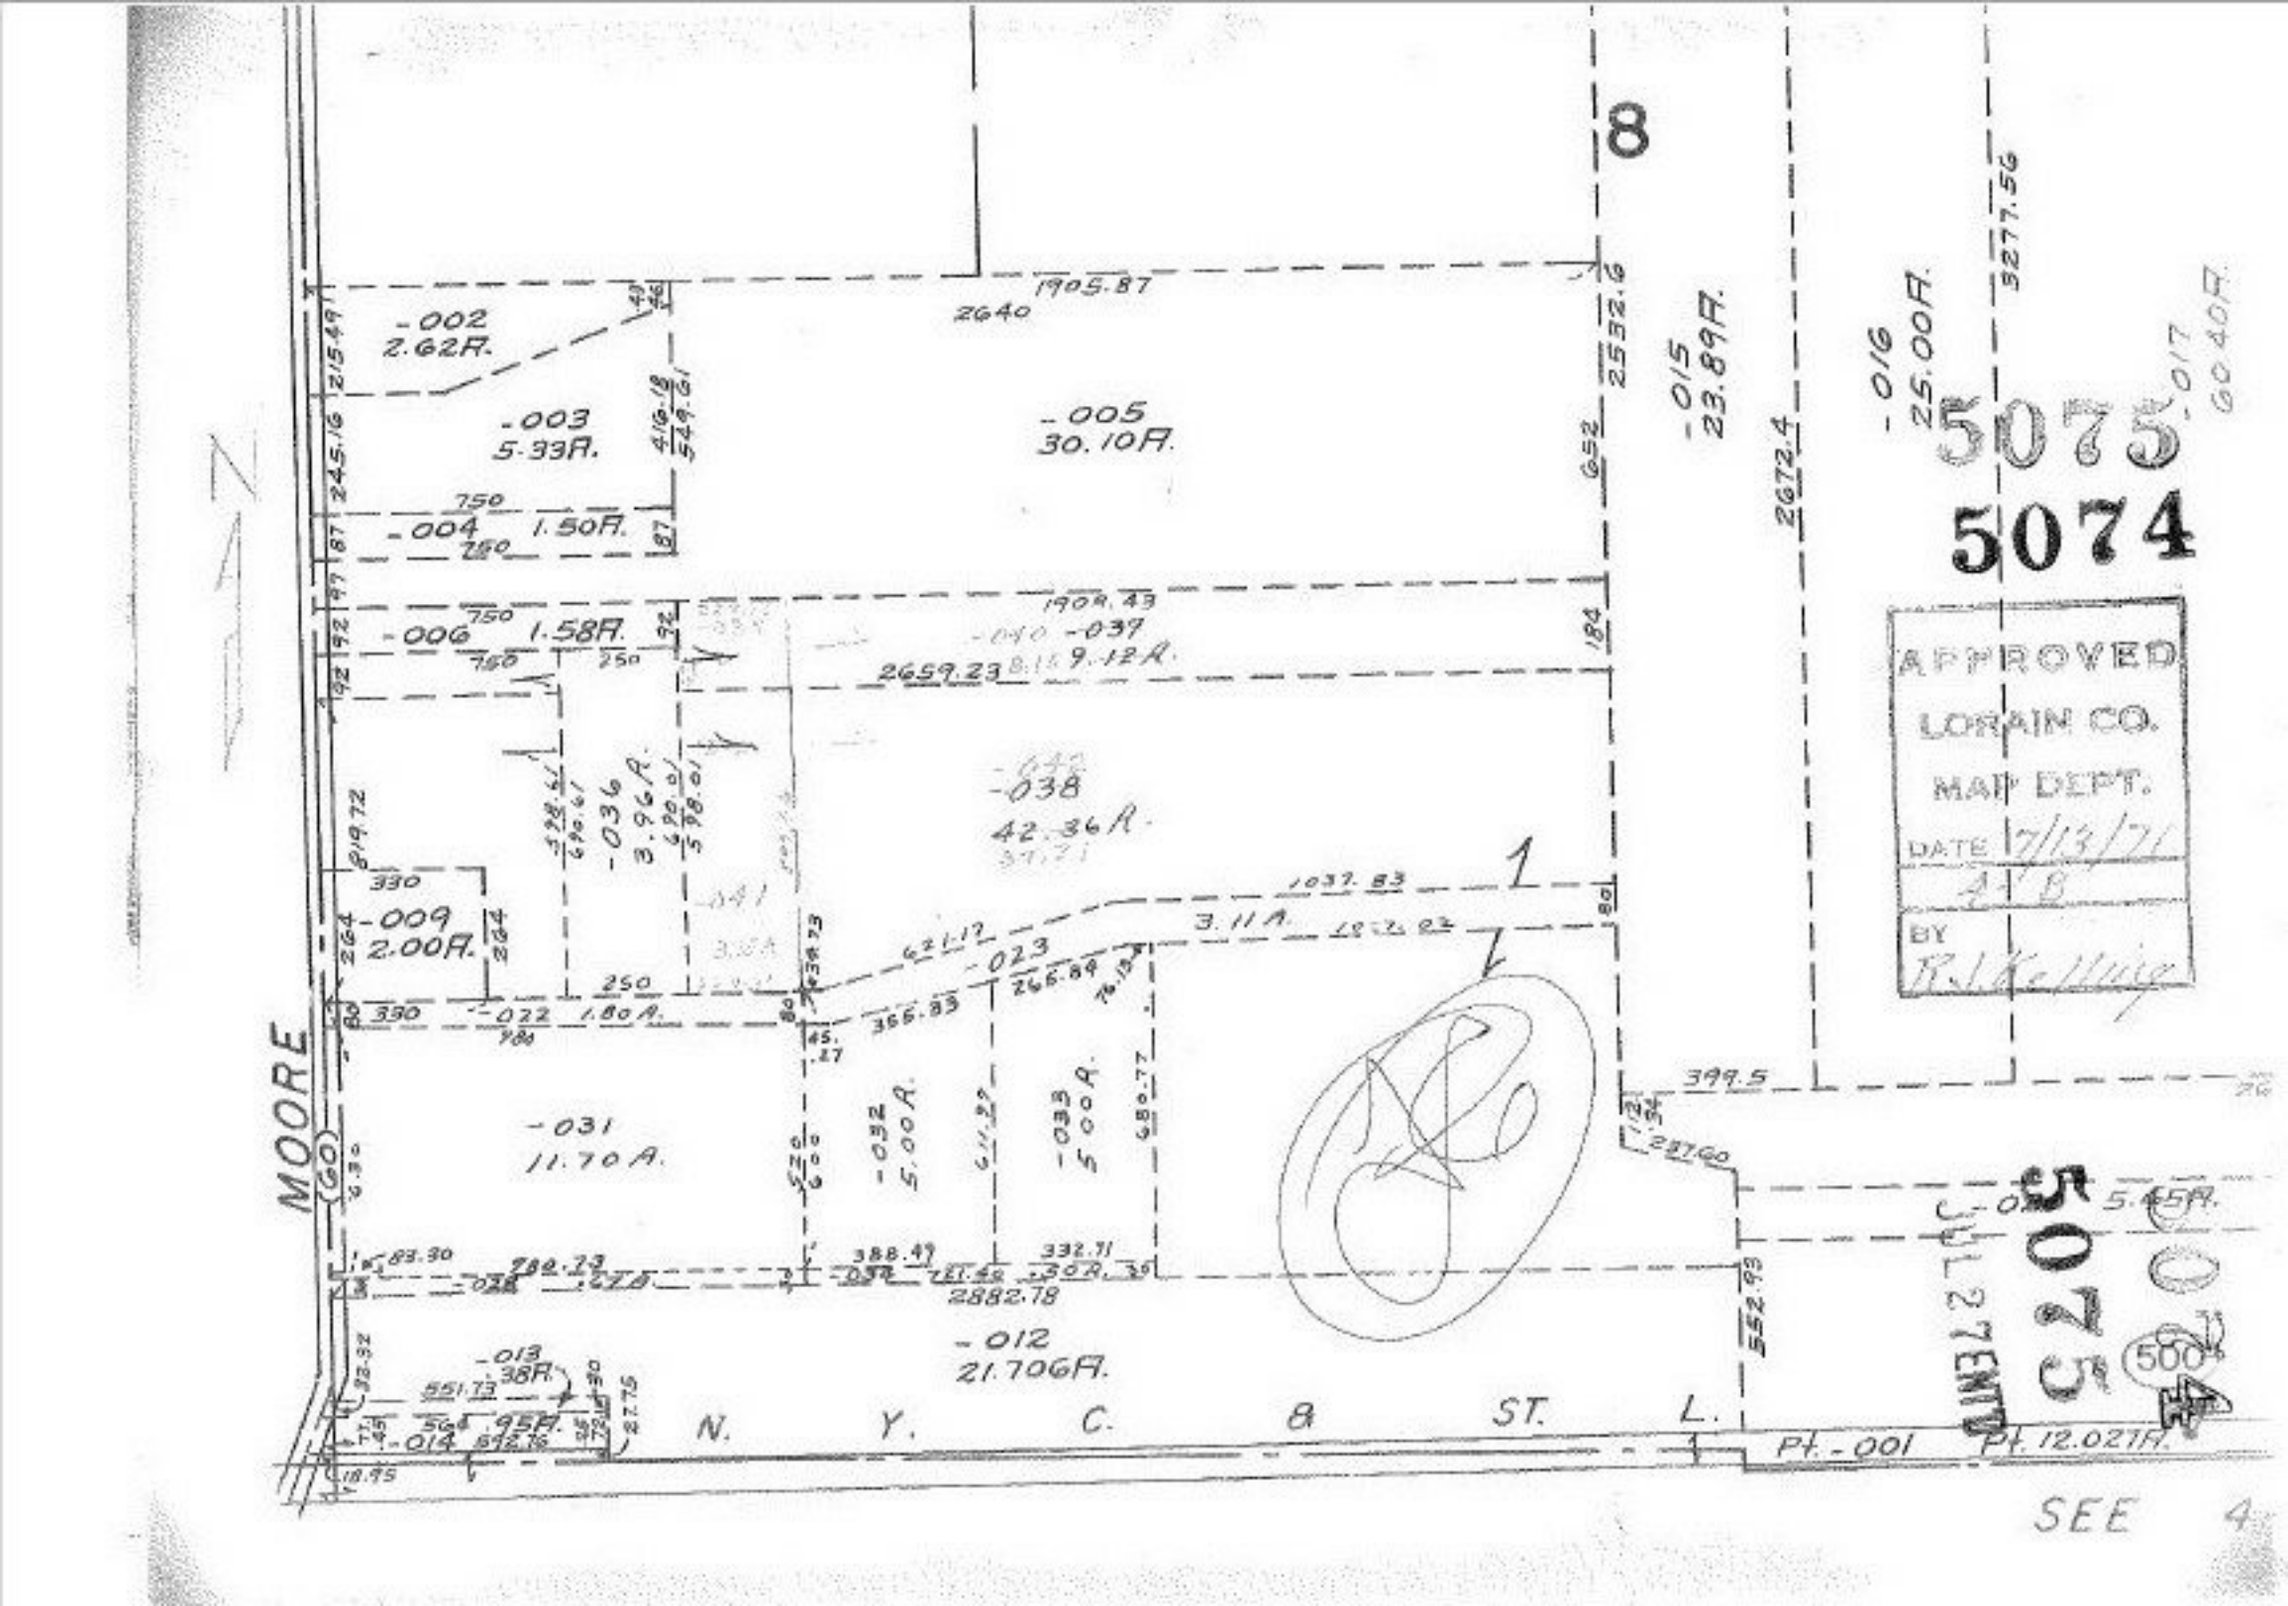
8
1
-002
2.62A.
-003
5.33A.
-004
1.50A.
-005
30.10A.
-006
1.58A.
-009
2.00A.
-036
3.96A.
-037
9.12A.
-038
42.36A.
-039
3.11A.
-040
-041
-022
1.80A.
-023
-031
11.70A.
-032
5.00A.
-033
5.00A.
-012
21.706A.
-013
.38A.
-014
.95A.
-015
23.89A.
-016
25.00A.
-017
60.40A.
-035
5.45A.
MOORE
(60)
N. Y. C. & ST. L.
Pt. -001
Pt. 12.021A.
APPROVED
LORAIN CO.
MAP DEPT.
DATE 7/13/71
BY R.J.Kellie
5074
SEE 4