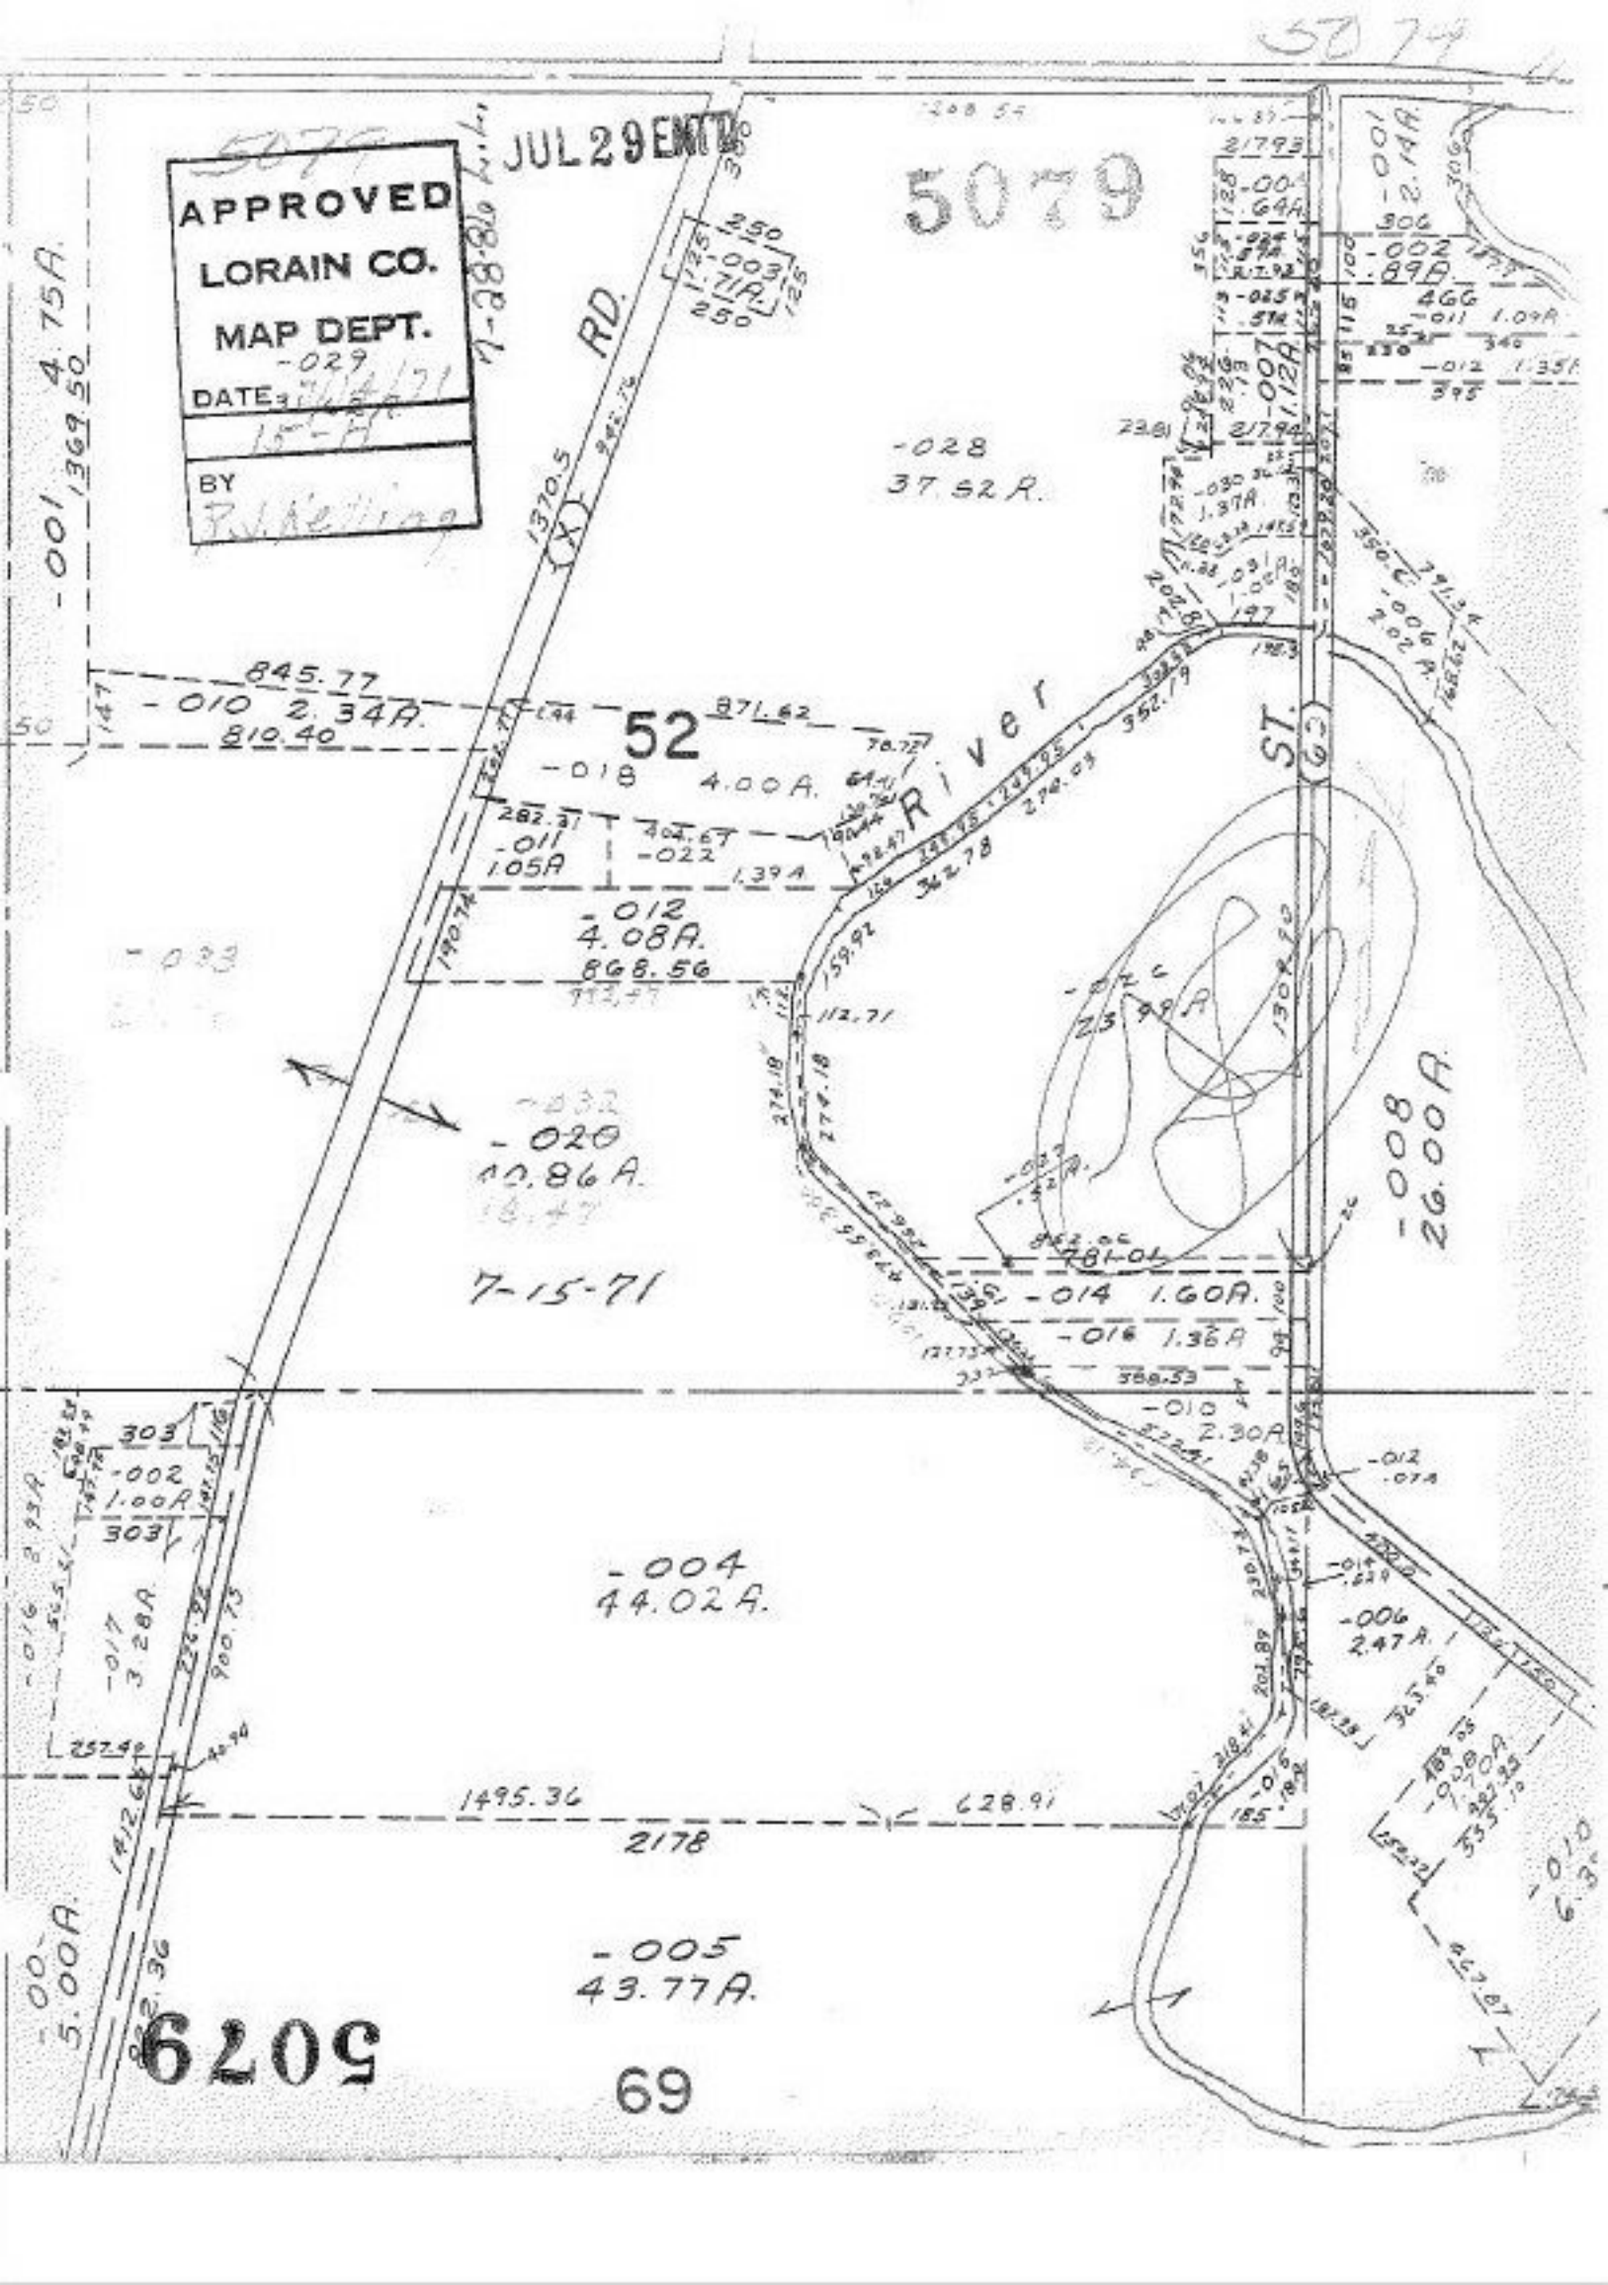
APPROVED
LORAIN CO.
MAP DEPT.
-029
DATE: 7-14-71
BY R.L.Hetling
JUL 29 EMT
5079
-028
37.52 R.
-001
2.14A.
-002
1.89A.
-007
1.12A.
-001
4.75A.
1369.50
-010
2.34A.
810.40
845.77
52
-018
4.00A.
-011
1.05A.
-022
1.39A.
-012
4.08A.
868.56
River
ST.
-008
26.00A.
-020
10.86A.
7-15-71
-014
1.60A.
-016
1.36A.
-010
2.30A.
-002
1.00A.
-017
3.28A.
-004
44.02A.
-006
2.47A.
-005
43.77A.
2178
1495.36
5.00A.
5079
69