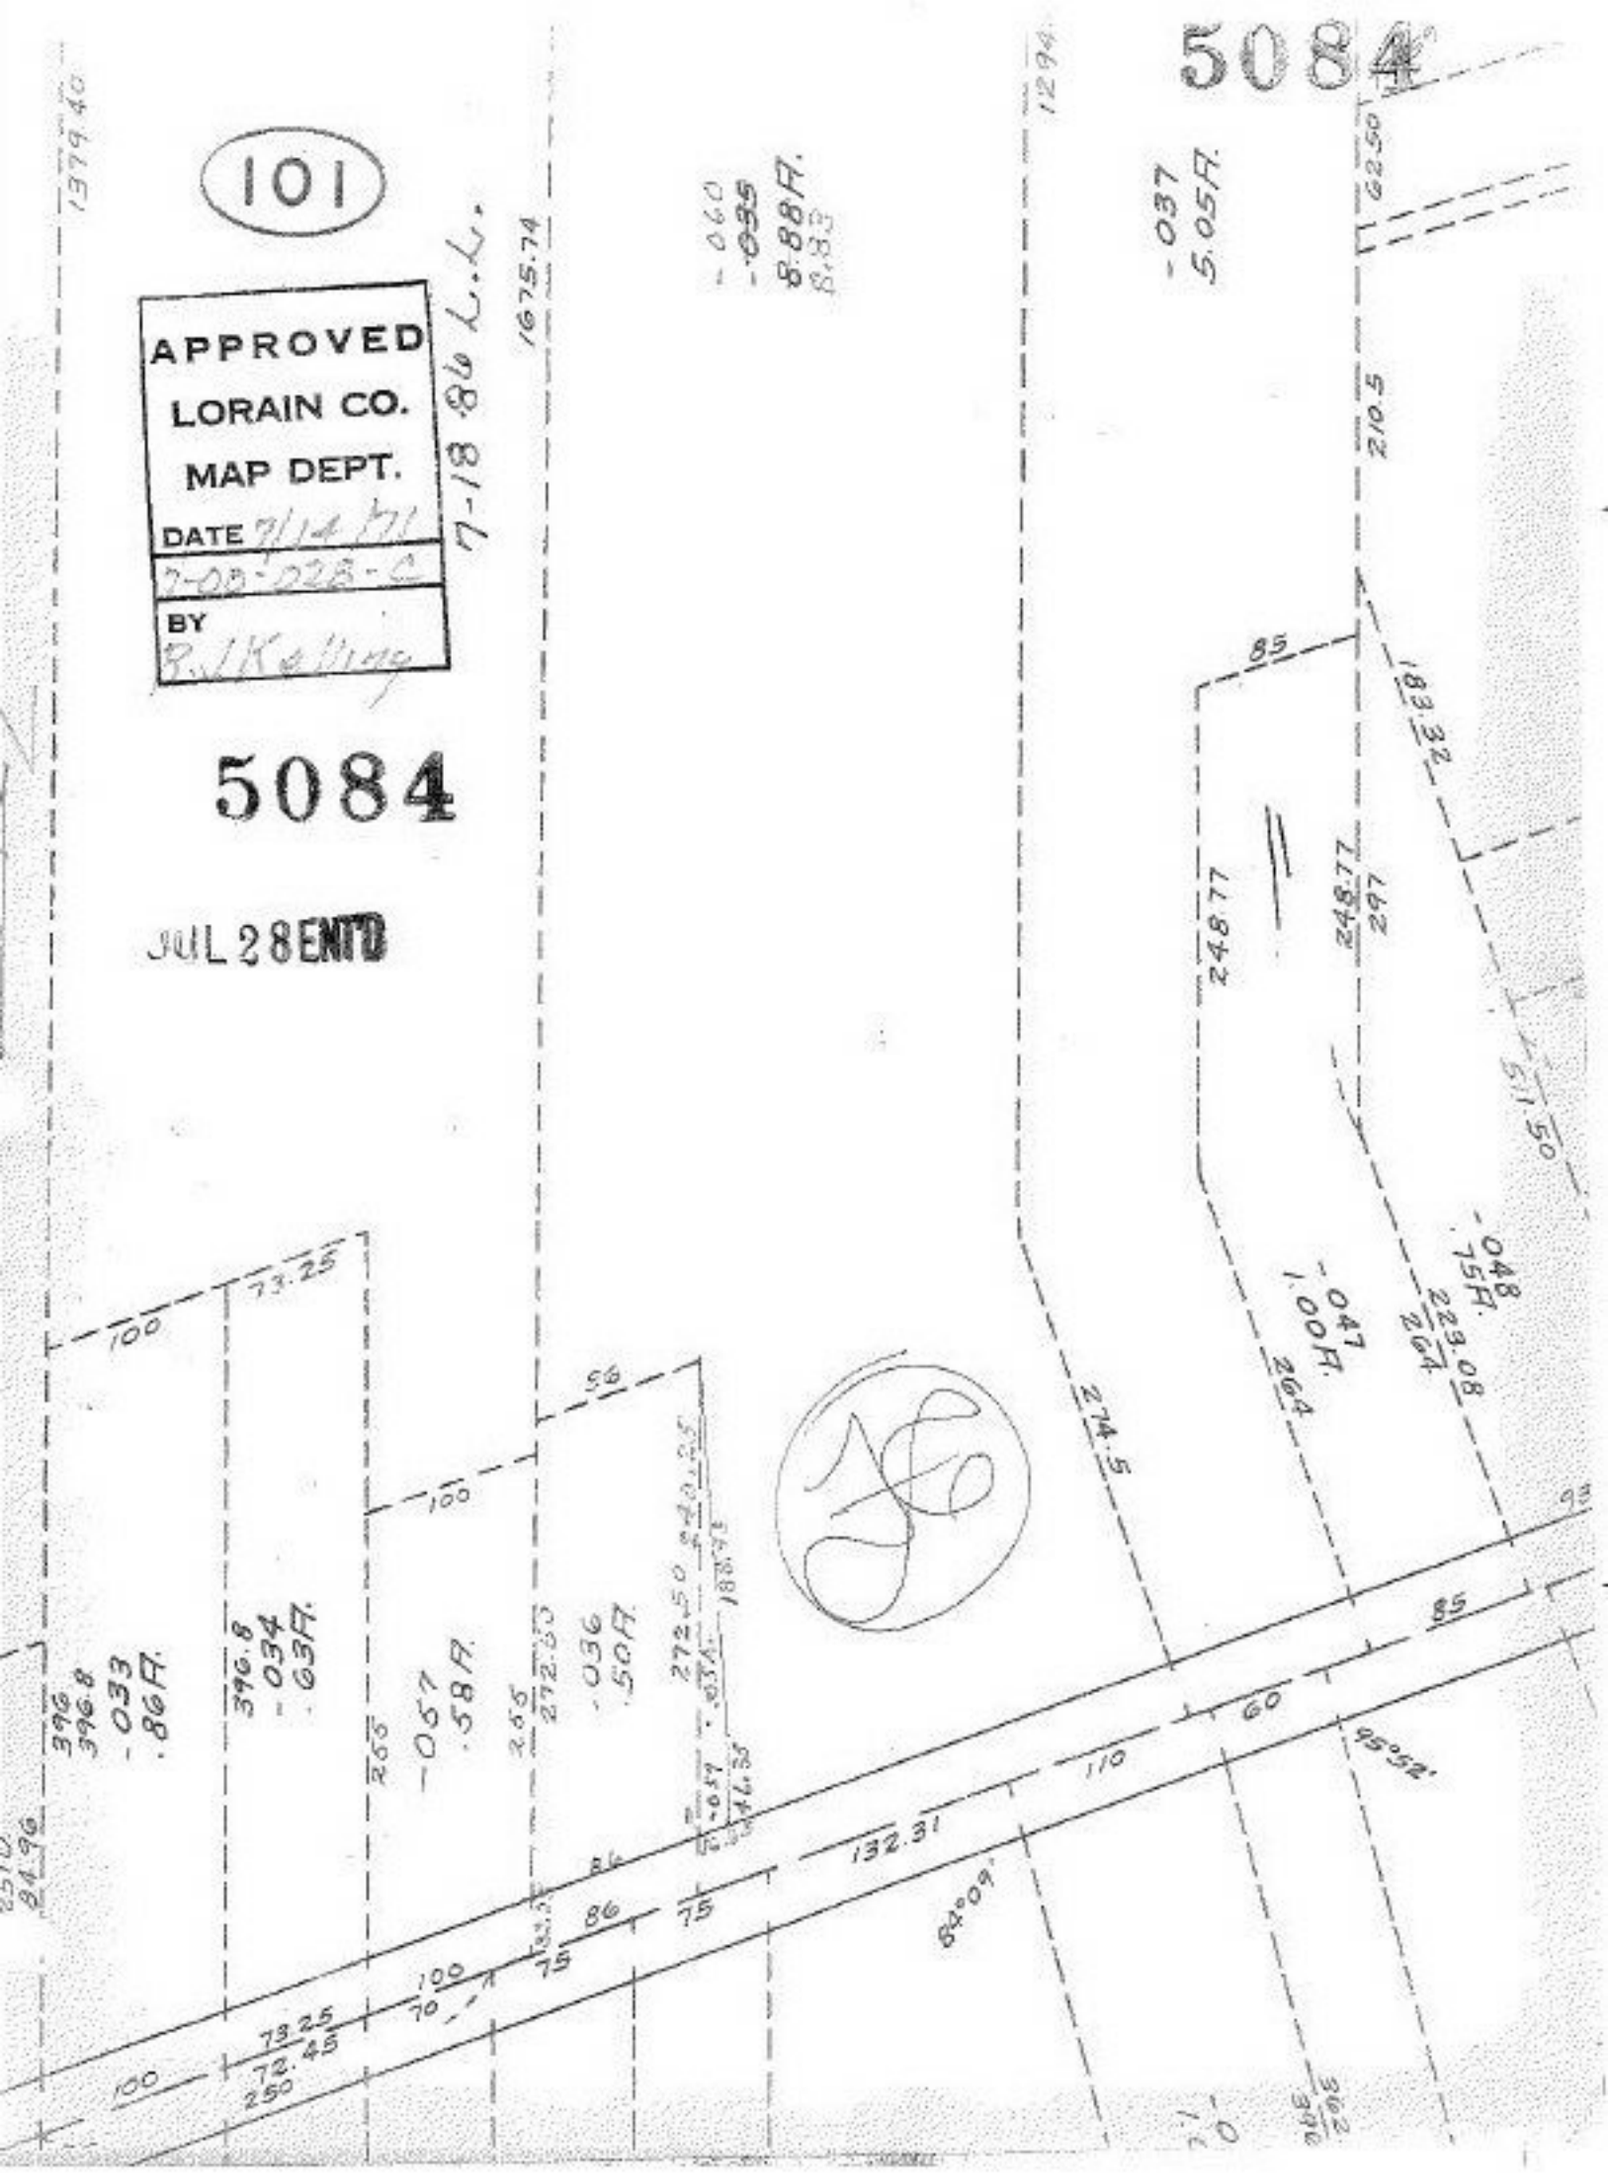
5084
101
APPROVED
LORAIN CO.
MAP DEPT.
DATE 7/14/71
7-08-028-C
BY
R.J.Kelling
7-18-86 L.L.
5084
JUL 28 ENT'D
1379.40
1675.74
1294
-060
-035
8.88A.
-037
5.05A.
62.50
210.5
85
183.32
248.77
248.77
297
511.50
-048
.75A.
223.08
264
-047
1.00A.
264
274.5
73.25
100
56
100
396
396.8
-033
.86A.
396.8
-034
.63A.
255
-057
.58A.
255
272.50
-036
.50A.
272.50
240.25
188.75
85
60
110
132.31
95°52'
84°09'
86
75
100
70
73.25
72.45
250
100
362
396