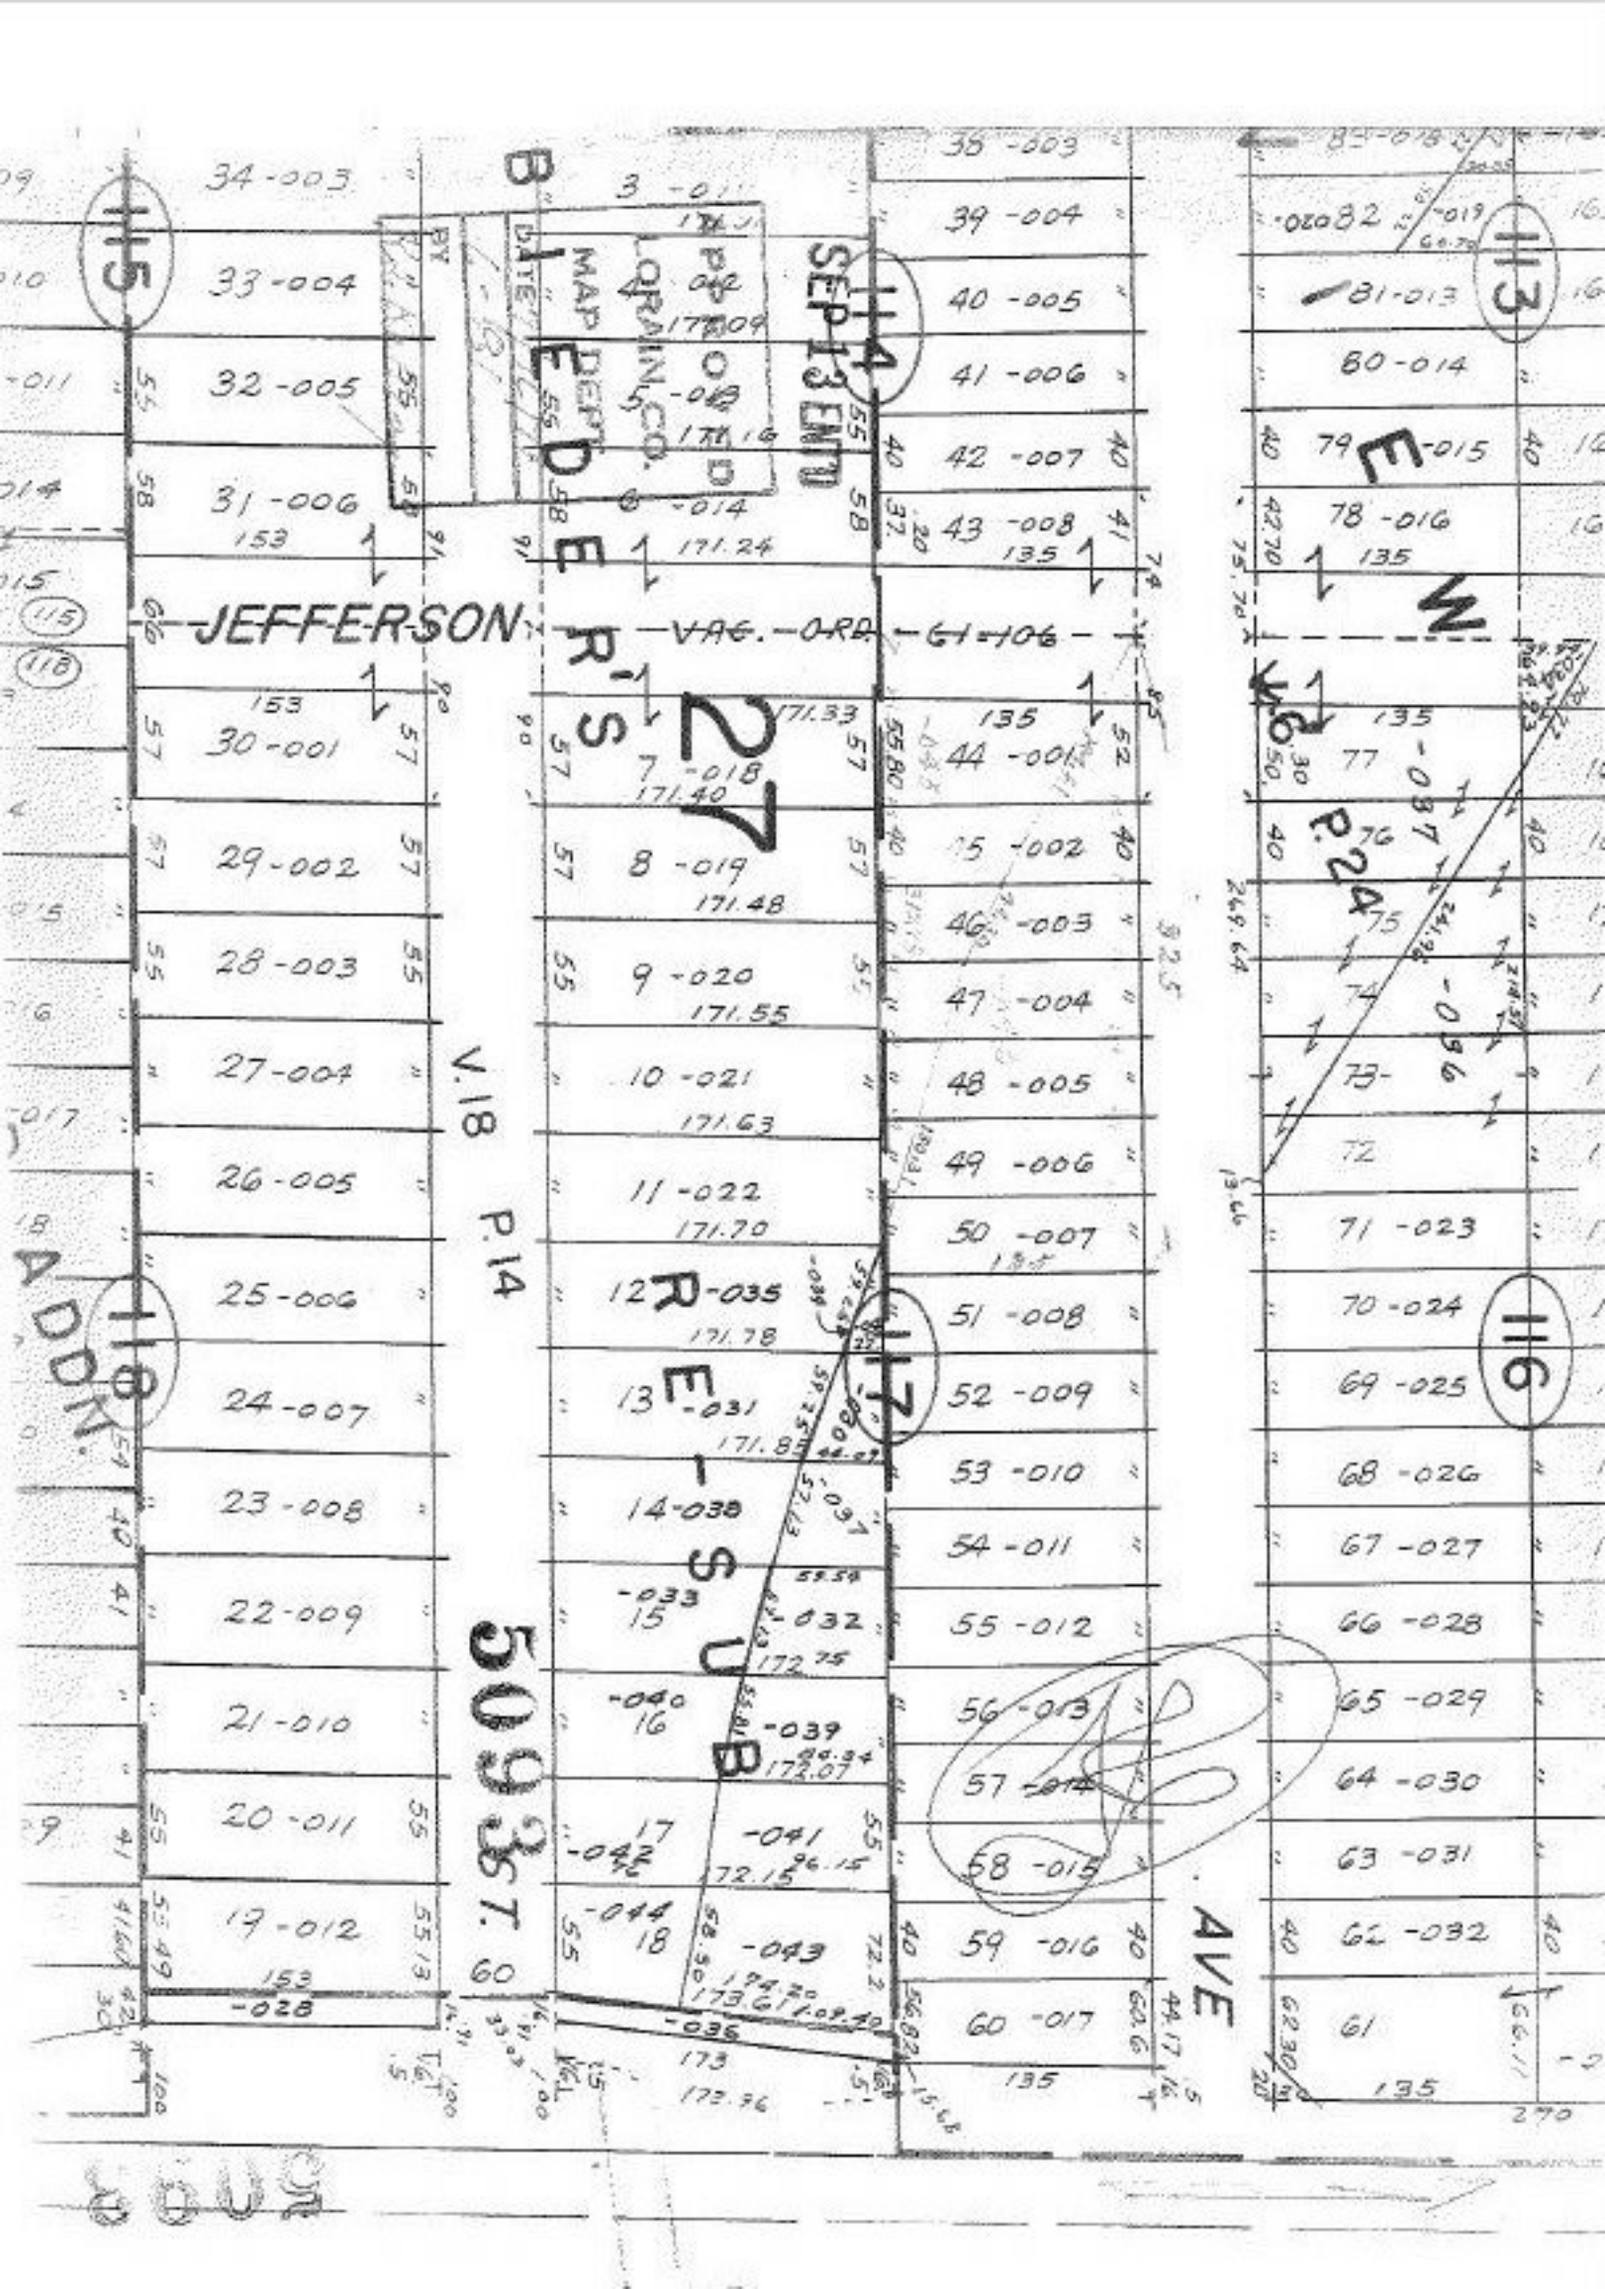
JEFFERSON
VAC. ORD 61-106
SEP 13 EMD
MAP DEPT.
LORAIN CO.
V.18 P.14
ADDN.
AVE
115
116
117
118
E
W
S
U
B
34-003
33-004
32-005
31-006
30-001
29-002
28-003
27-004
26-005
25-006
24-007
23-008
22-009
21-010
20-011
19-012
35-003
39-004
40-005
41-006
42-007
43-008
44-001
45-002
46-003
47-004
48-005
49-006
50-007
51-008
52-009
53-010
54-011
55-012
56-013
57-014
58-015
59-016
60-017
61
62
63-031
64-030
65-029
66-028
67-027
68-026
69-025
70-024
71-023
72
73-096
74
75
76
77-087
78-016
79-015
80-014
81-013
82-020
83-018
171.24
171.33
171.40
171.48
171.55
171.63
171.70
171.78
171.85
172.07
172.15
172.75
173
172.96
135
153
50938