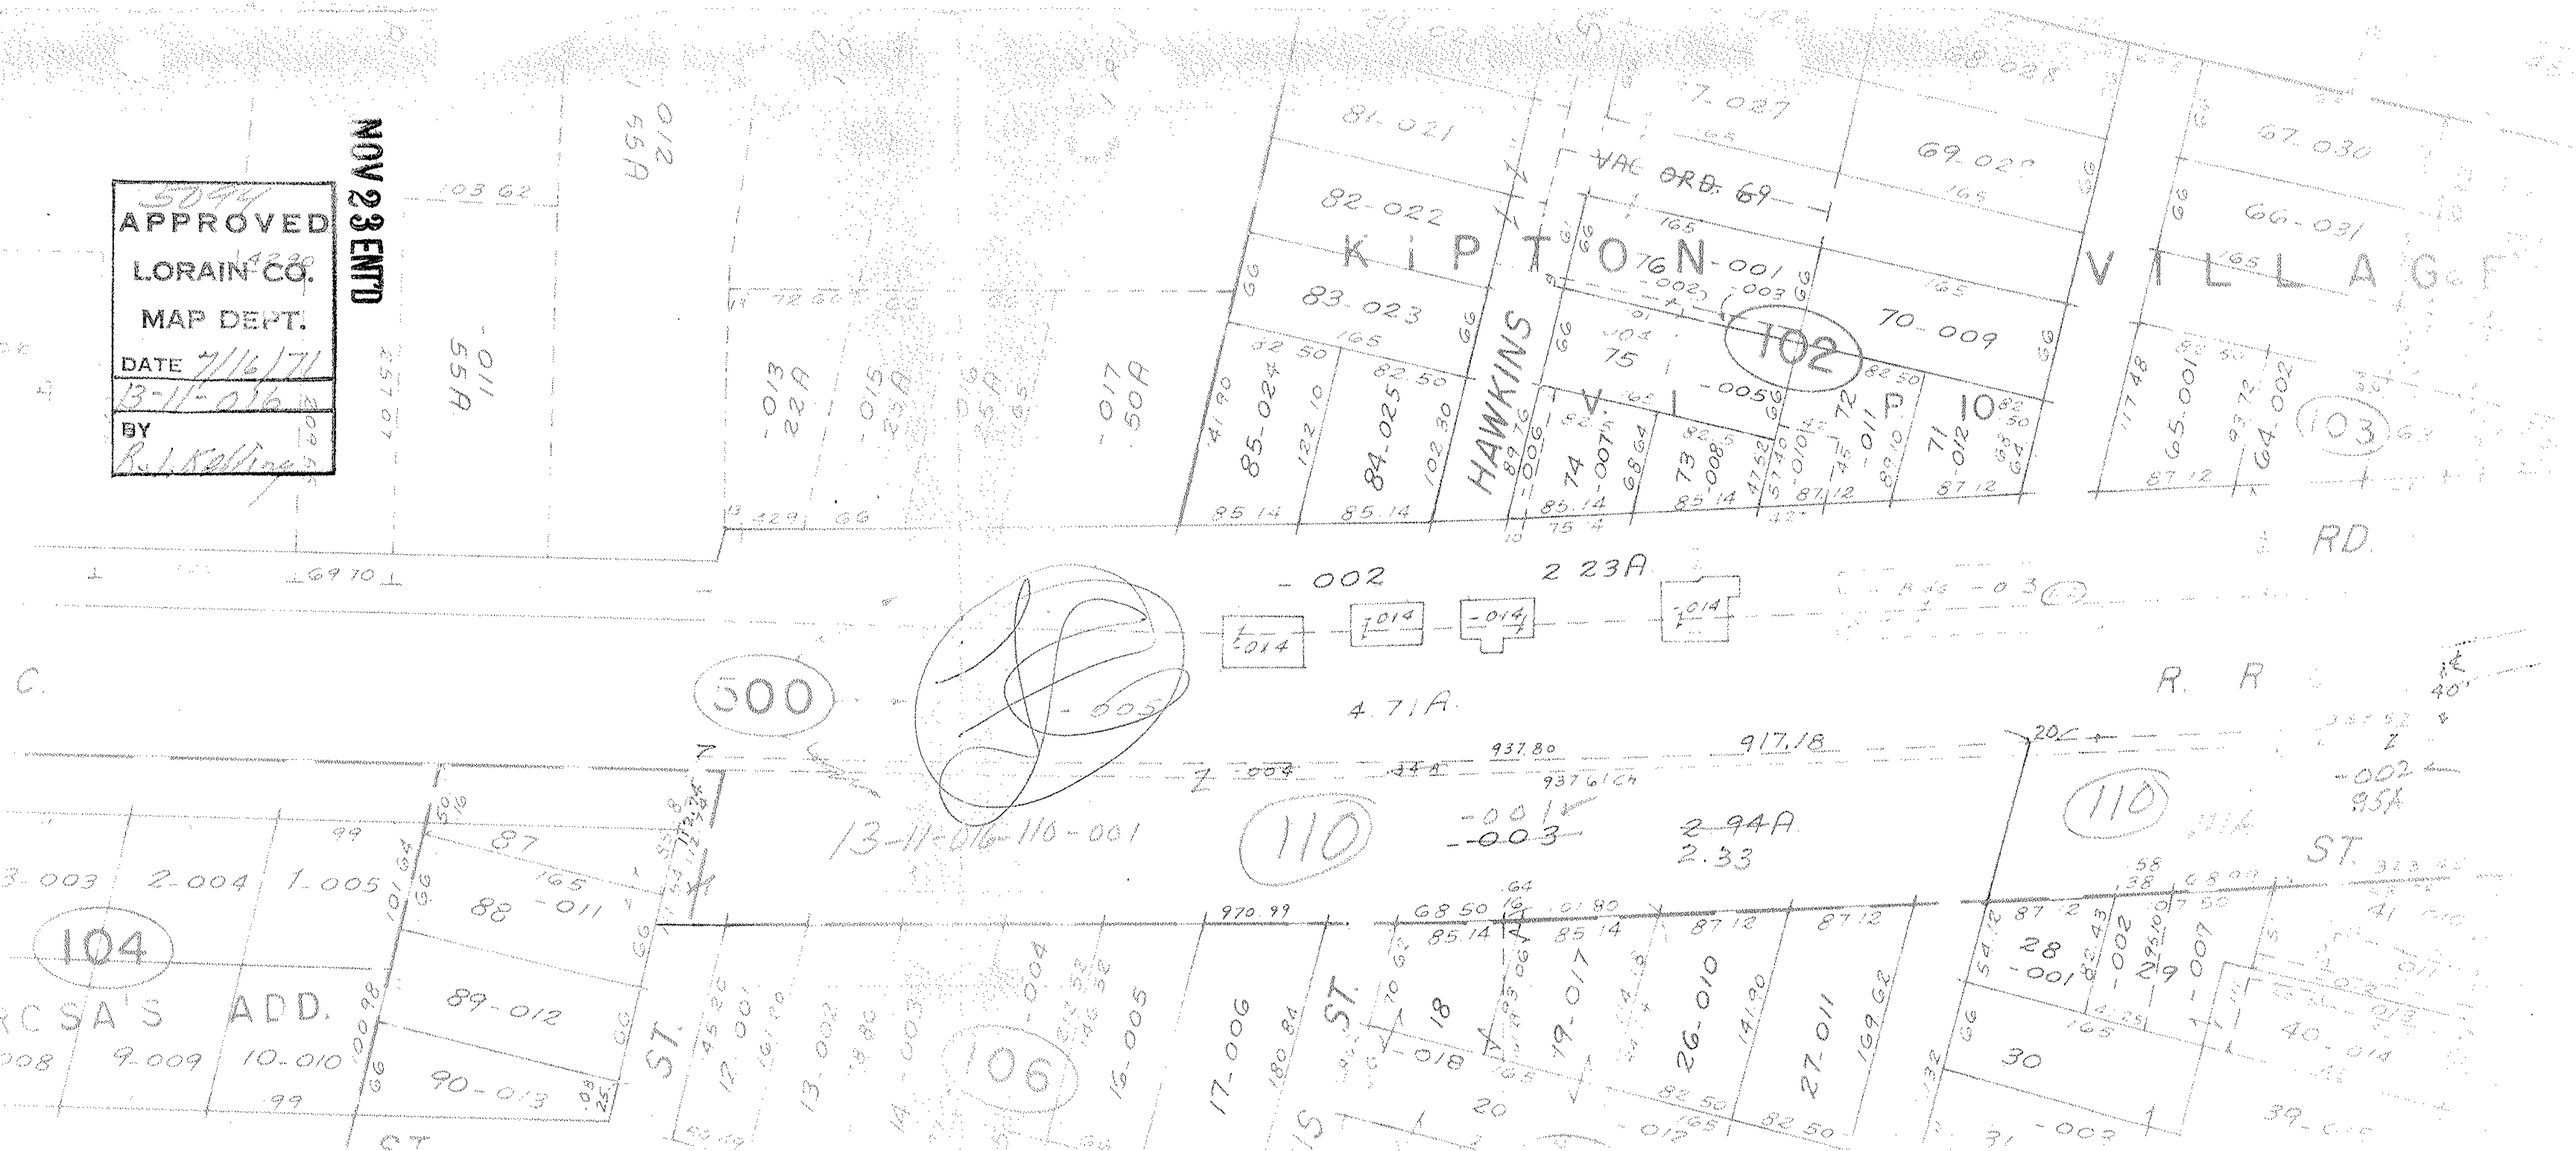

APPROVED
LORAIN CO.
MAP DEPT.
DATE 7/16/71
13-11-016
BY
NOV 23 ENT'D
KIPTON VILLAGE
HAWKINS
VAC ORD. 69
102
103
104
106
110
500
13-11-016-110-001
2.94A
2.33
4.71A
2.23A
RD.
R. R
ST.
ST.
ST.
RCSA'S ADD.