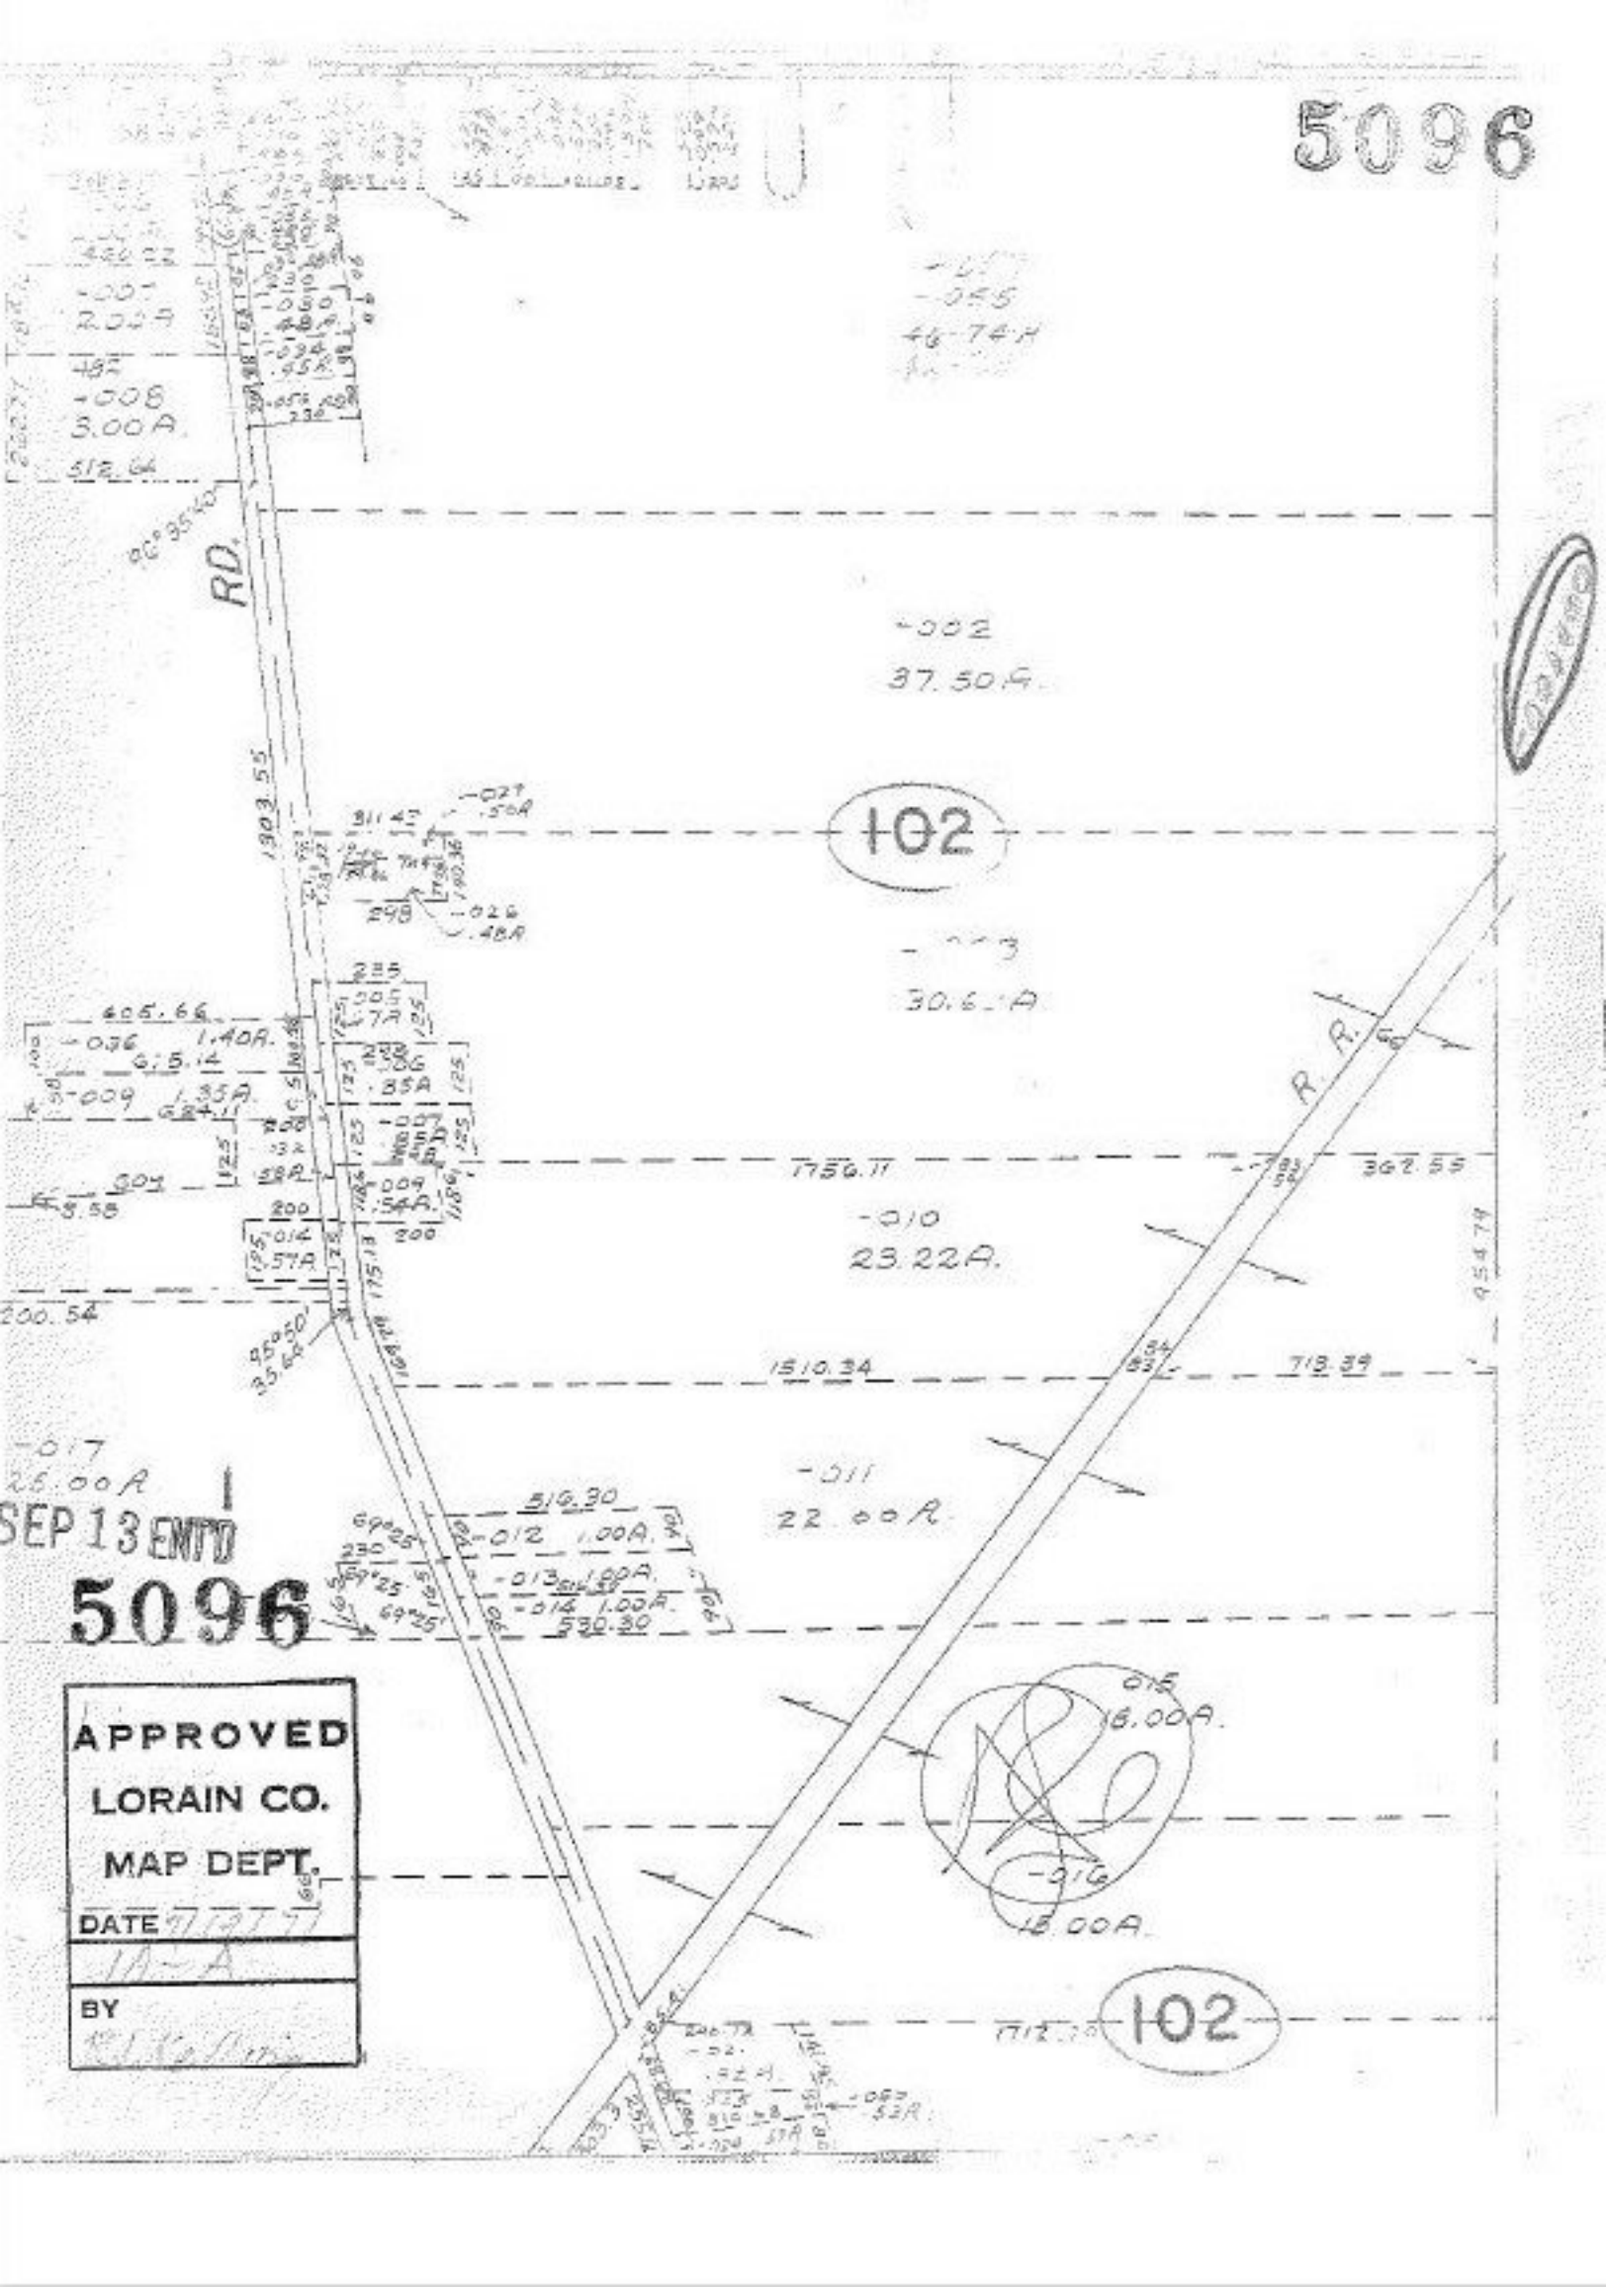
5096
RD.
102
R. R.
-002
37.50A.
-010
23.22A.
-011
22.00A.
-016
16.00A.
-017
26.00A
SEP 13 ENTD
5096
APPROVED
LORAIN CO.
MAP DEPT.
DATE 7/27/77
BY