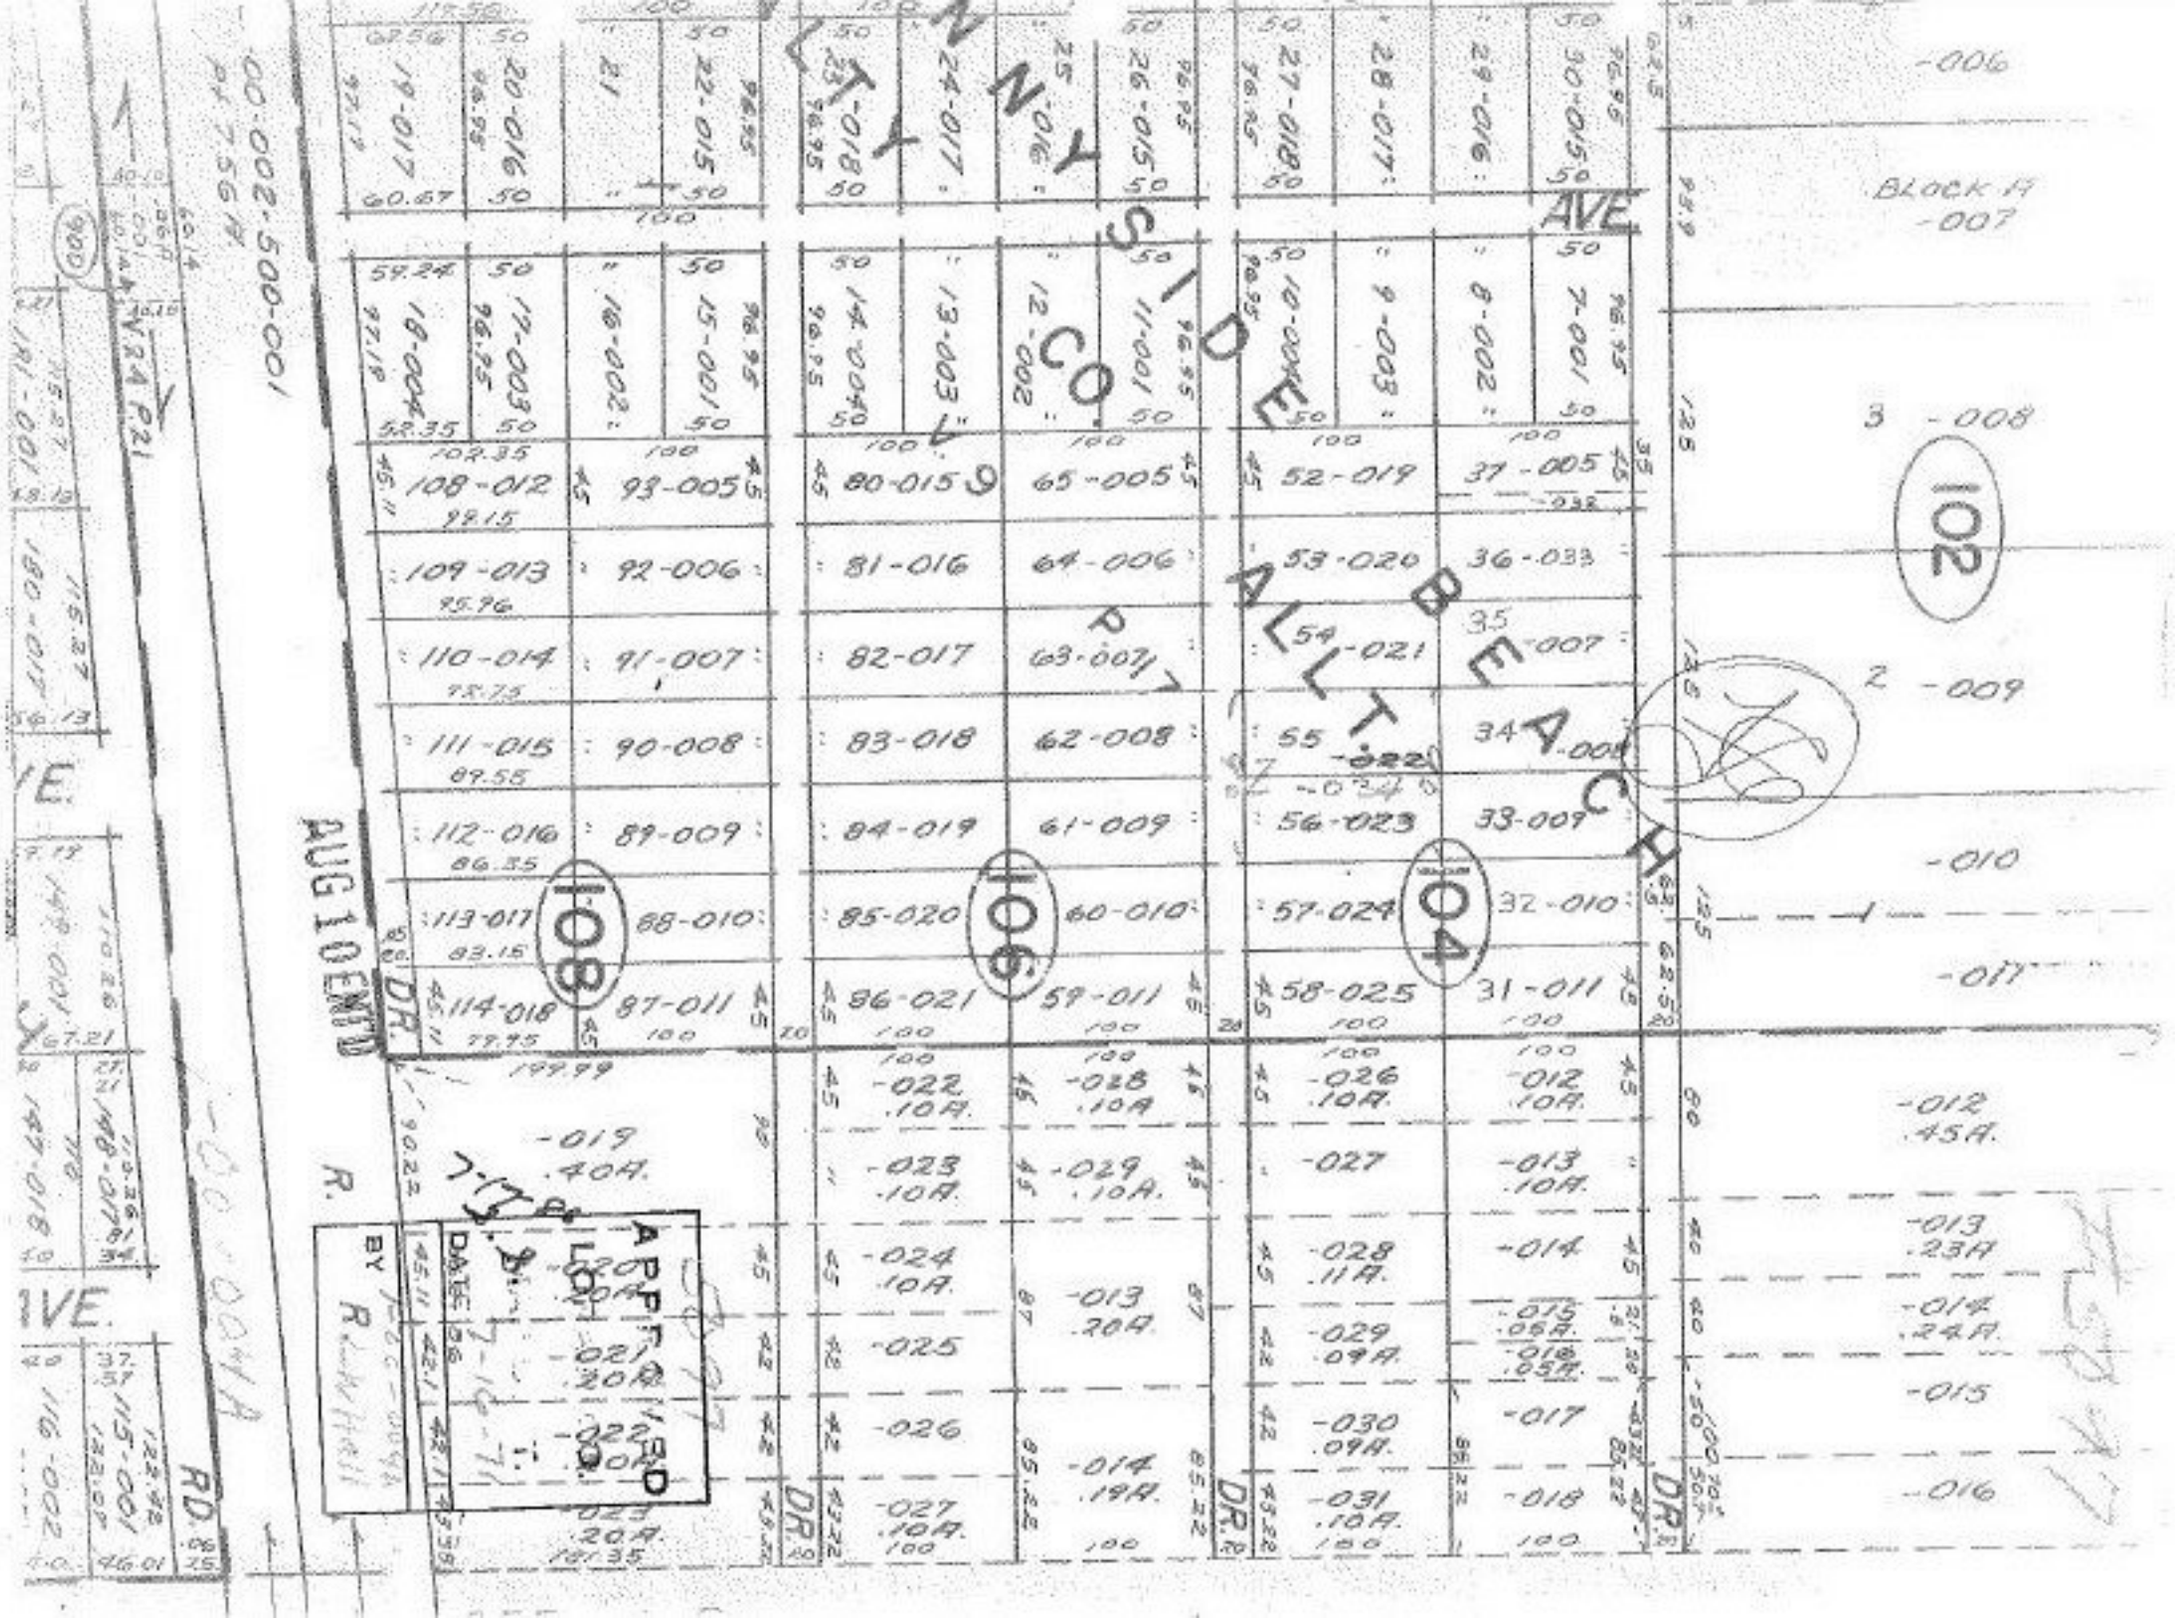
SIDE
BEACH
AVE
BLOCK A
-007
-006
-008
-009
-010
-011
-012
.45A.
-013
.23A
-014
.24A.
-015
-016
102
104
108
106
AUG 10 EMTD
DR.
RD.
AVE.
R.
APPROD
LOT
DATE
BY
-019
.40A.
-020
.10A.
-021
.10A.
-022
.10A.
-023
.10A.
-024
.10A.
-025
-026
-027
.10A.
-028
.10A.
-029
.10A.
-013
.20A.
-014
.19A.
-027
.20A.
-028
.11A.
-029
.09A.
-030
.09A.
-031
.10A.
-012
.10A.
-013
.10A.
-014
-015
.05A.
-016
.05A.
-017
-018
-021
-022
