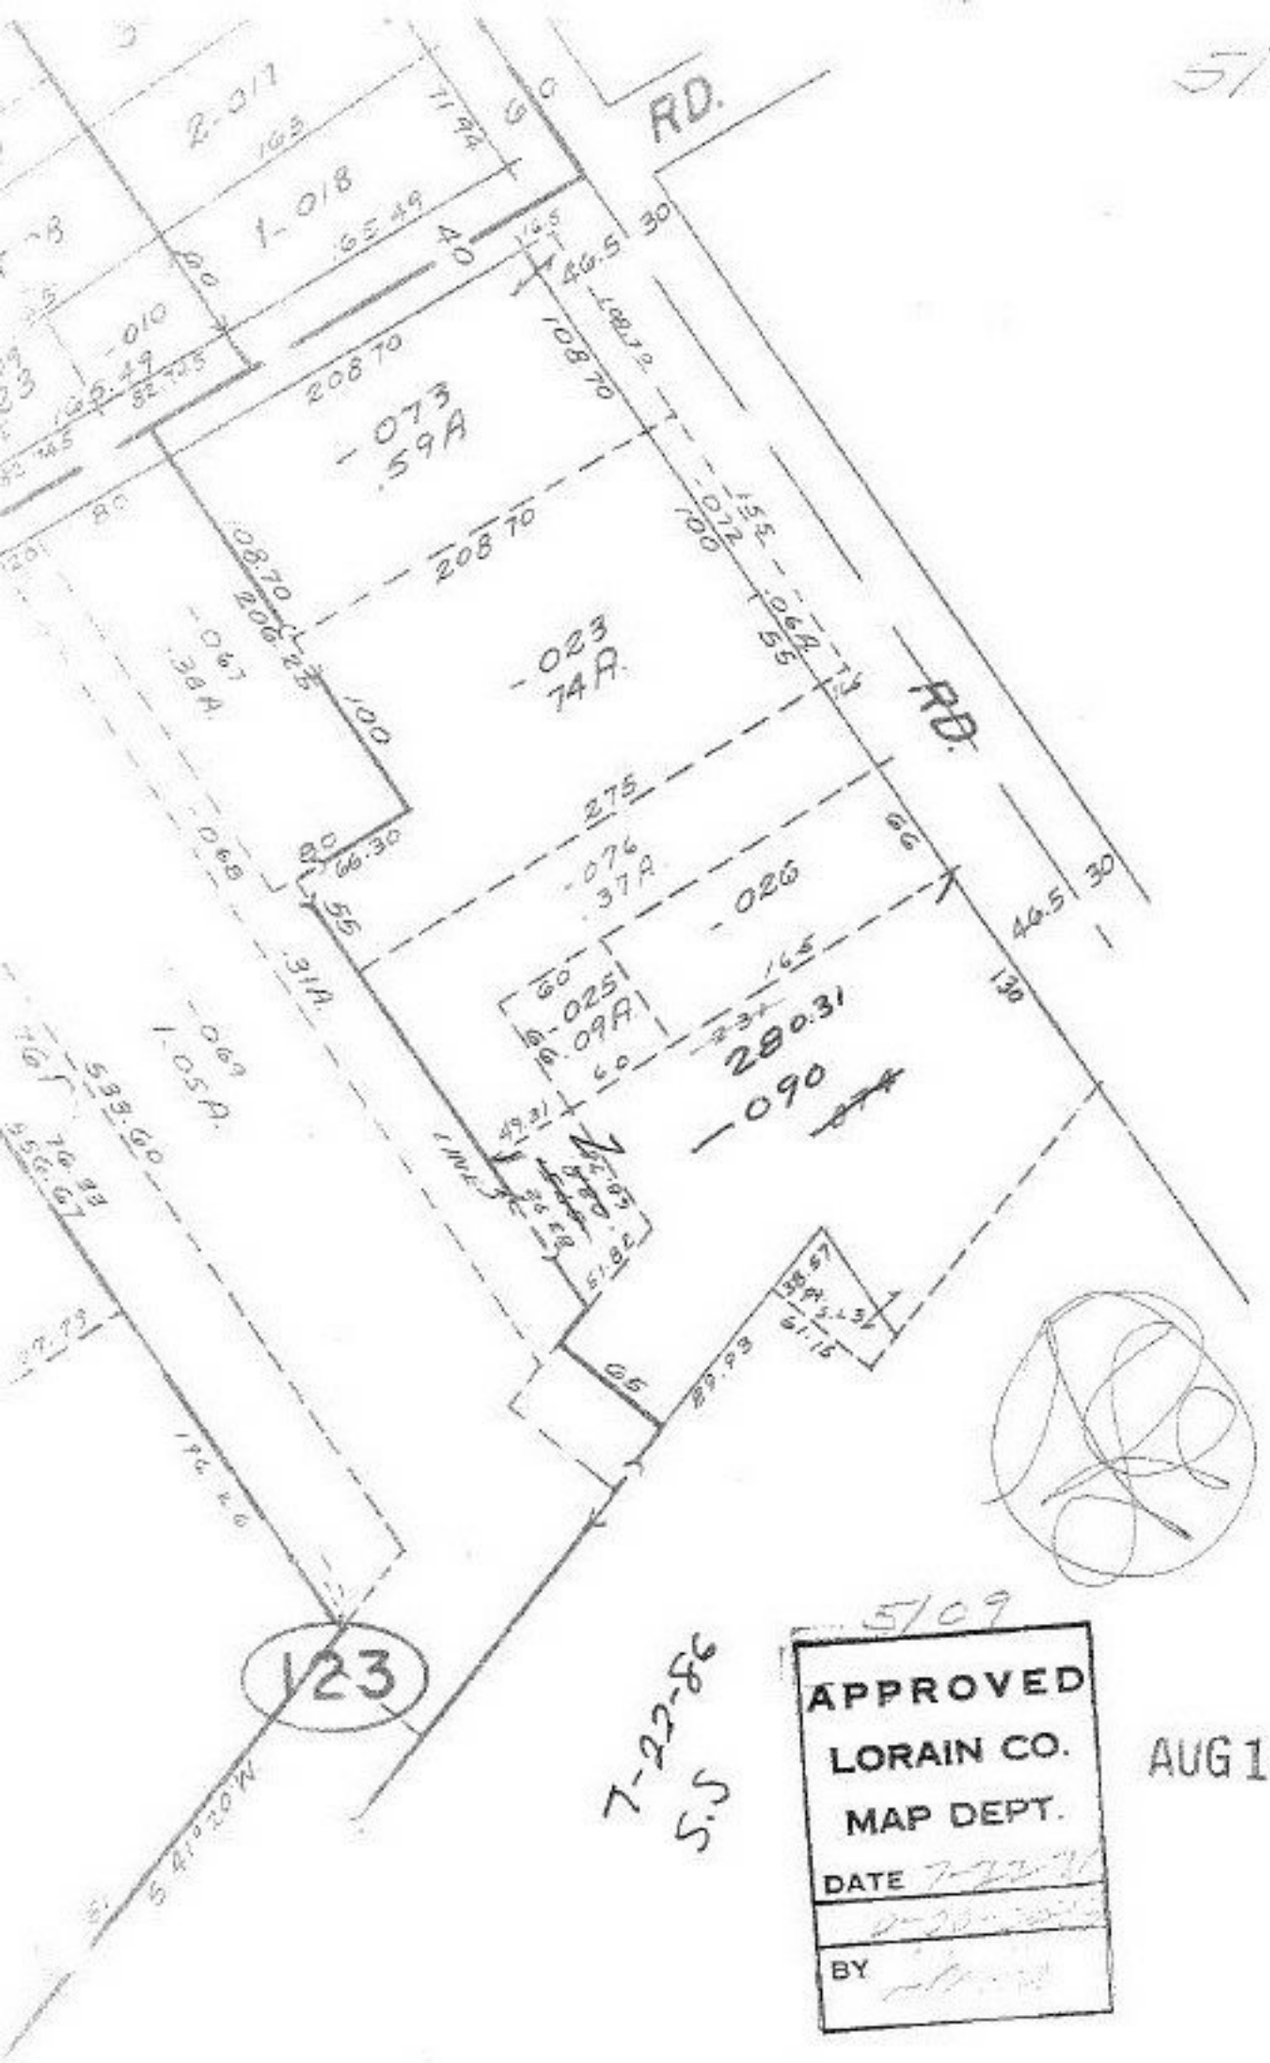
5109
RD.
RD.
2-017
1-018
-010
-073
.59A
208.70
-023
74A
-076
.37A
-026
-025
.09A
280.31
-090
-069
1.05A
-067
.38A
-068
.31A
123
S 41°20'W
5109
7-22-86
S.S
APPROVED
LORAIN CO.
MAP DEPT.
DATE
BY
AUG 10 ENT'D