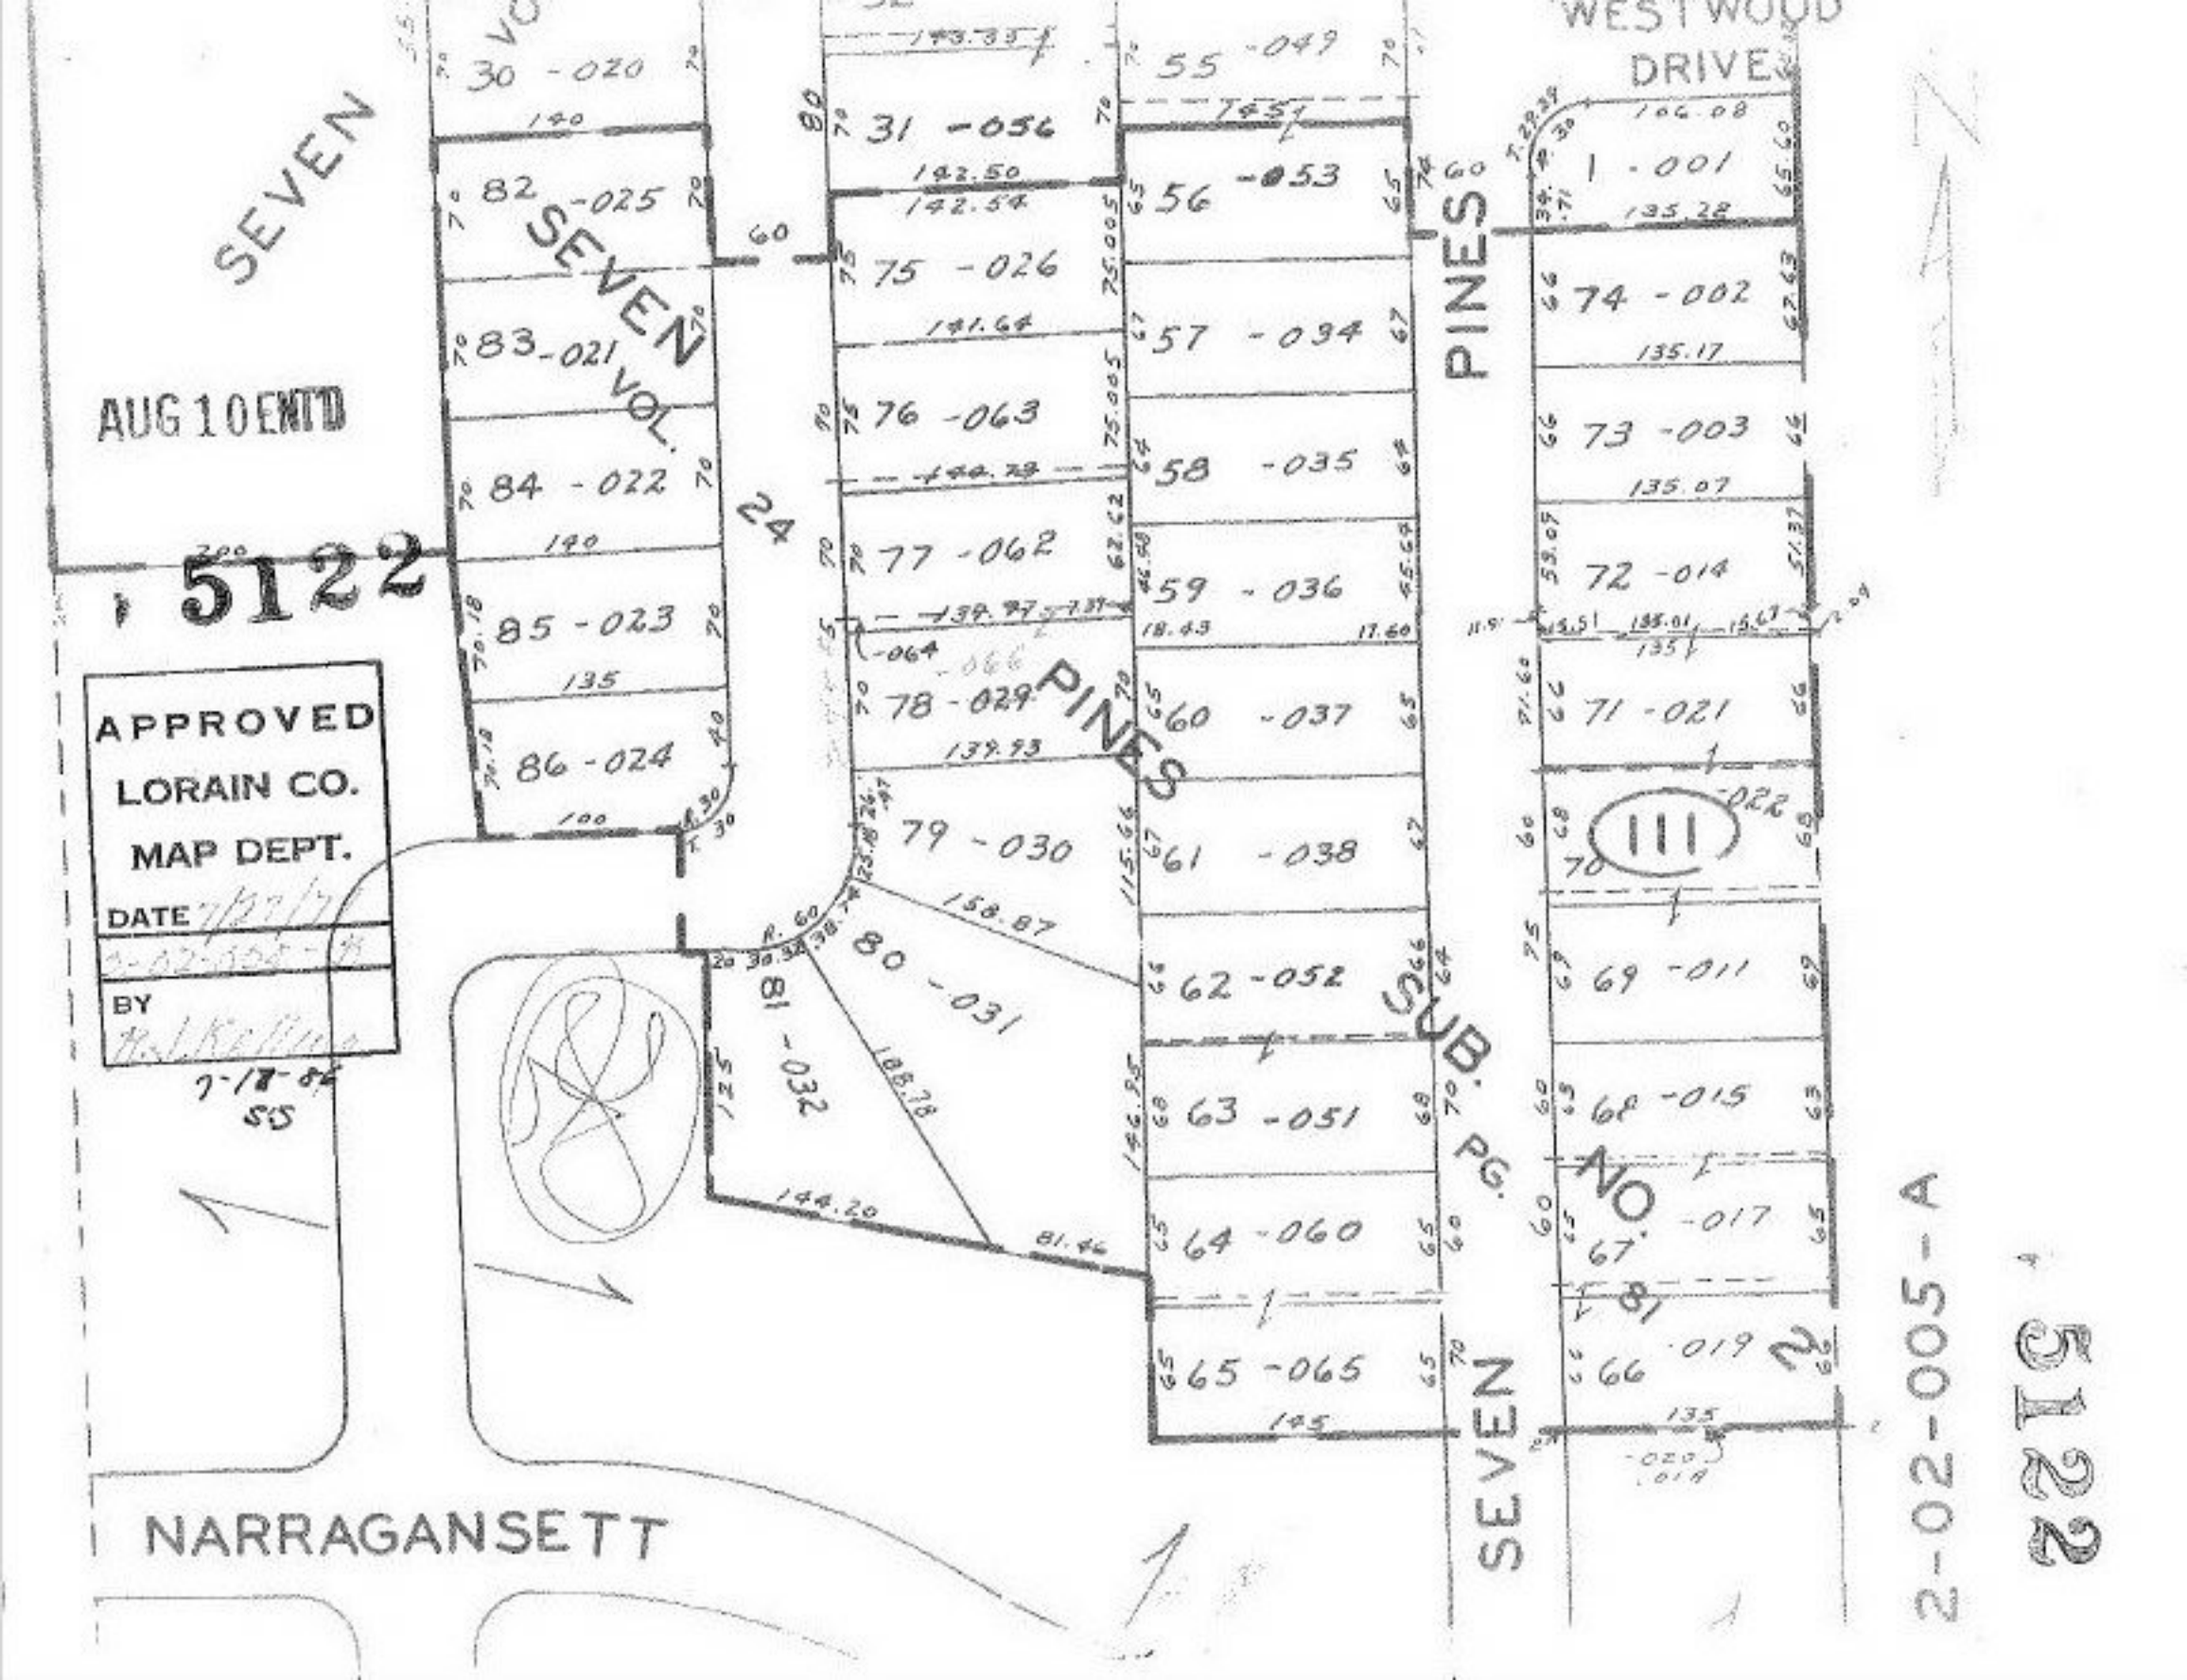

WESTWOOD DRIVE
SEVEN
SEVEN VOL. 24
PINES
PINES SUB. PG. NO. 81
SEVEN
NARRAGANSETT
AUG 10 ENT'D
5122
APPROVED
LORAIN CO.
MAP DEPT.
DATE
BY
7-18-86
SS
30 -020
31 -056
55 -049
82 -025
75 -026
56 -053
1 -001
83 -021
76 -063
57 -034
74 -002
84 -022
77 -062
58 -035
73 -003
85 -023
78 -029
59 -036
72 -014
86 -024
79 -030
60 -037
71 -021
80 -031
61 -038
69 -011
81 -032
62 -052
68 -015
63 -051
64 -060
67 -017
65 -065
66 -019
111
2-02-005-A
5122