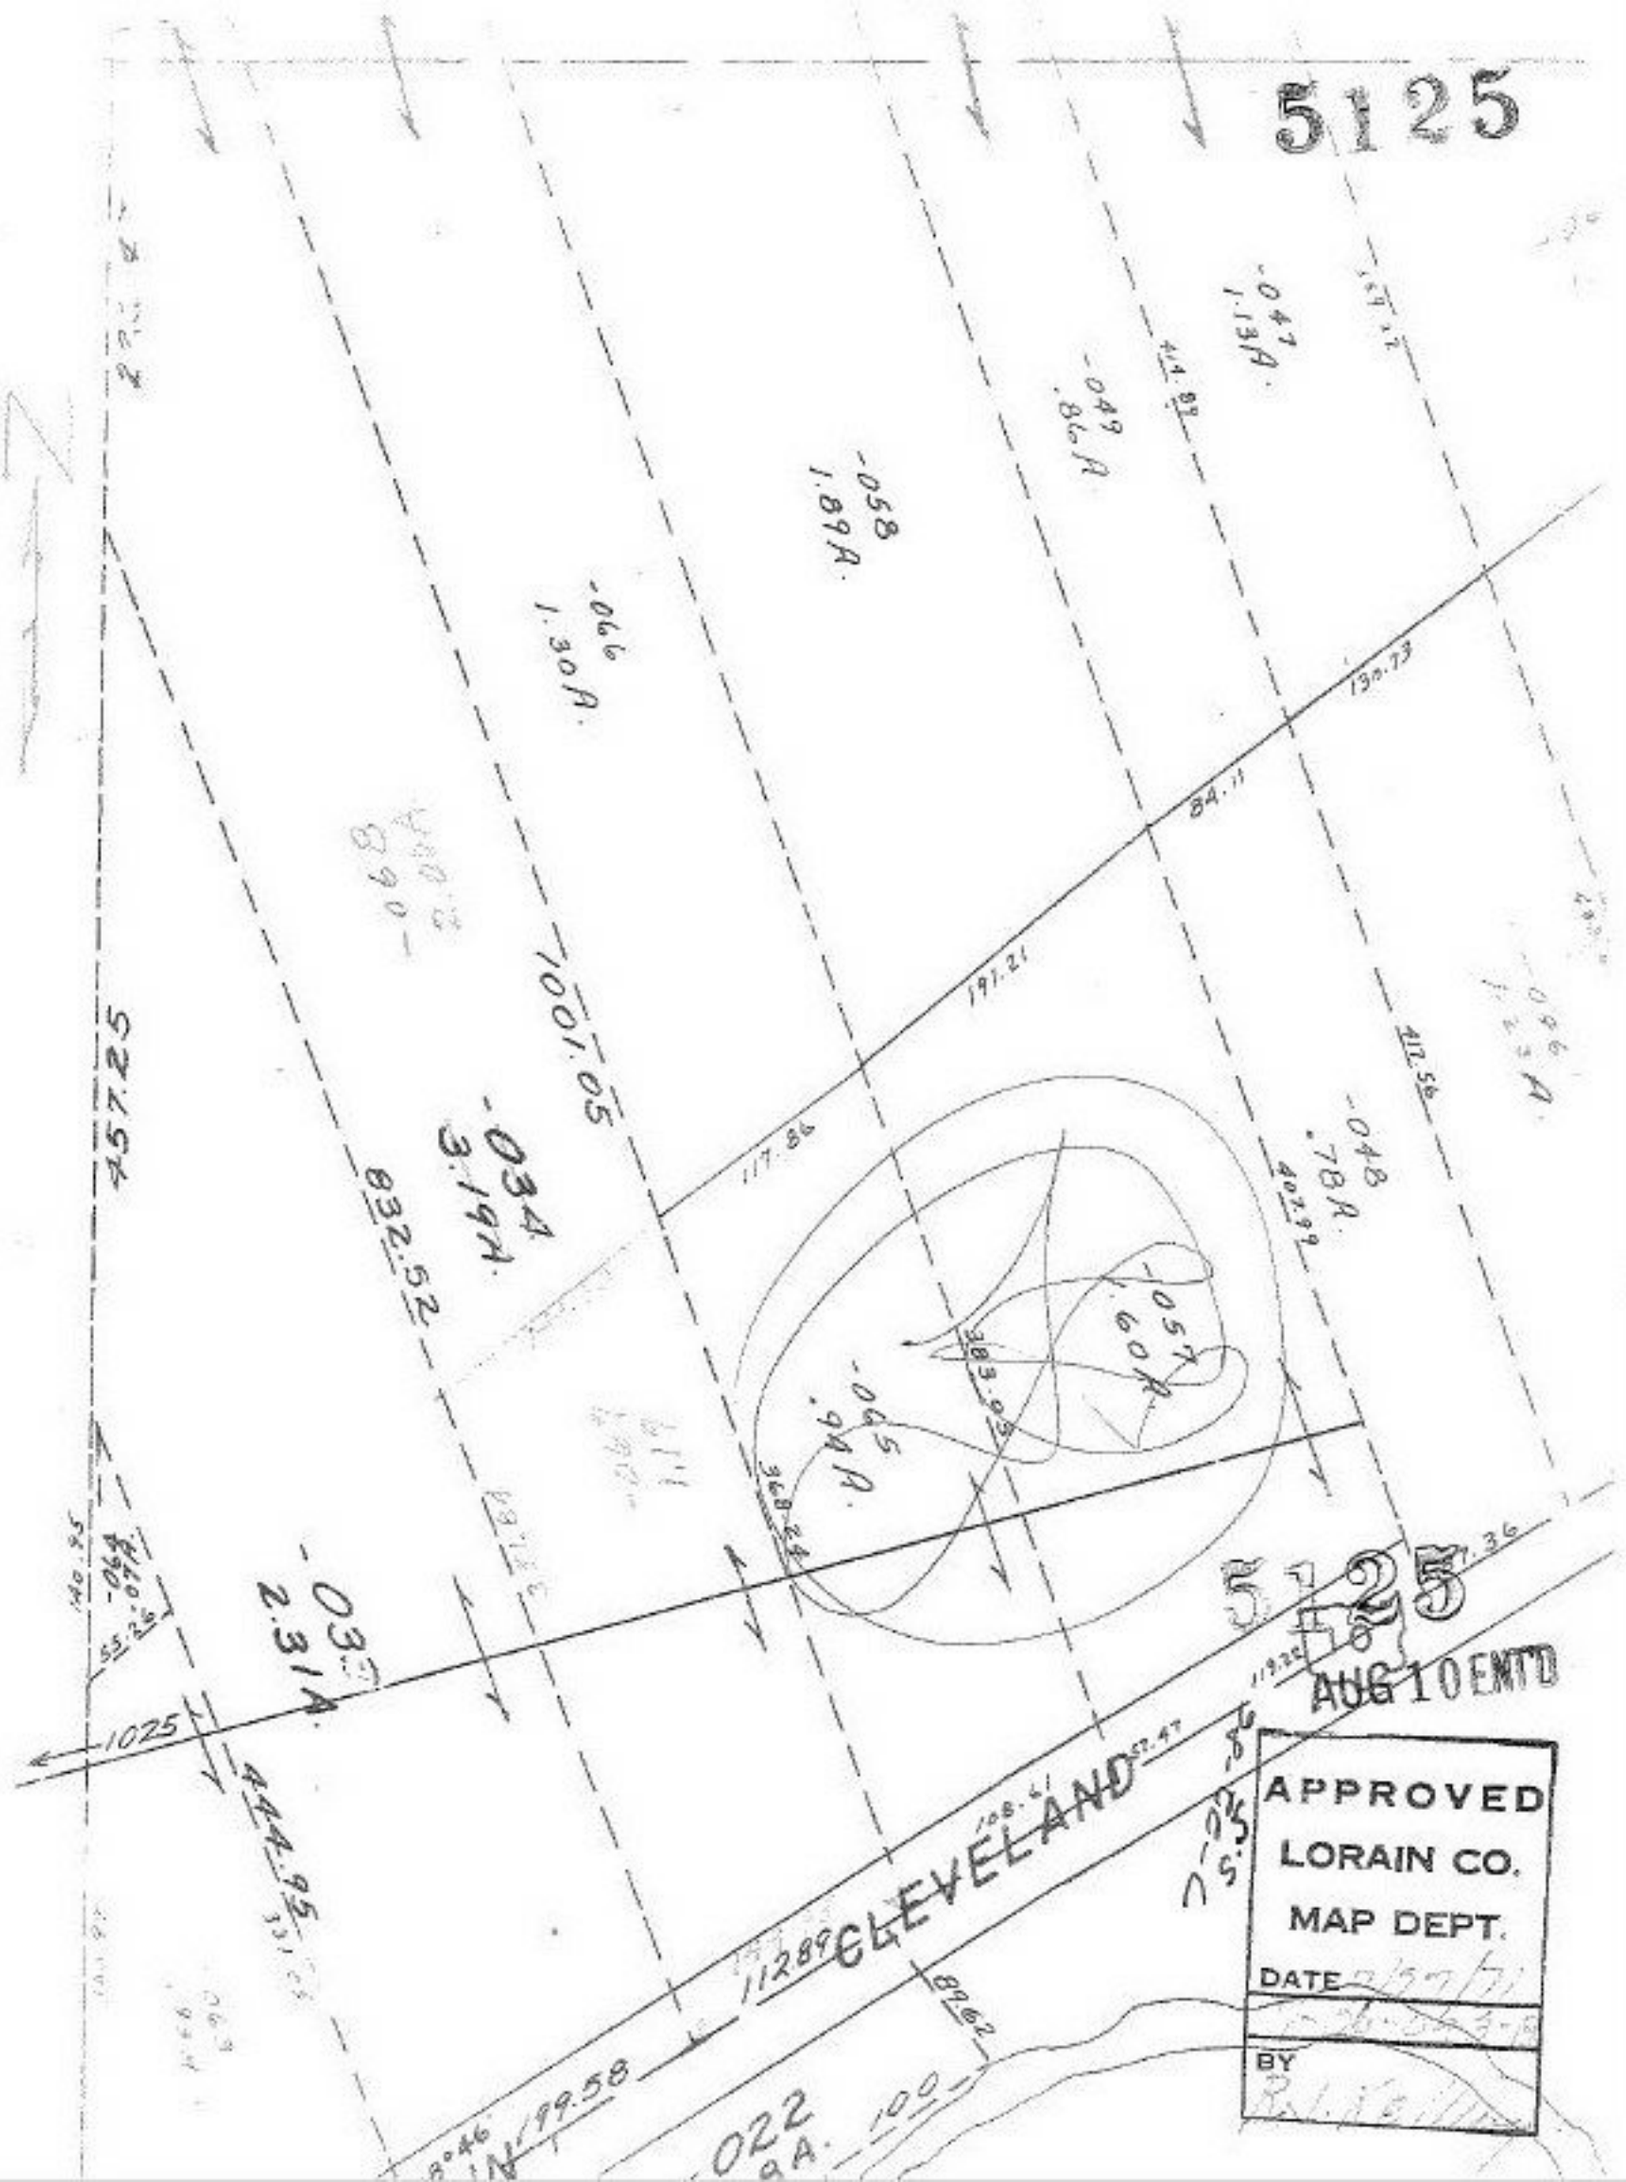
5125
-047
1.13A.
-049
.86A.
-058
1.89A.
-046
1.30A.
1001.05
-034
3.19A.
832.52
45725
-033
2.31A.
444.95
1025
CLEVELAND
1128
-022
-057
.60A.
-048
.78A.
-045
.94A.
383.95
368.24
402.99
412.58
191.21
117.86
84.11
130.73
5125
AUG 10 ENTD
APPROVED
LORAIN CO.
MAP DEPT.
DATE
BY