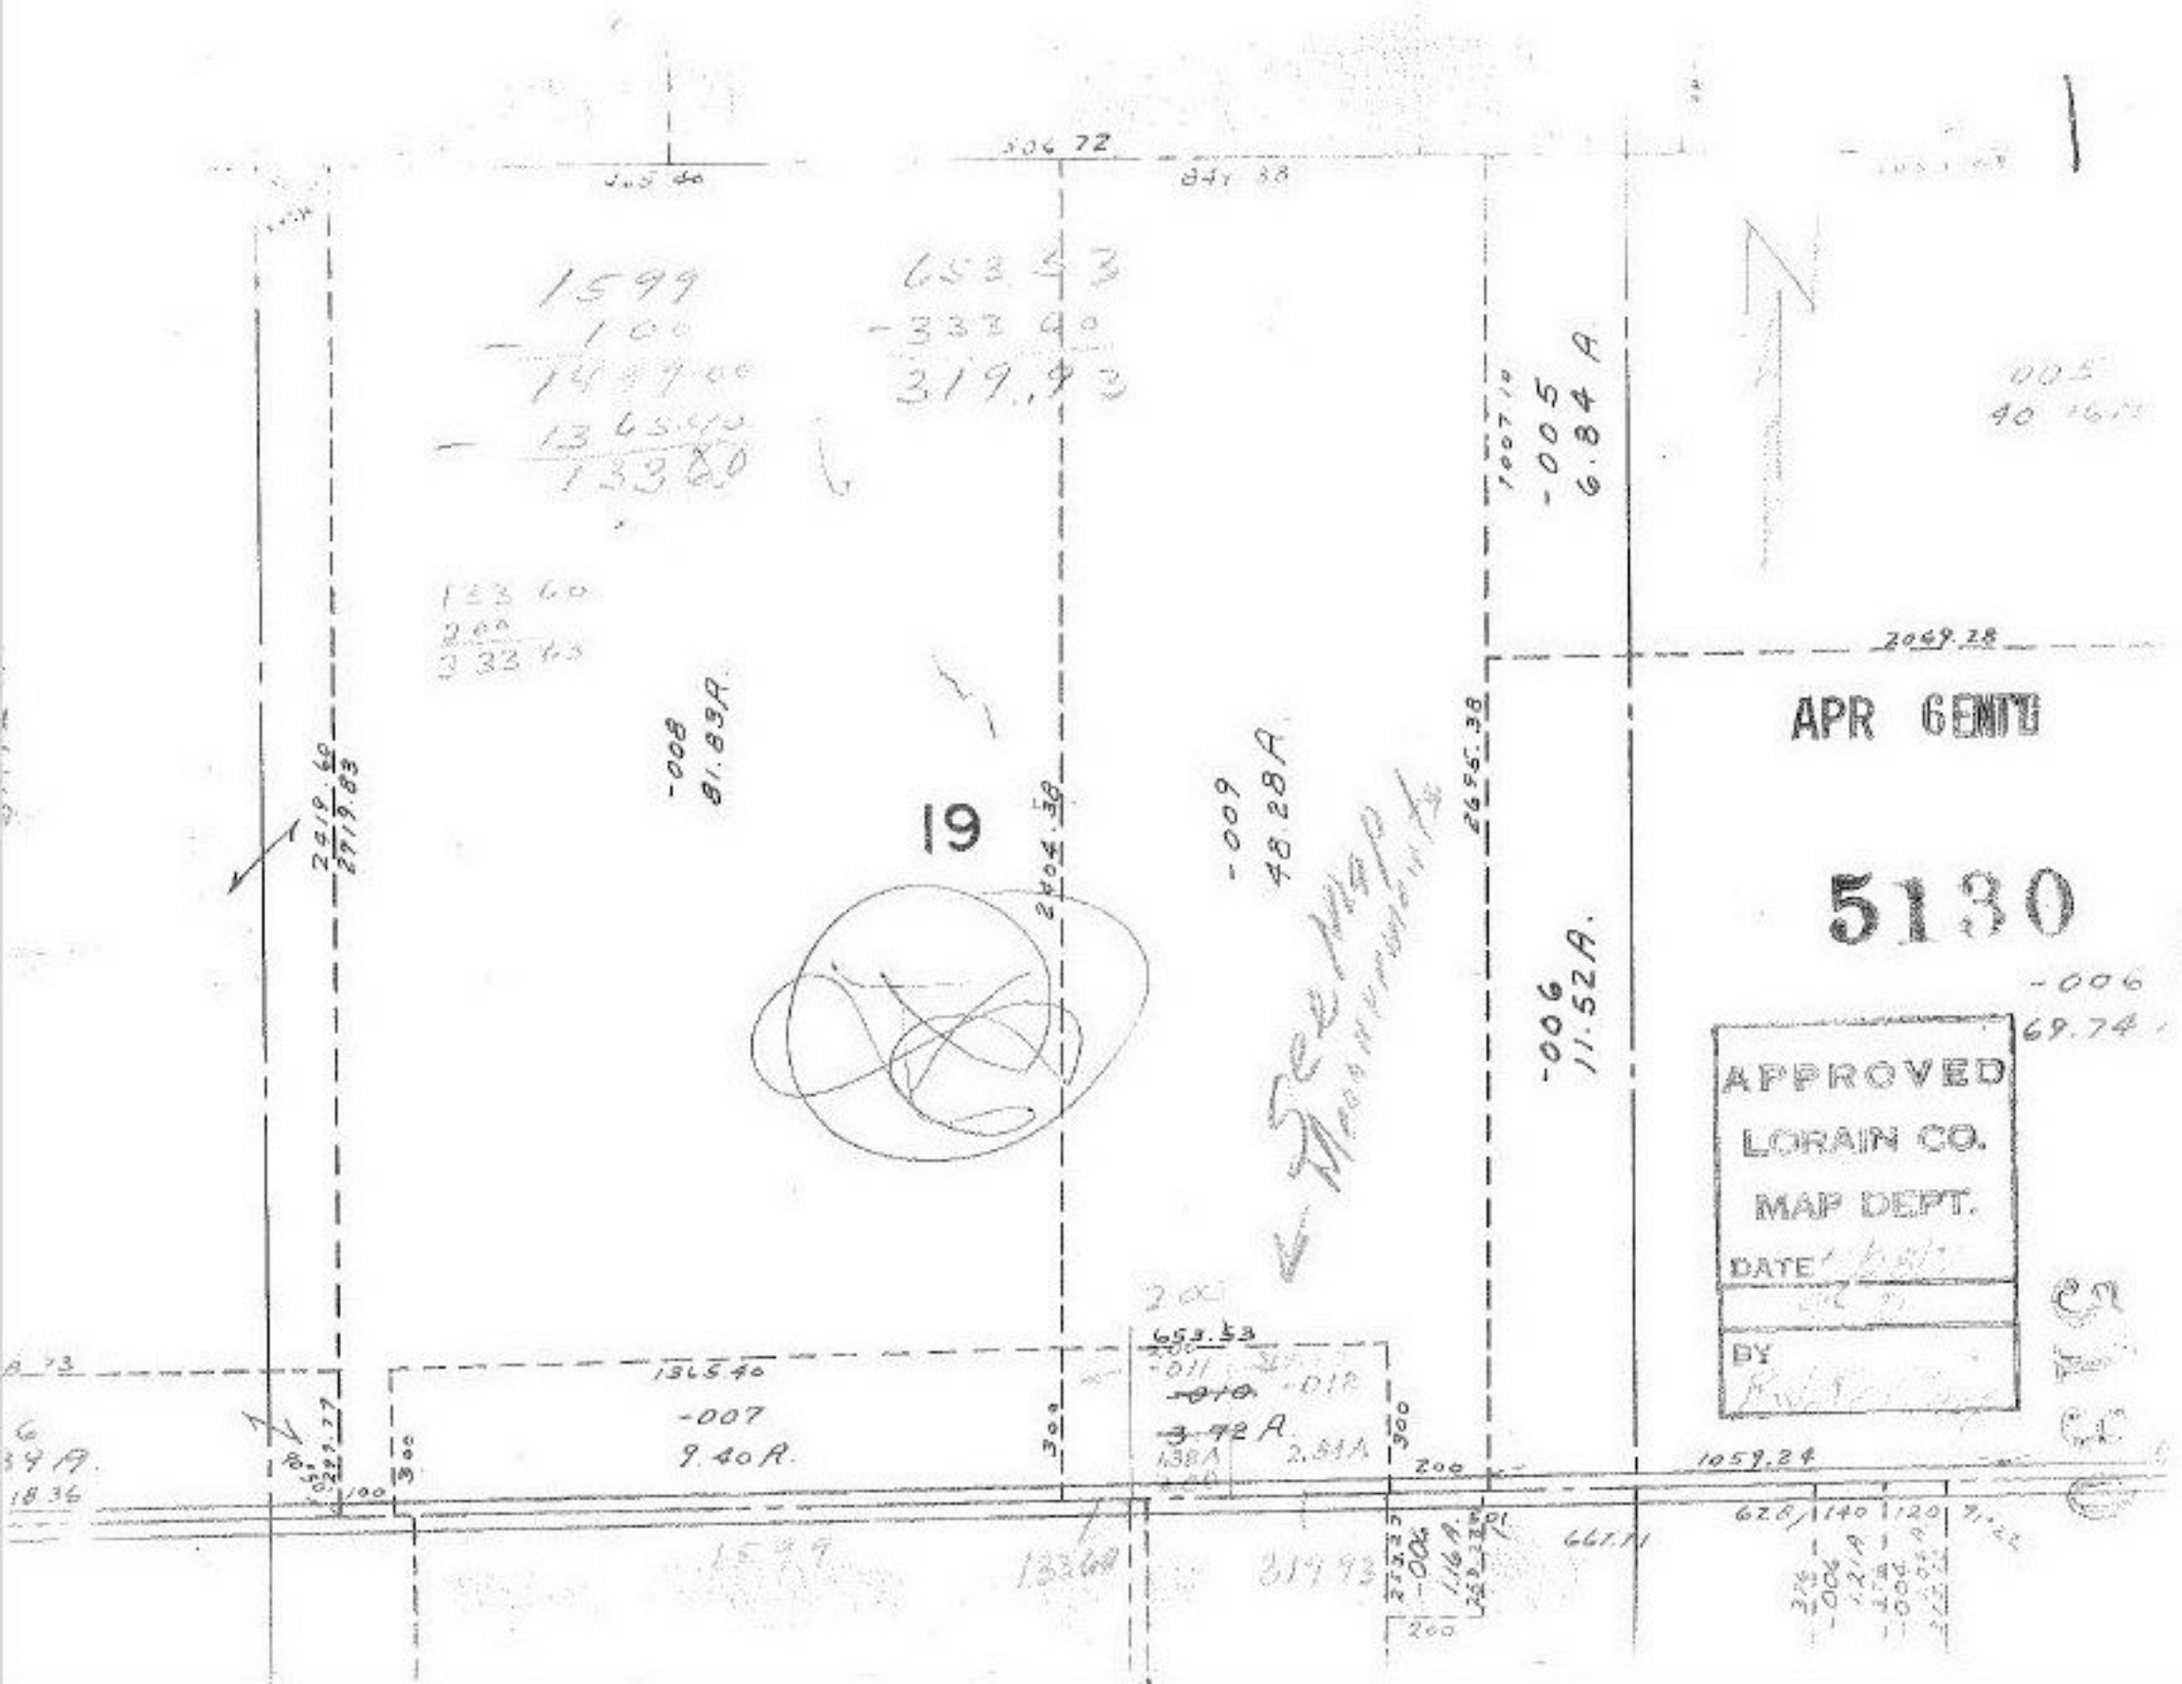
19
-008
81.83A.
-009
48.28A
-005
6.84 A
-006
11.52A.
-007
9.40A.
APR 6 ENTD
5130
APPROVED
LORAIN CO.
MAP DEPT.
DATE
BY
1059.24
2069.28