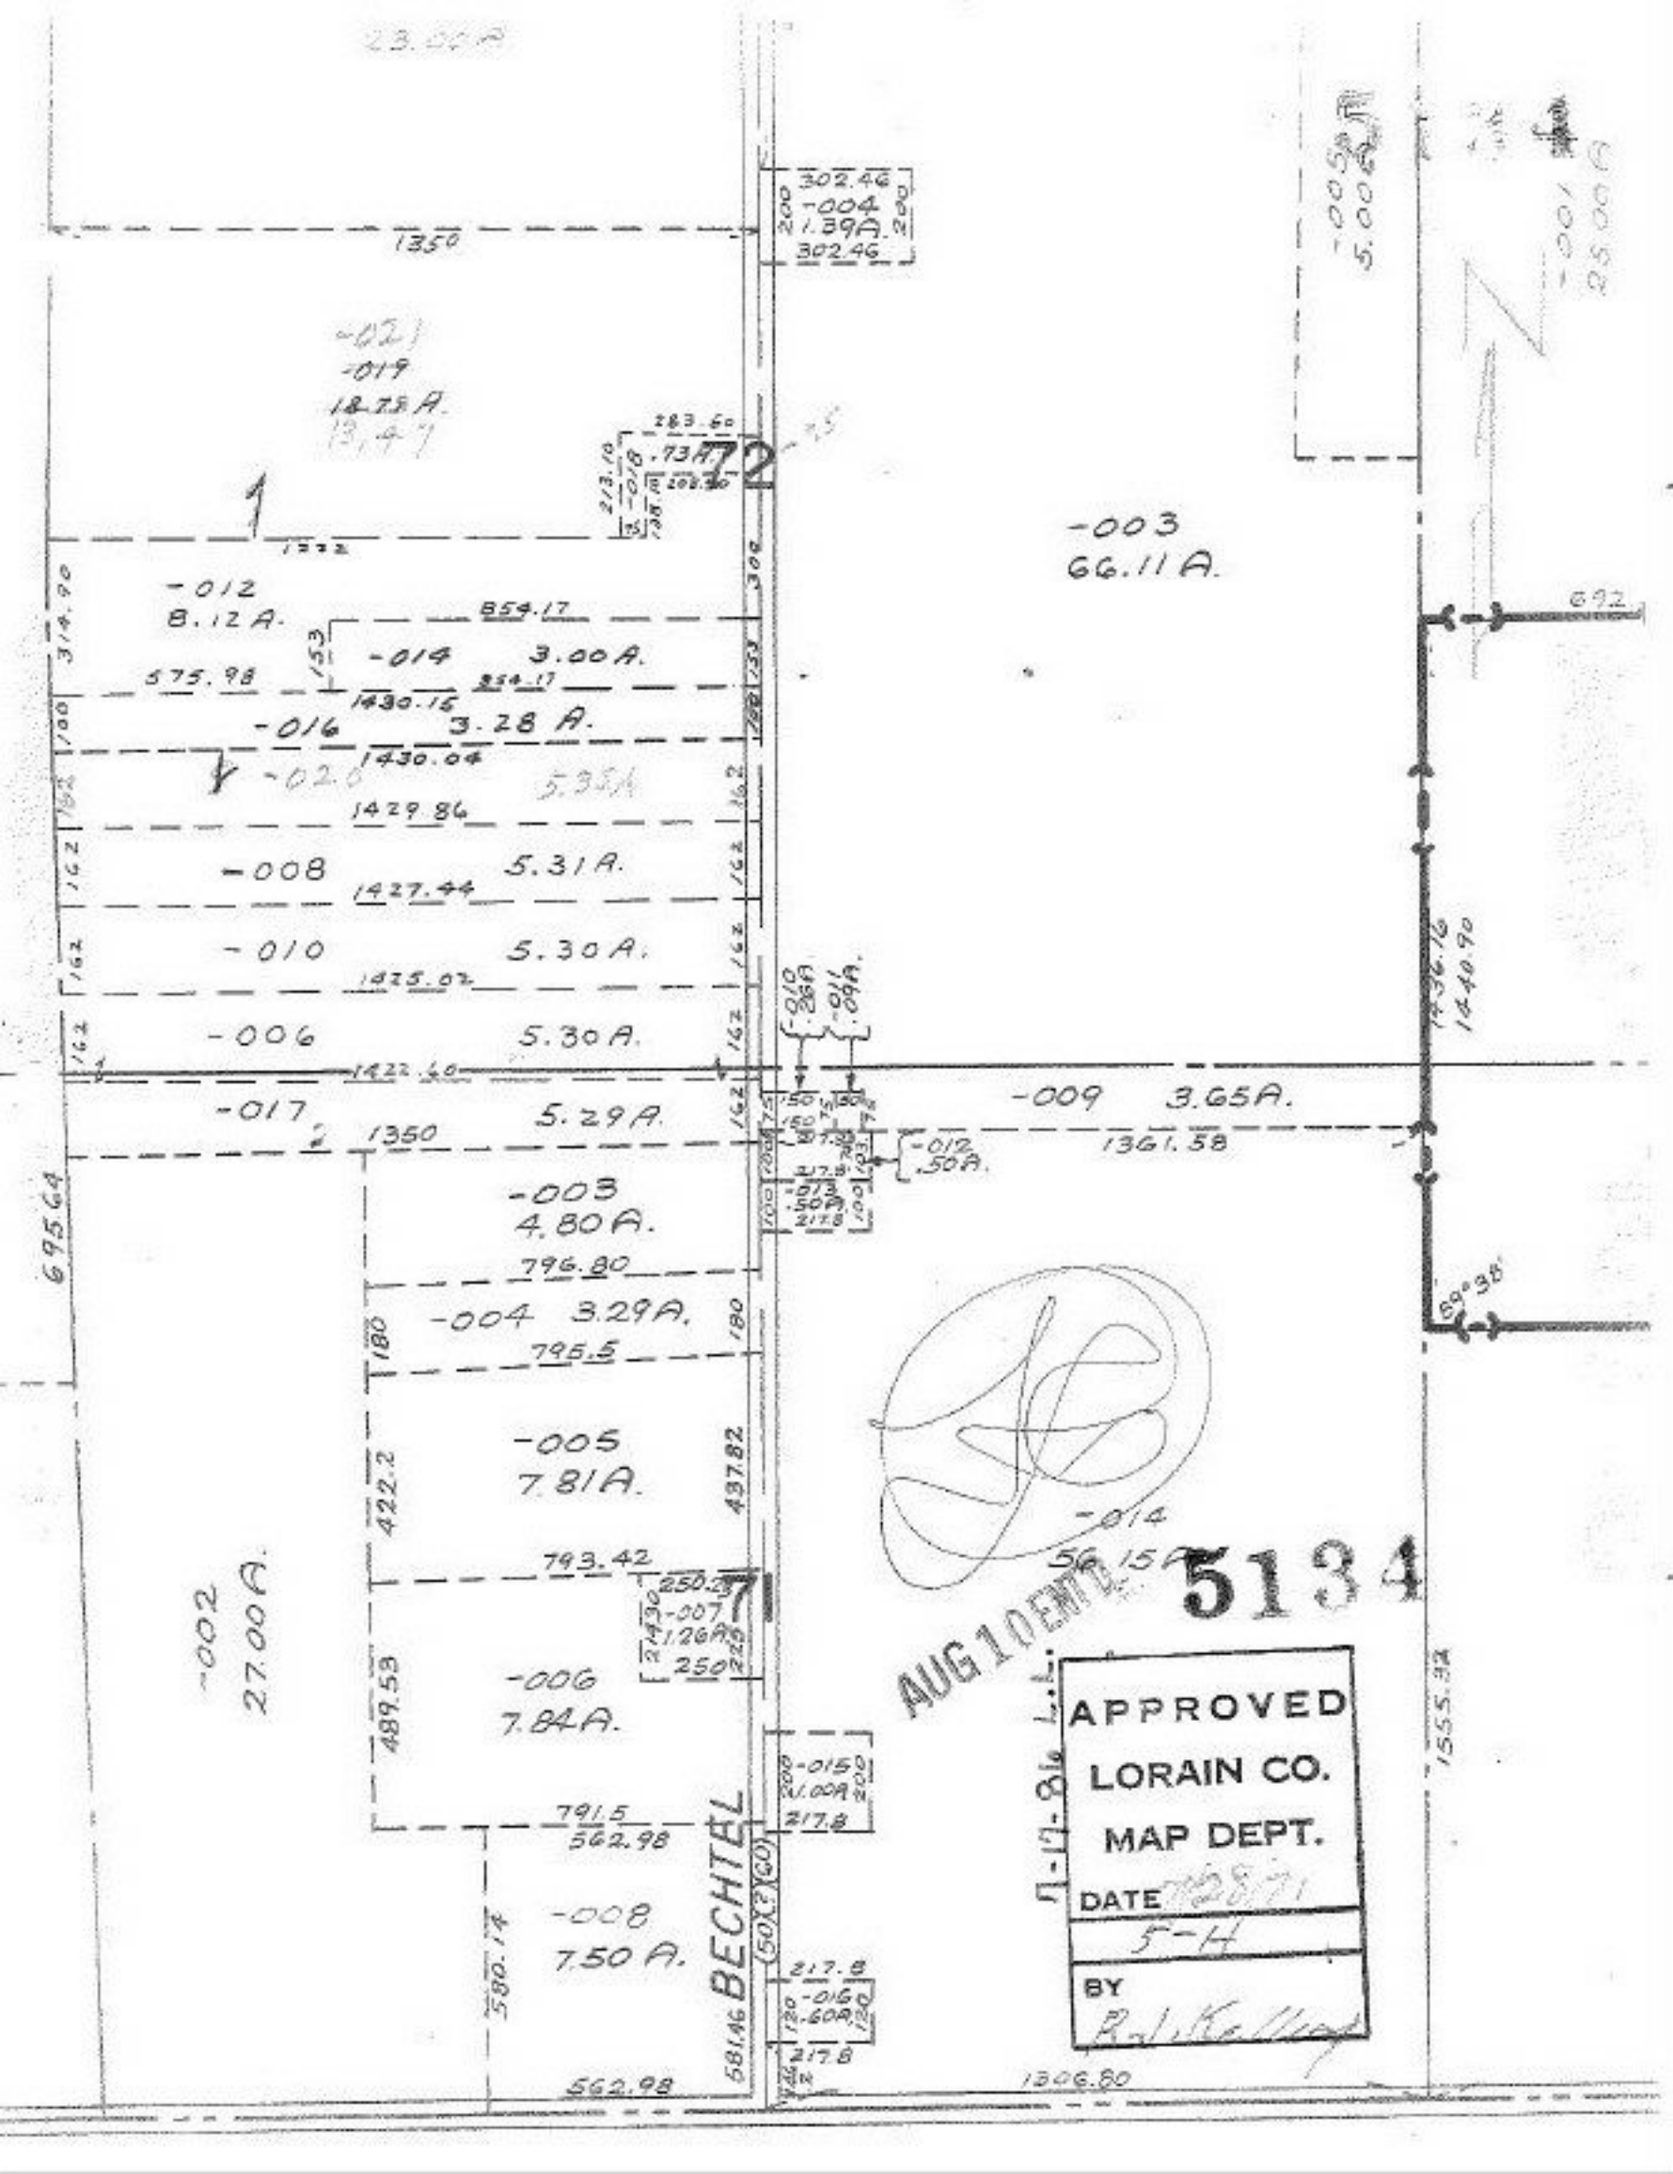
-004
1.39A.
-021
-019
18.75 A.
13.47
-003
66.11 A.
-012
8.12 A.
-014
3.00 A.
-016
3.28 A.
-020
5.35A
-008
5.31 A.
-010
5.30 A.
-006
5.30 A.
-017
5.29 A.
-009
3.65A.
-012
.50A.
-003
4.80 A.
-004
3.29A.
-005
7.81A.
-002
27.00A.
-007
1.26A.
-006
7.84A.
-015
1.09A.
-008
7.50 A.
-016
1.60A.
-014
56.15A.
BECHTAL
AUG 10 ENT.
5134
APPROVED
LORAIN CO.
MAP DEPT.
DATE 8.8.71
5-H
BY