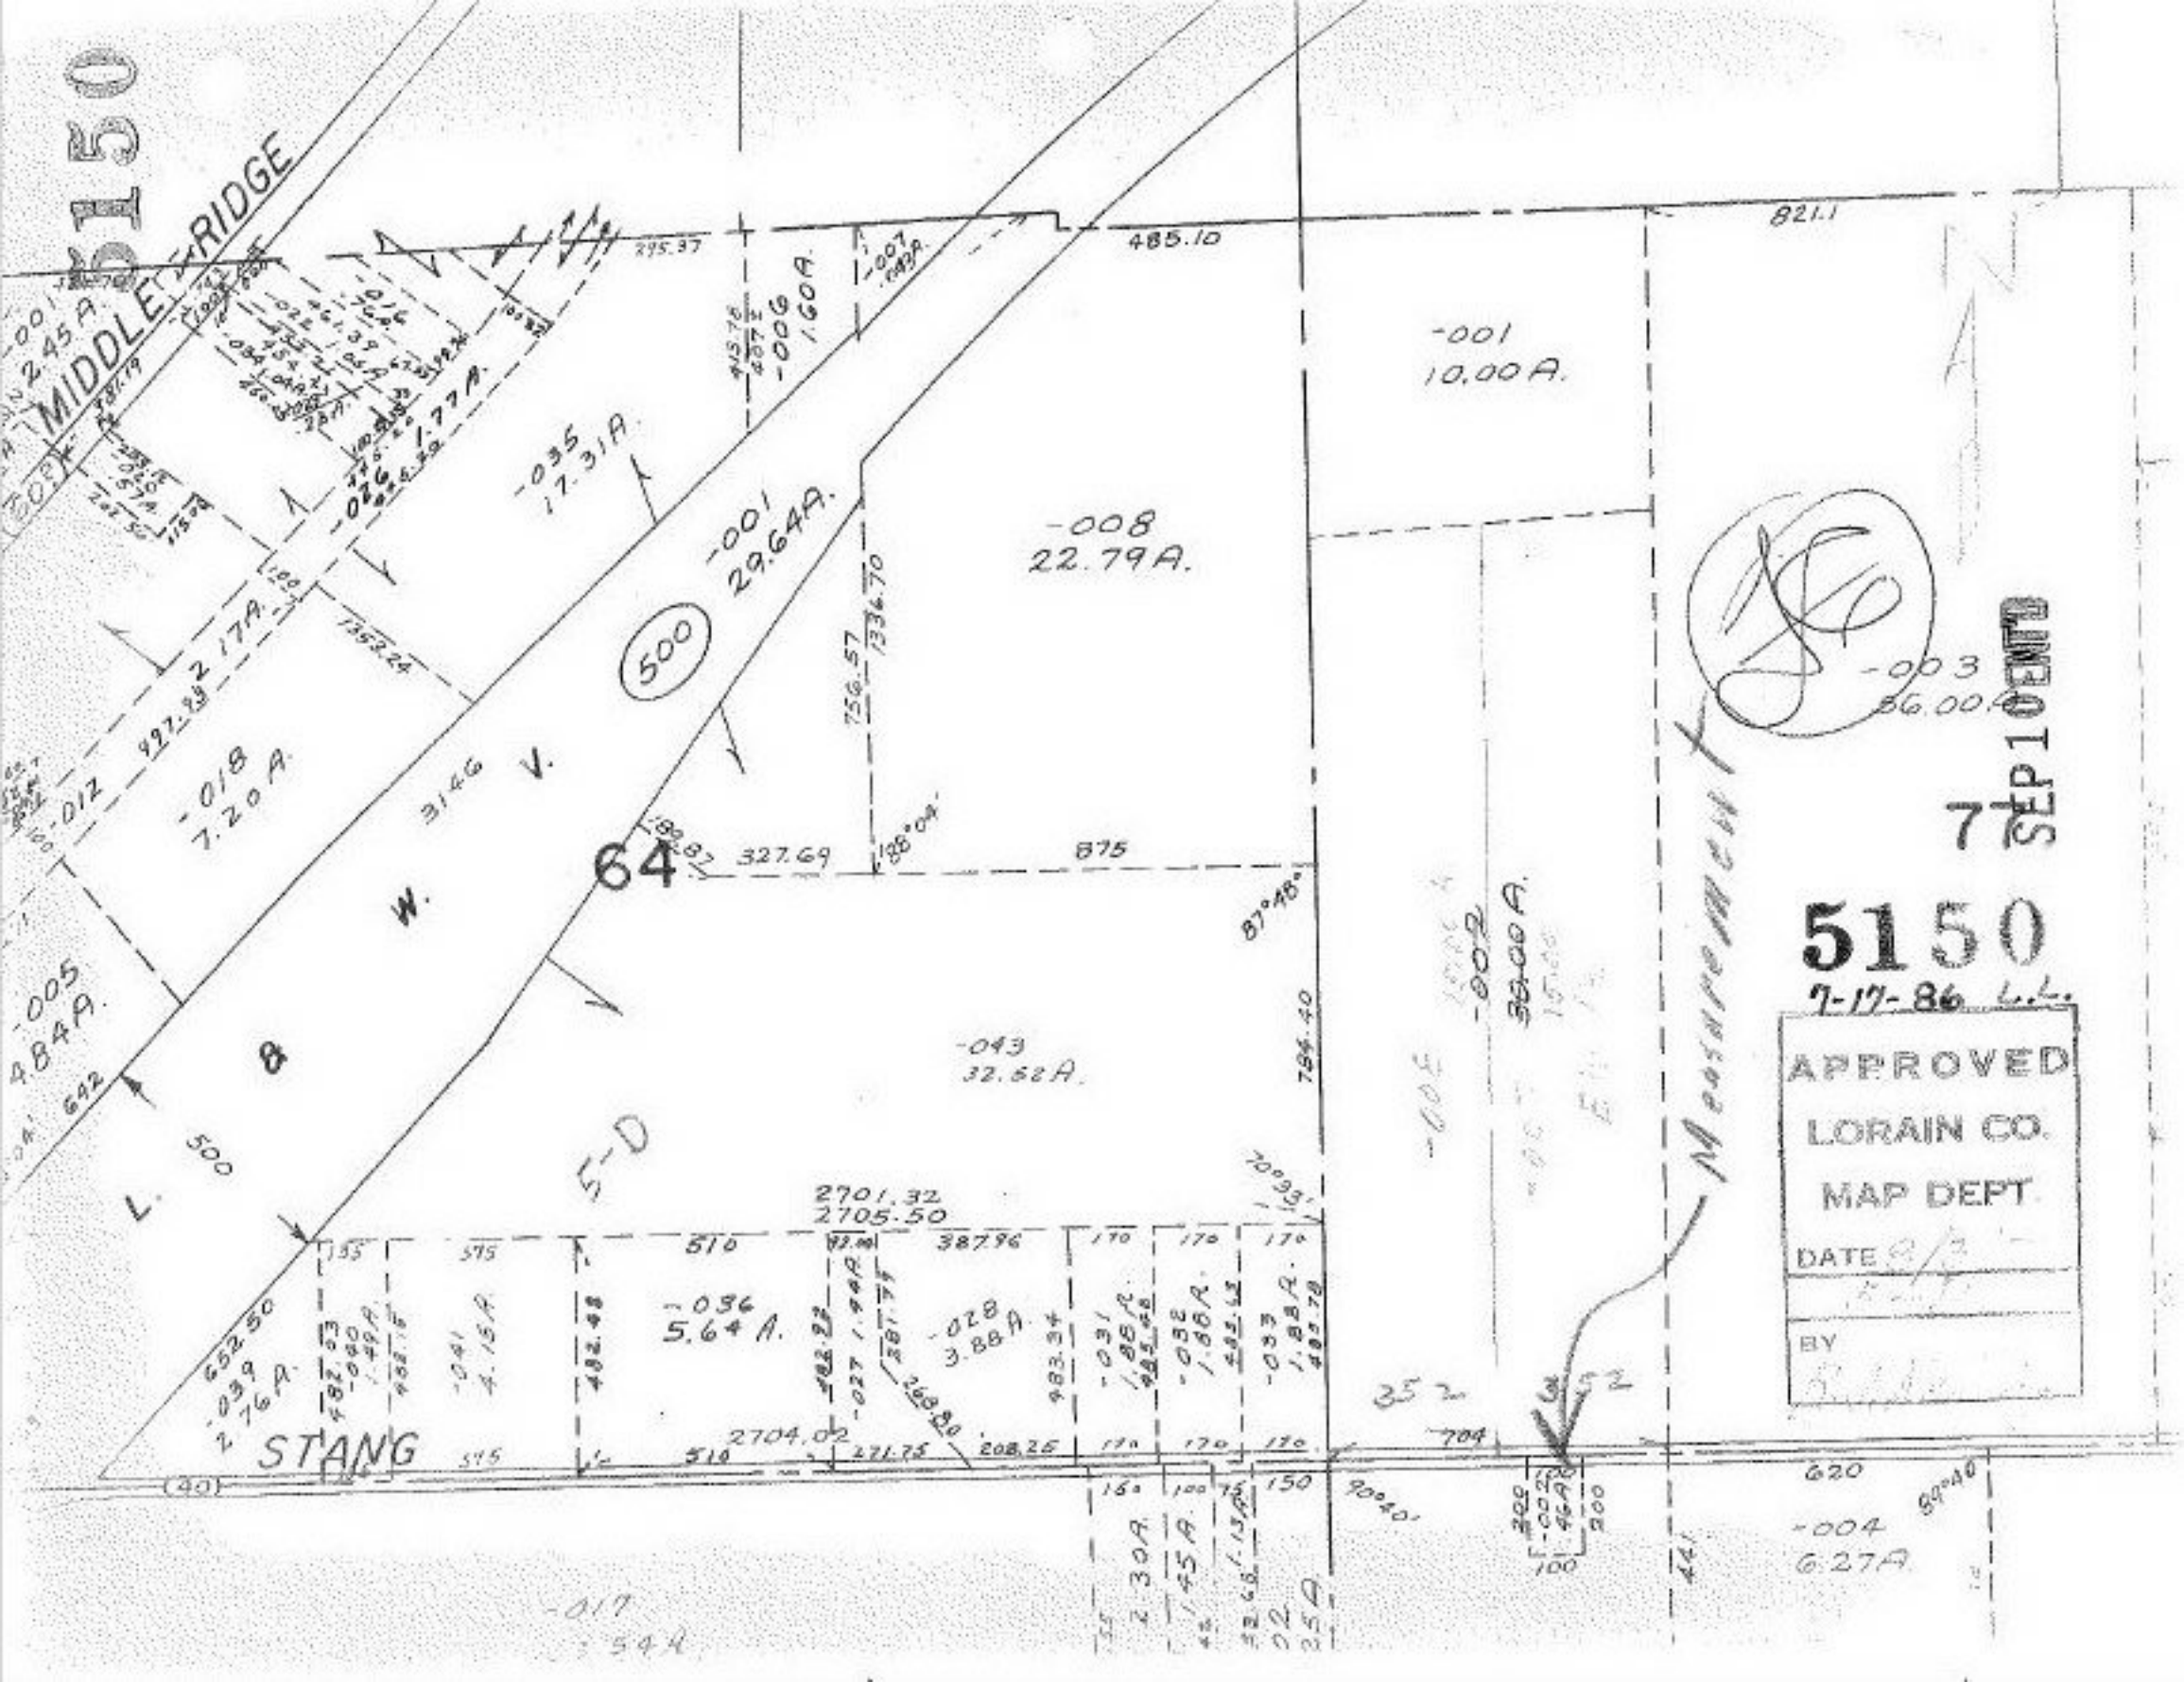
MIDDLE RIDGE
-001
2.45A.
-022
-014
-024
-025
-026
1.77A.
-035
17.31A.
-001
29.64A.
-008
22.79A.
-001
10.00A.
-003
86.00A.
-018
7.20A.
-012
-005
4.84A.
-043
32.52A.
-002
39.00A.
-039
2.76A.
-041
4.15A.
-036
5.64A.
-028
3.88A.
-031
1.88A.
-032
1.86A.
-033
1.88A.
-004
6.27A.
-017
5.44A.
2.30A.
1.45A.
500
64
W.
V.
3146
L.
8
S-D
STANG
M
SEP 10 1986
7
5150
7-17-86
APPROVED
LORAIN CO.
MAP DEPT.
DATE
BY