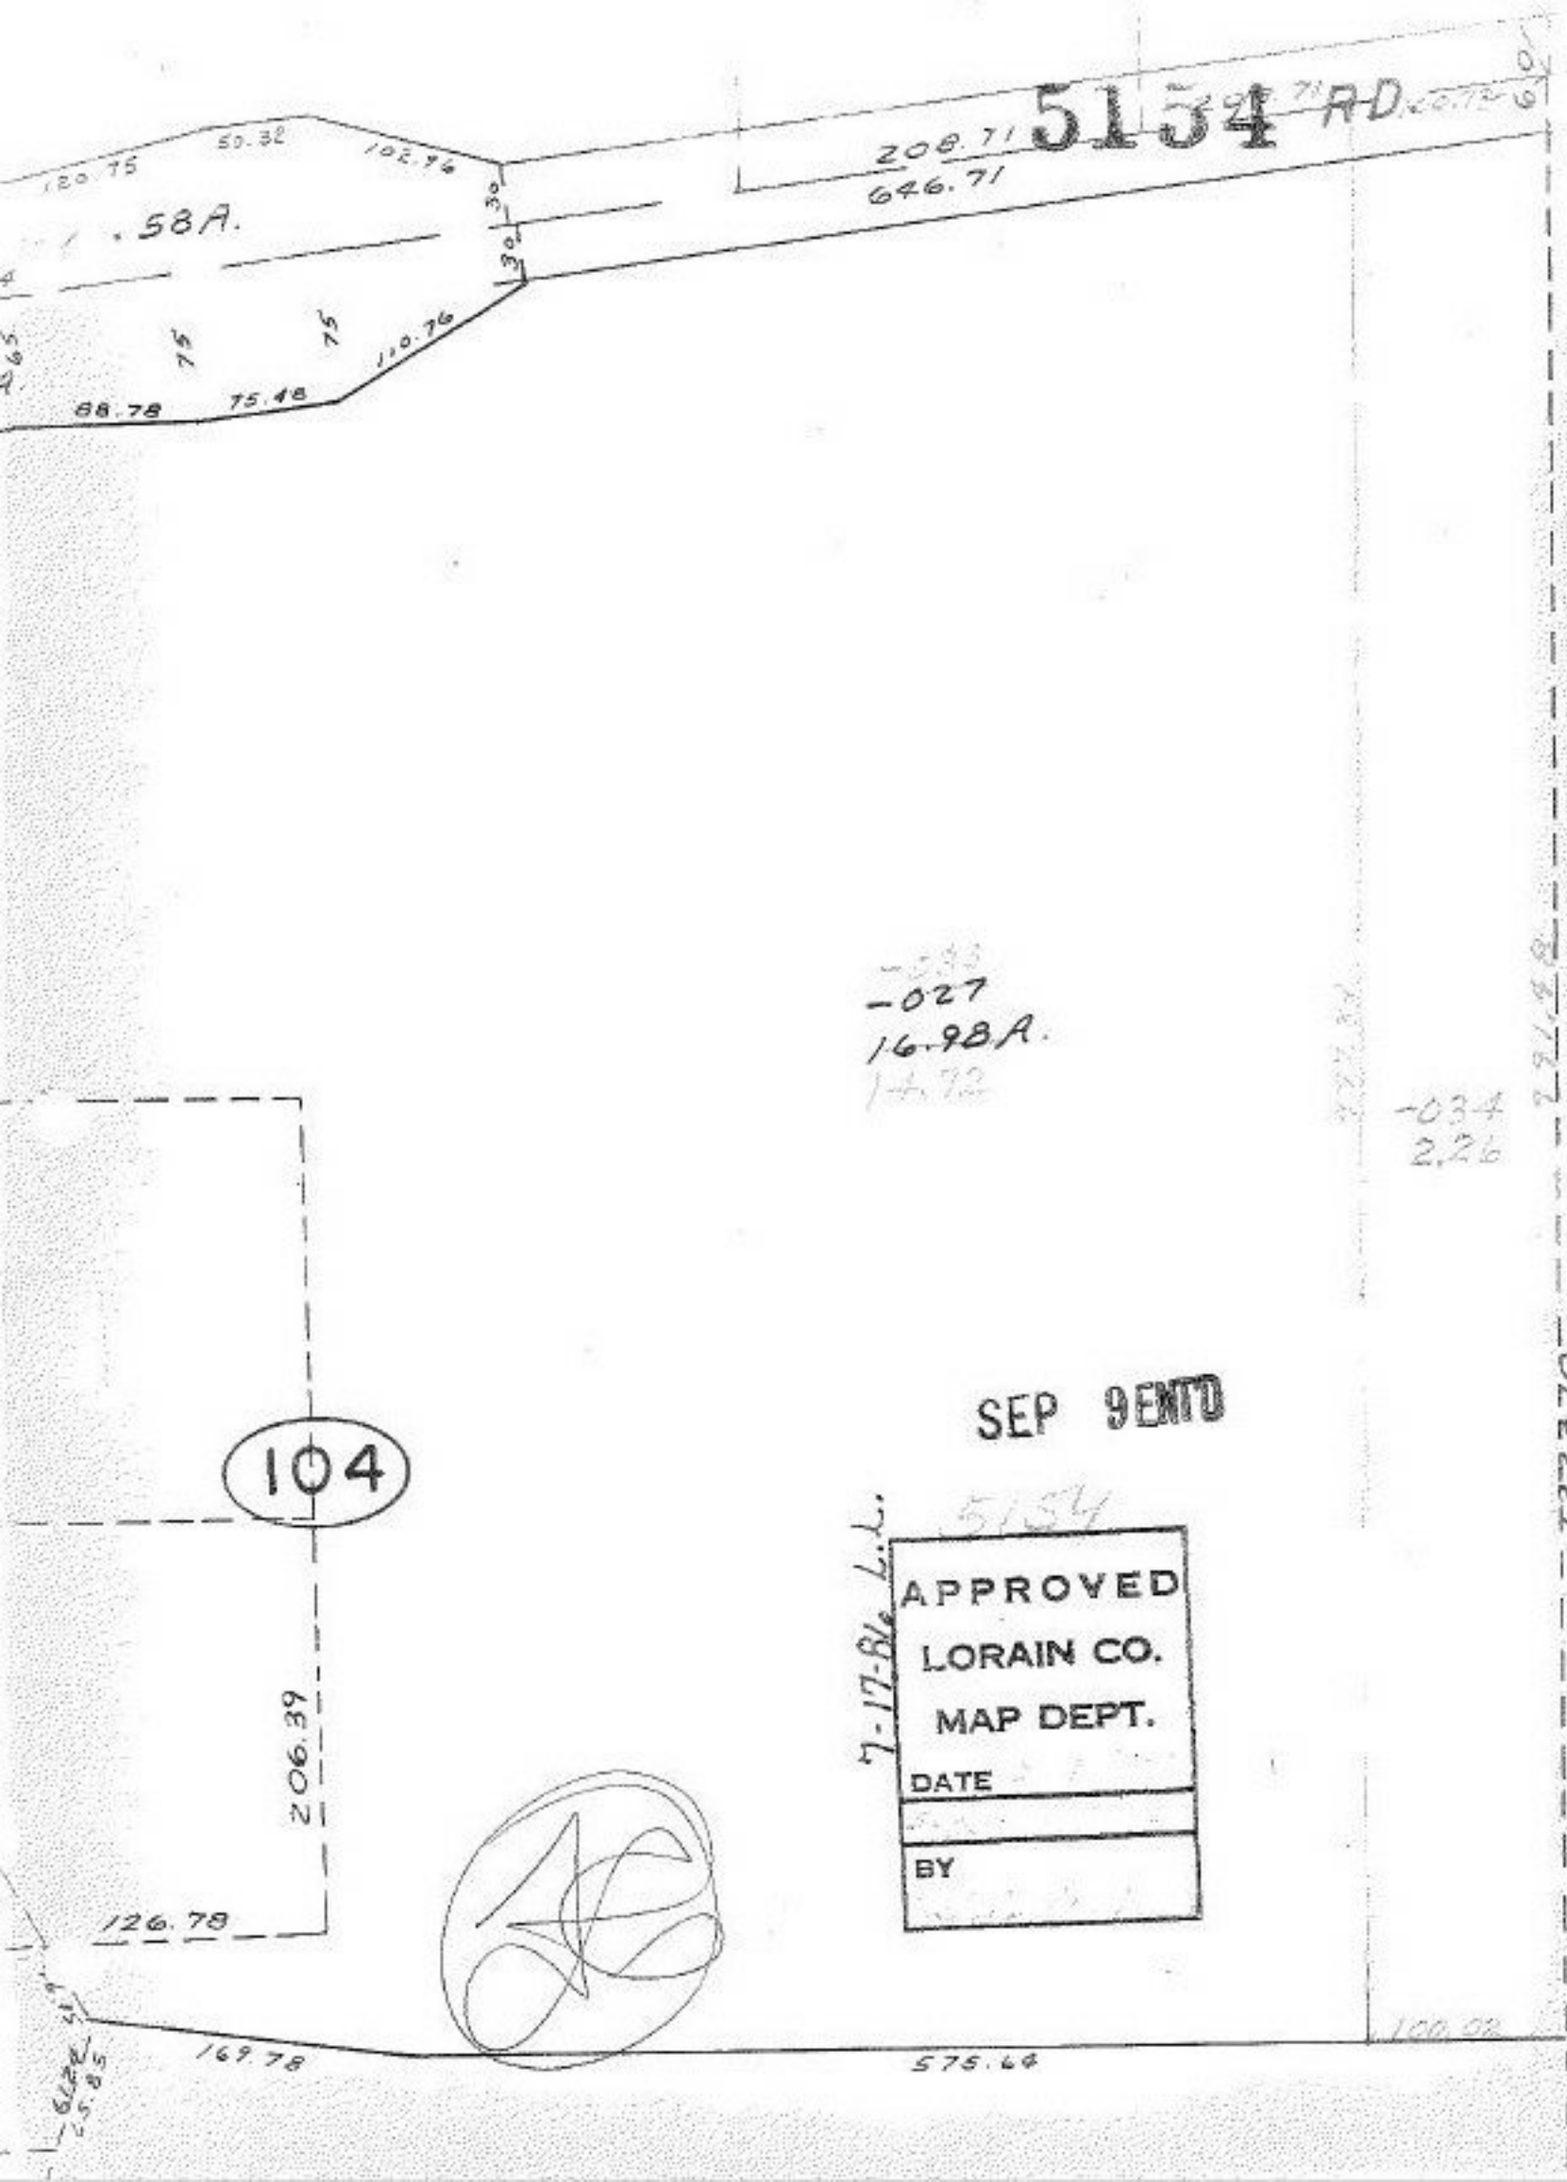
5154 RD.
208.71
646.71
120.75
50.32
102.76
.58A.
30
30
75
75
110.76
88.78
75.48
-027
16.98A.
14.72
-034
2.26
104
206.39
126.78
169.78
575.64
100.02
7223.70
SEP 9 ENT'D
5154
7-17-86 L.L.
APPROVED
LORAIN CO.
MAP DEPT.
DATE
BY