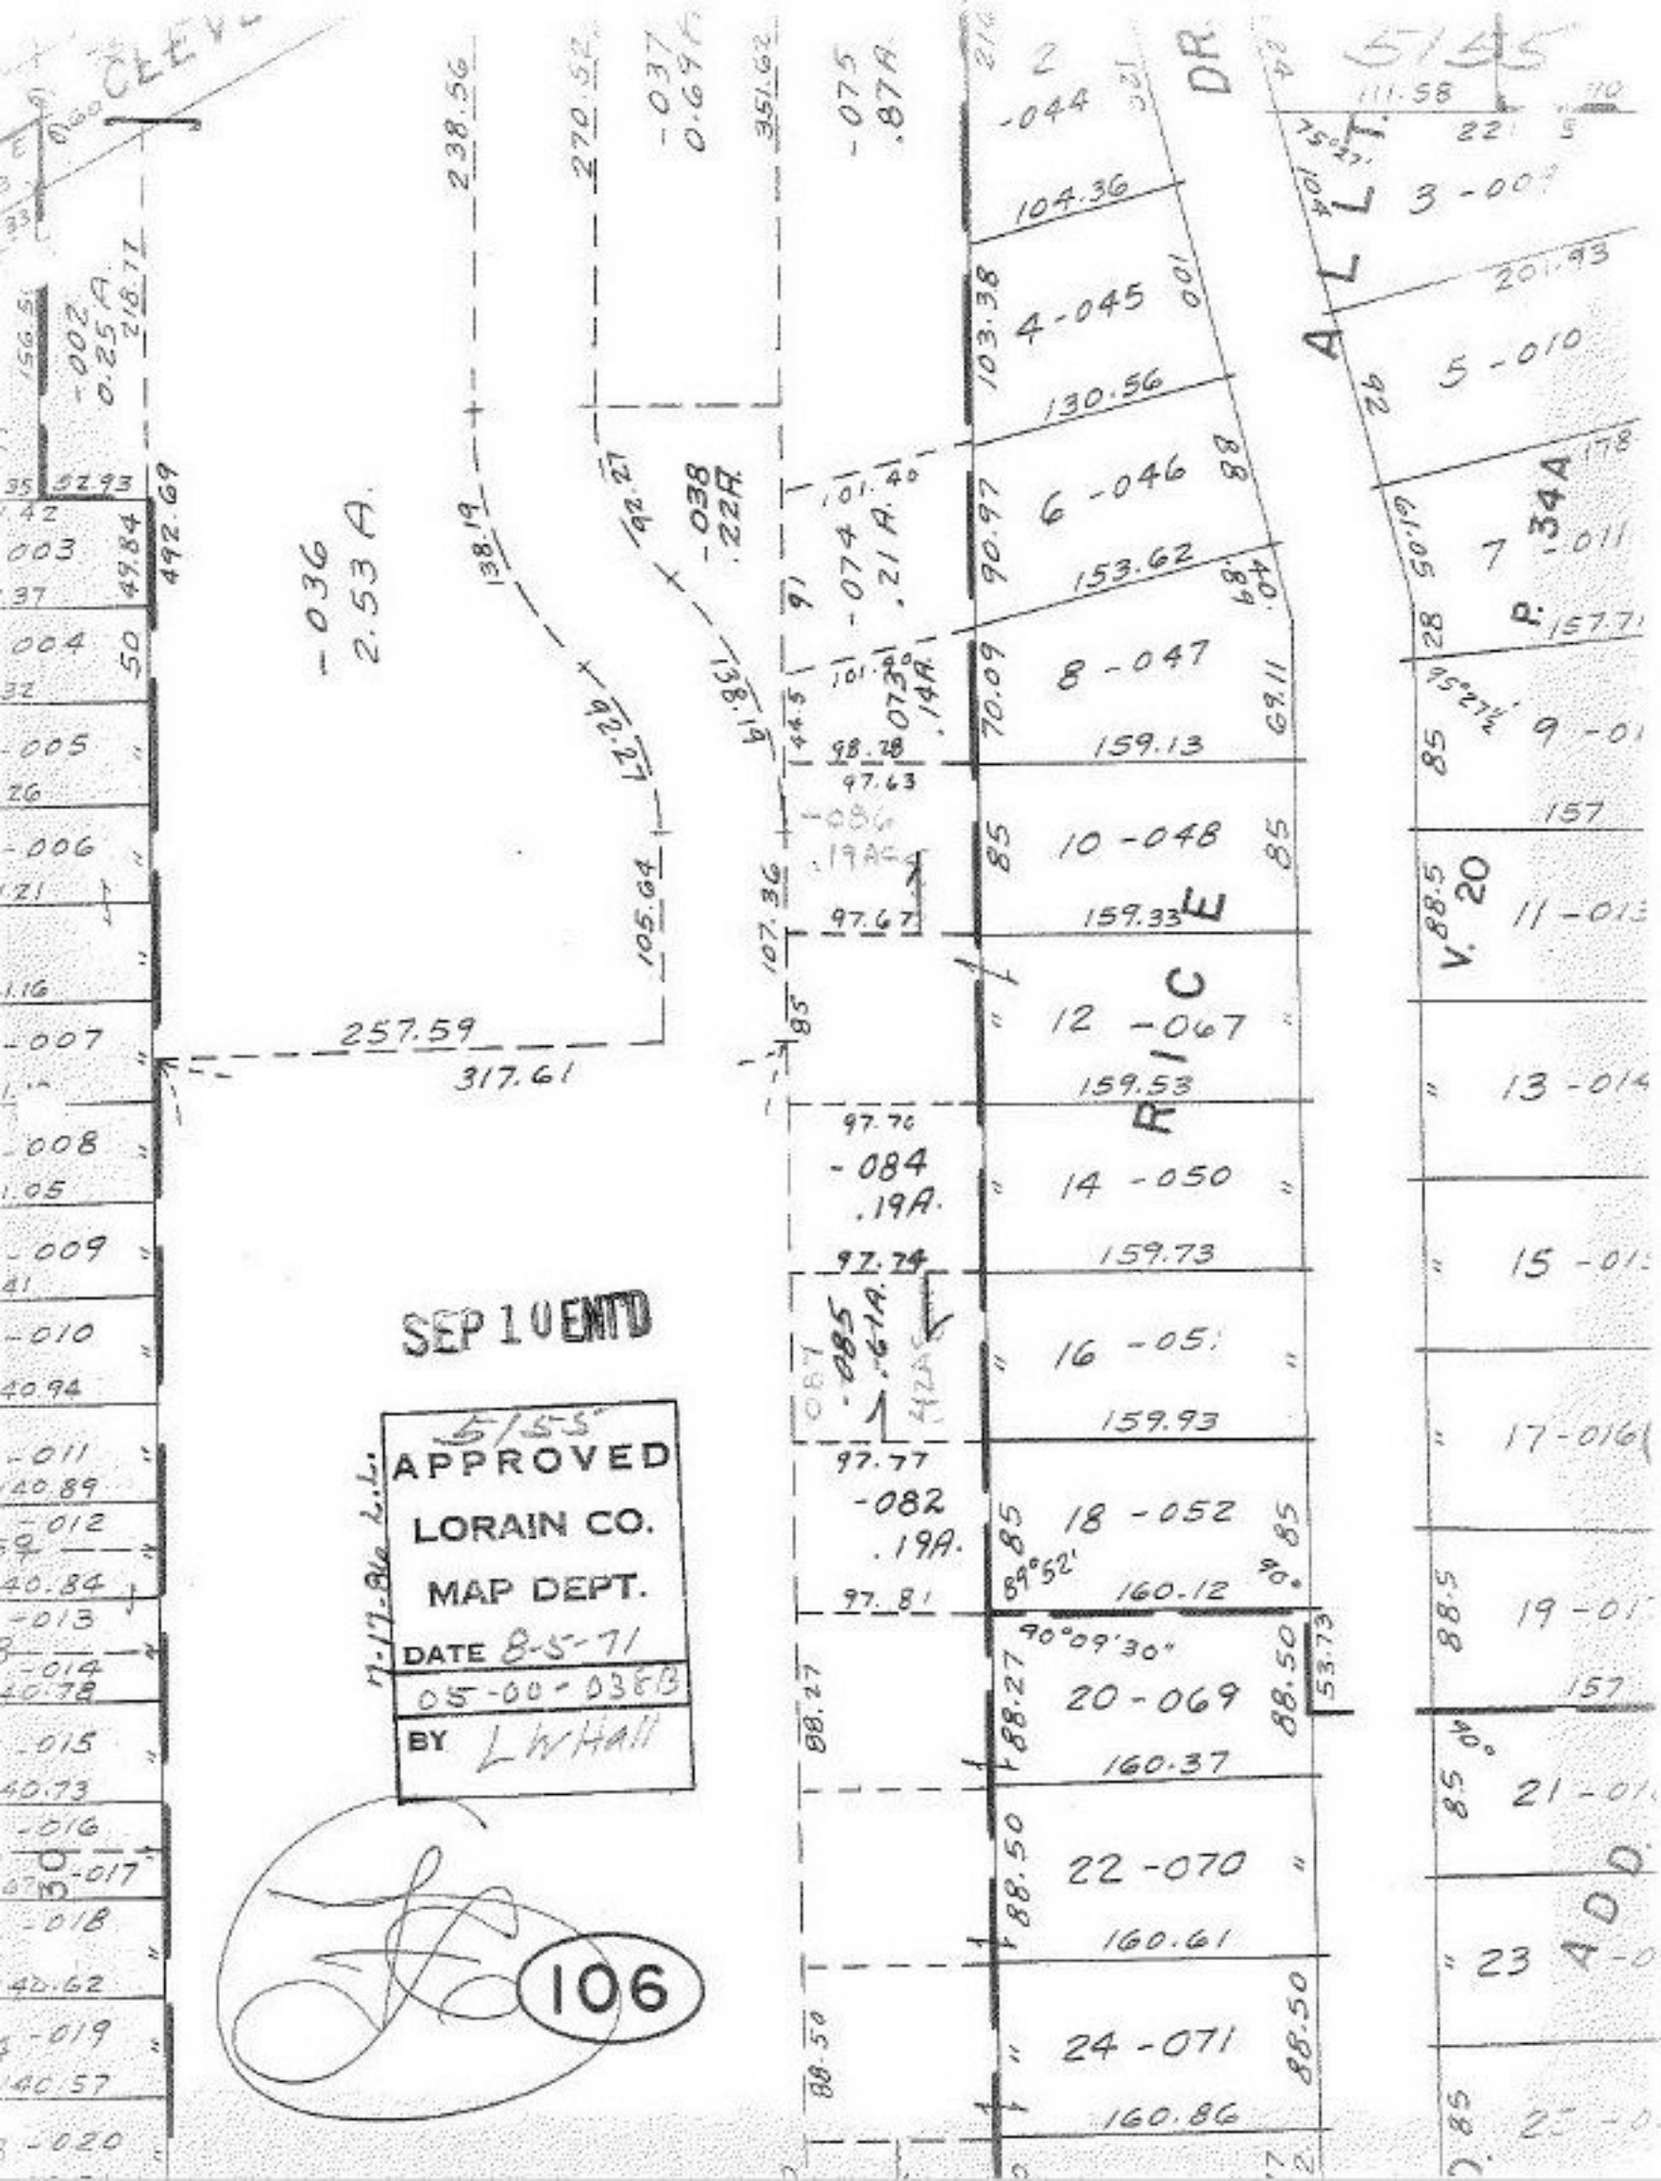

CLEVE
5155
DR.
ALLT.
RICE
V. 20
P. 34A
ADD.
-036
2.53 A.
-037
0.69 A.
-075
.87 A.
-074
.21 A.
-073
.14 A.
-086
.19 A.
-084
.19 A.
-085
.61 A.
-082
.19 A.
-002
0.25 A.
-038
.22 A.
257.59
317.61
238.56
270.52
351.62
104.36
130.56
153.62
159.13
159.33
159.53
159.73
159.93
160.12
160.37
160.61
160.86
4-045
6-046
8-047
10-048
12-067
14-050
16-051
18-052
20-069
22-070
24-071
3-009
5-010
7-011
9-01
11-013
13-014
15-01
17-016
19-01
21-01
23
SEP 10 ENT'D
5155
APPROVED
LORAIN CO.
MAP DEPT.
DATE 8-5-71
05-00-038B
BY LWHall
106