5158

SEP 13 ENTD
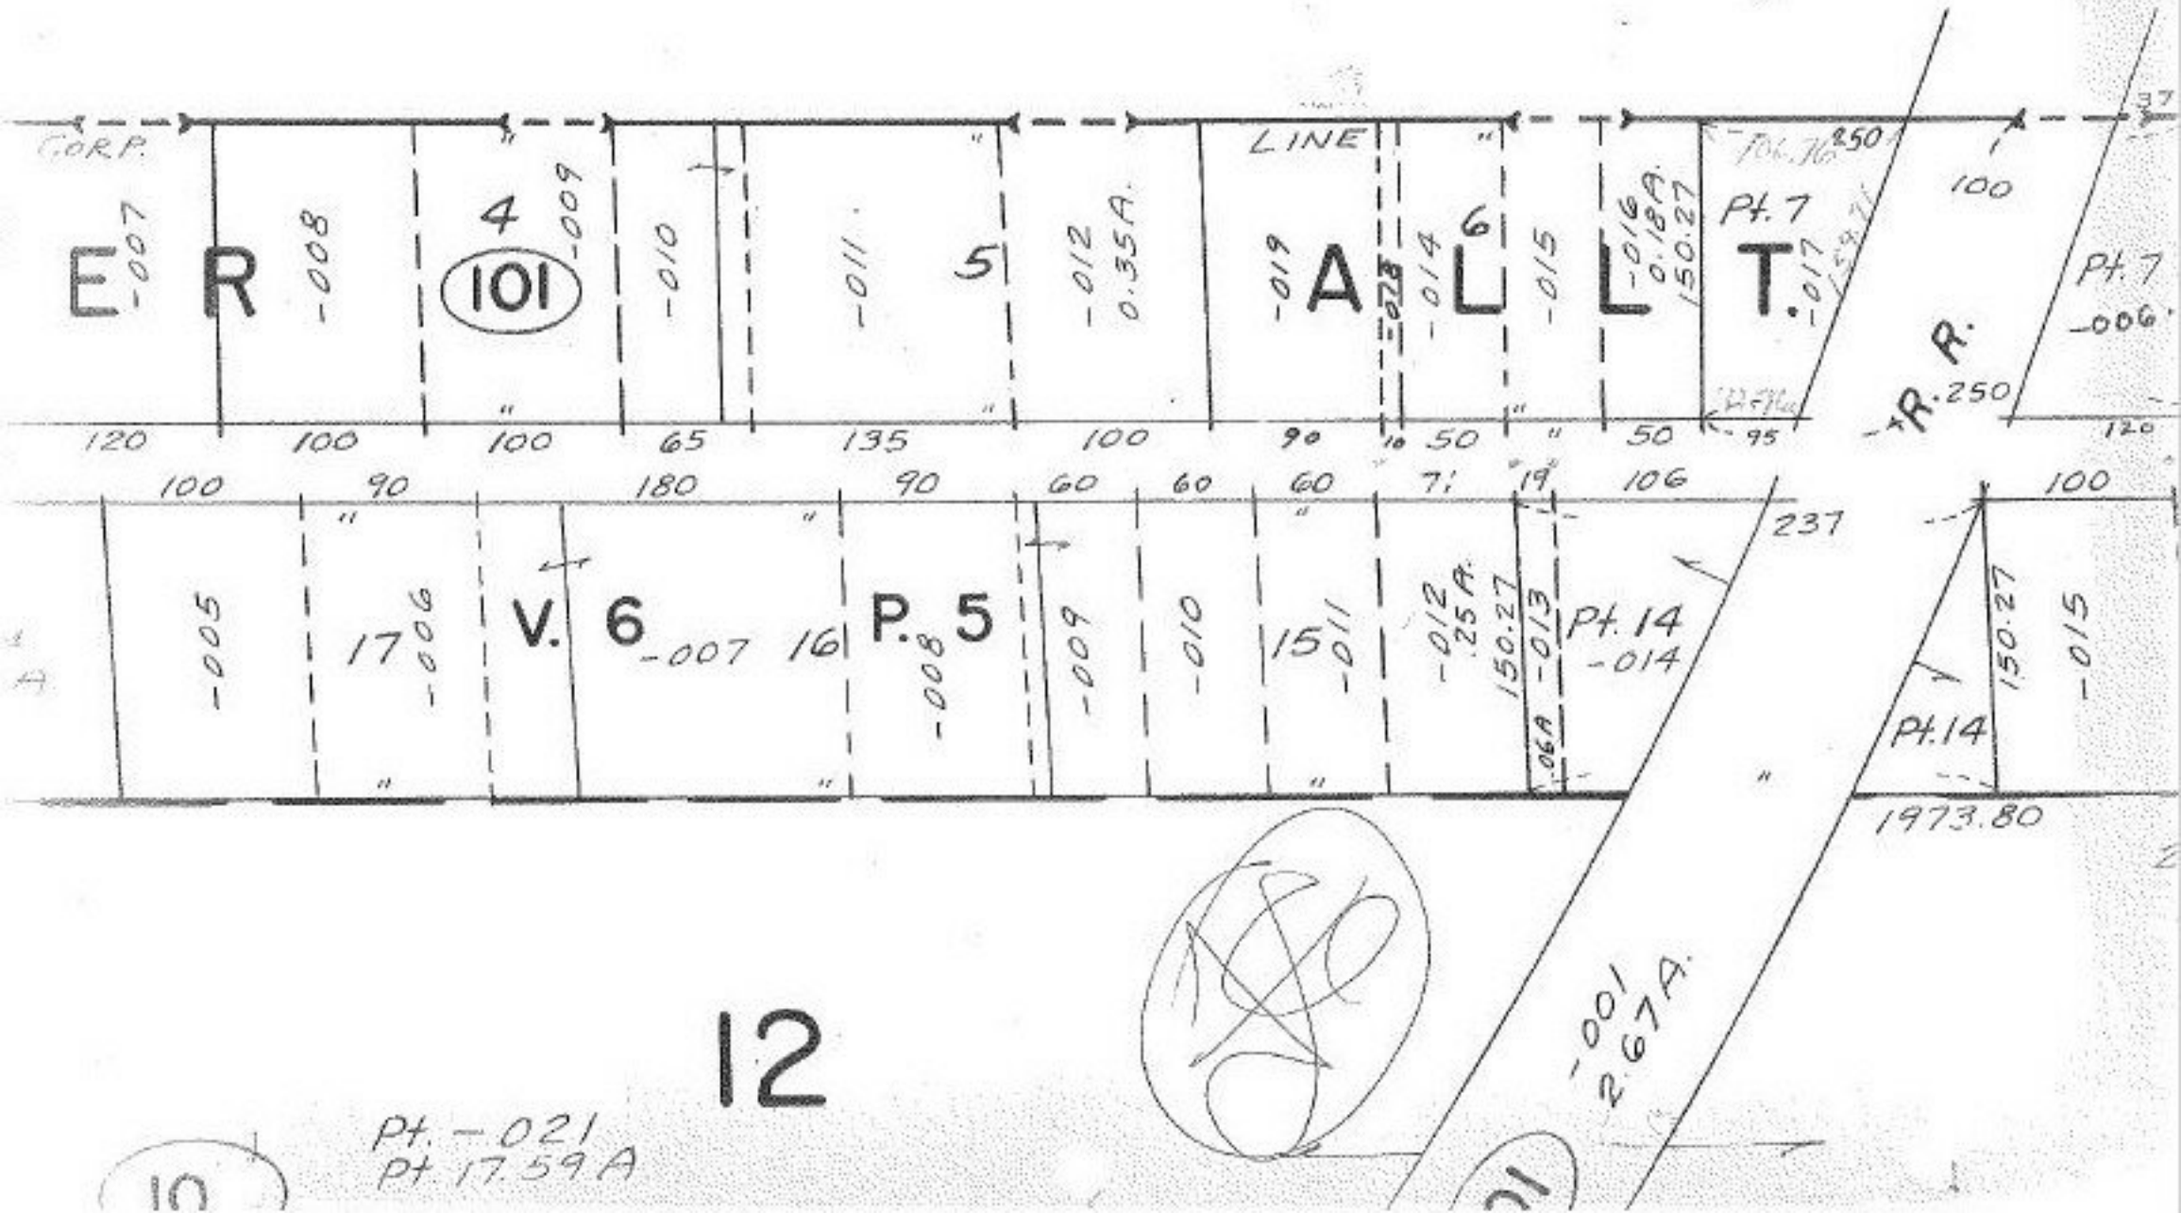
5158
APPROVED
LORAIN CO.
MAP DEPT.
DATE 8-4-71
6-11
BY LW Hall