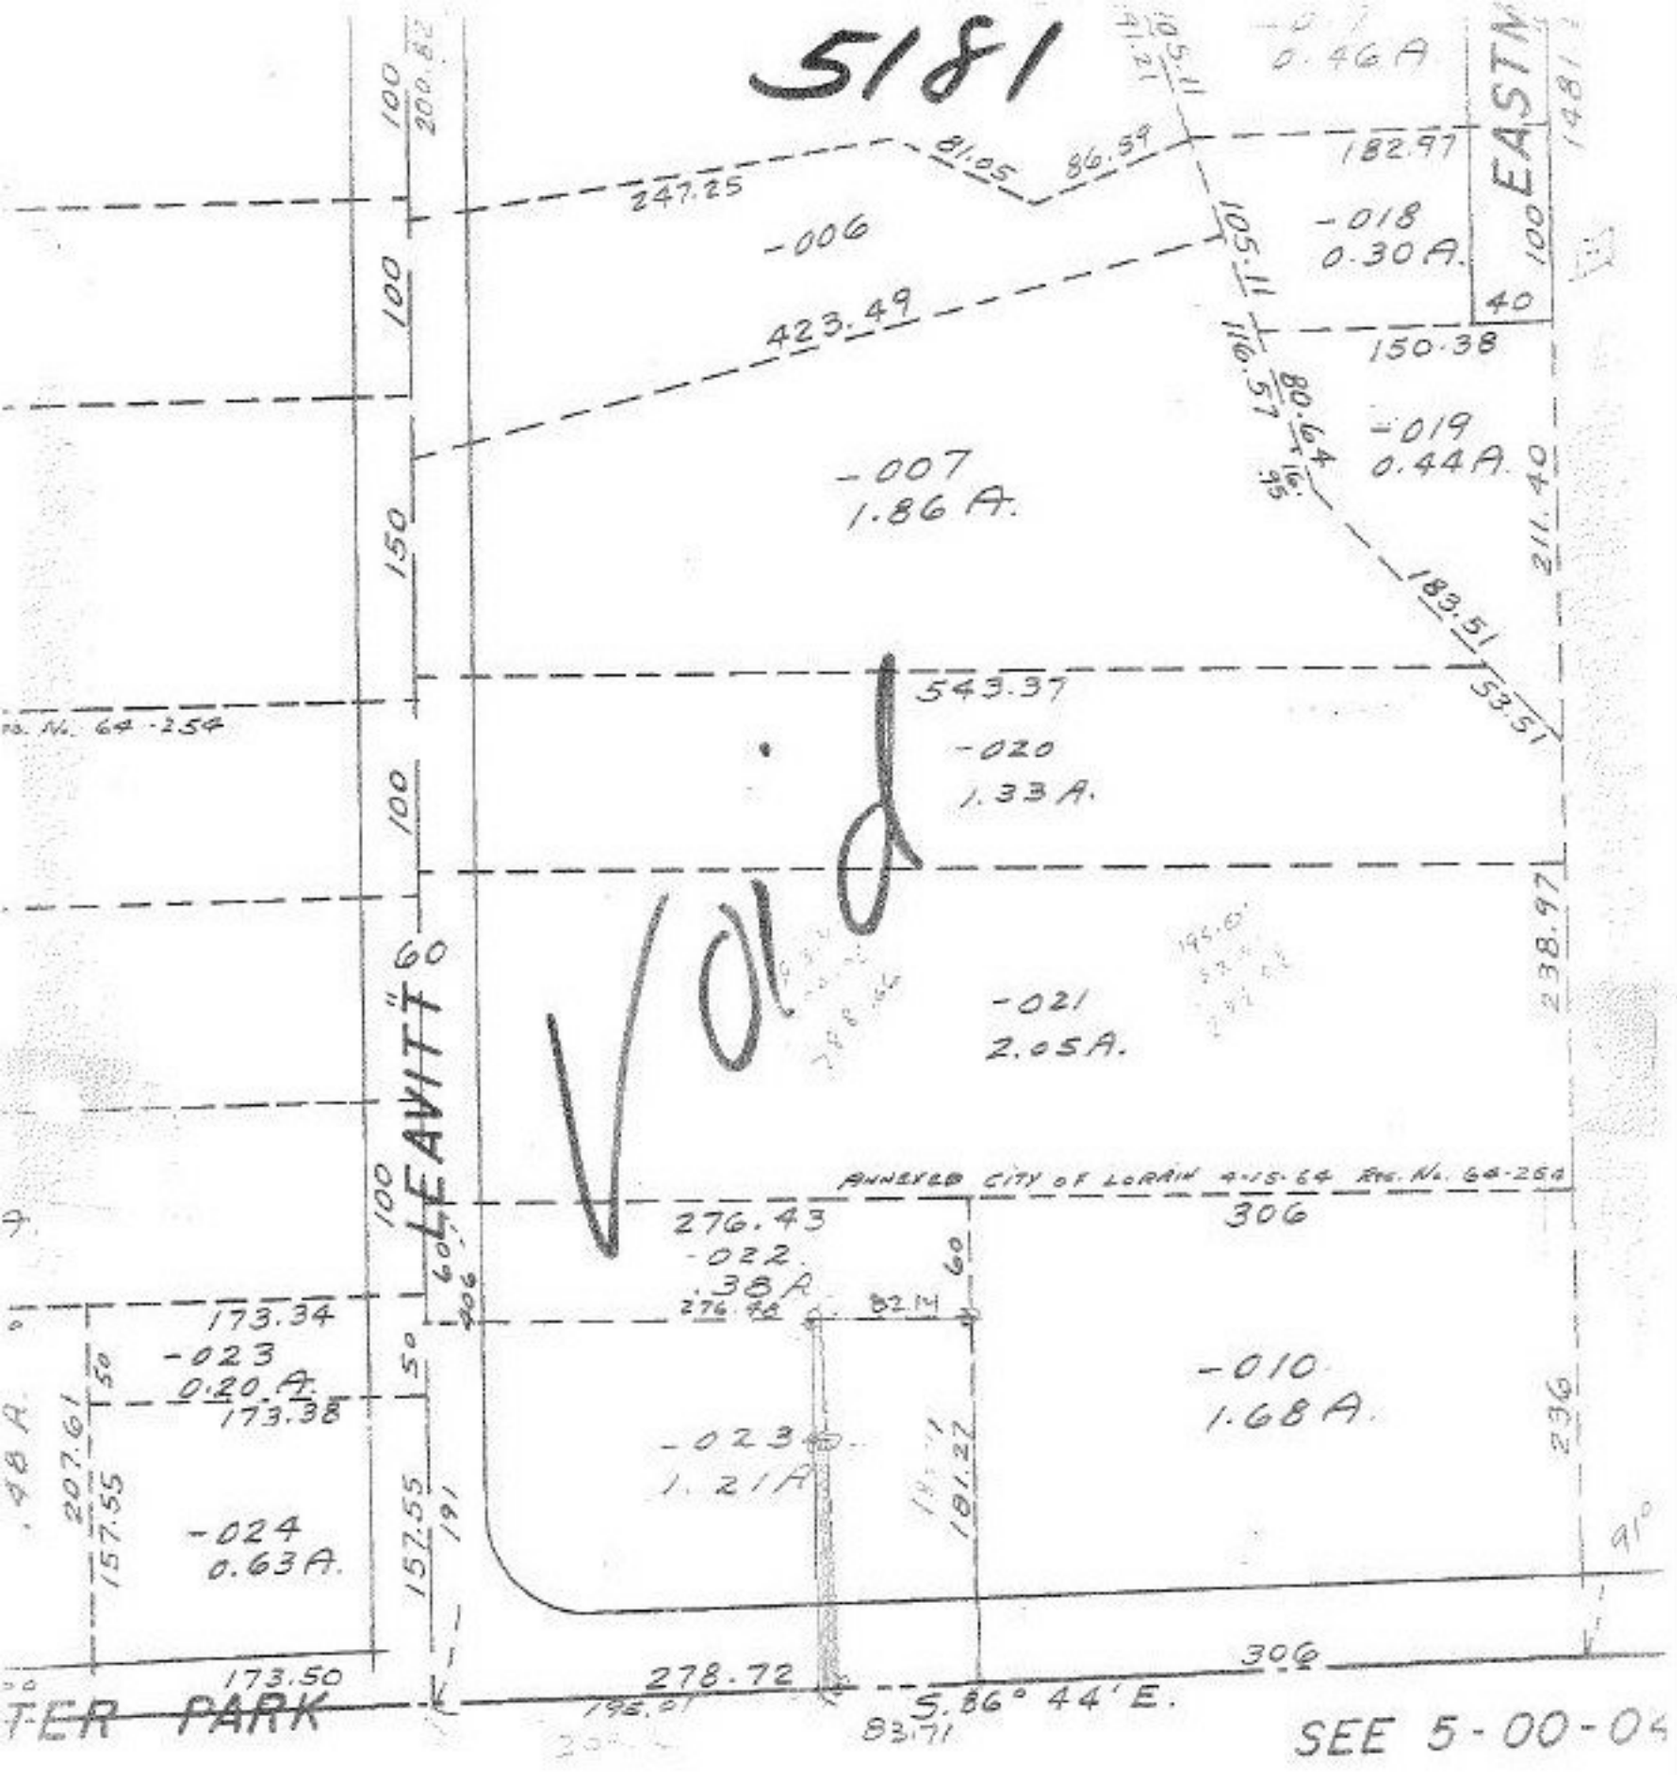

BLACK RIVER TWP.

SCALE: 1" = 100'

Pg 2-02-003