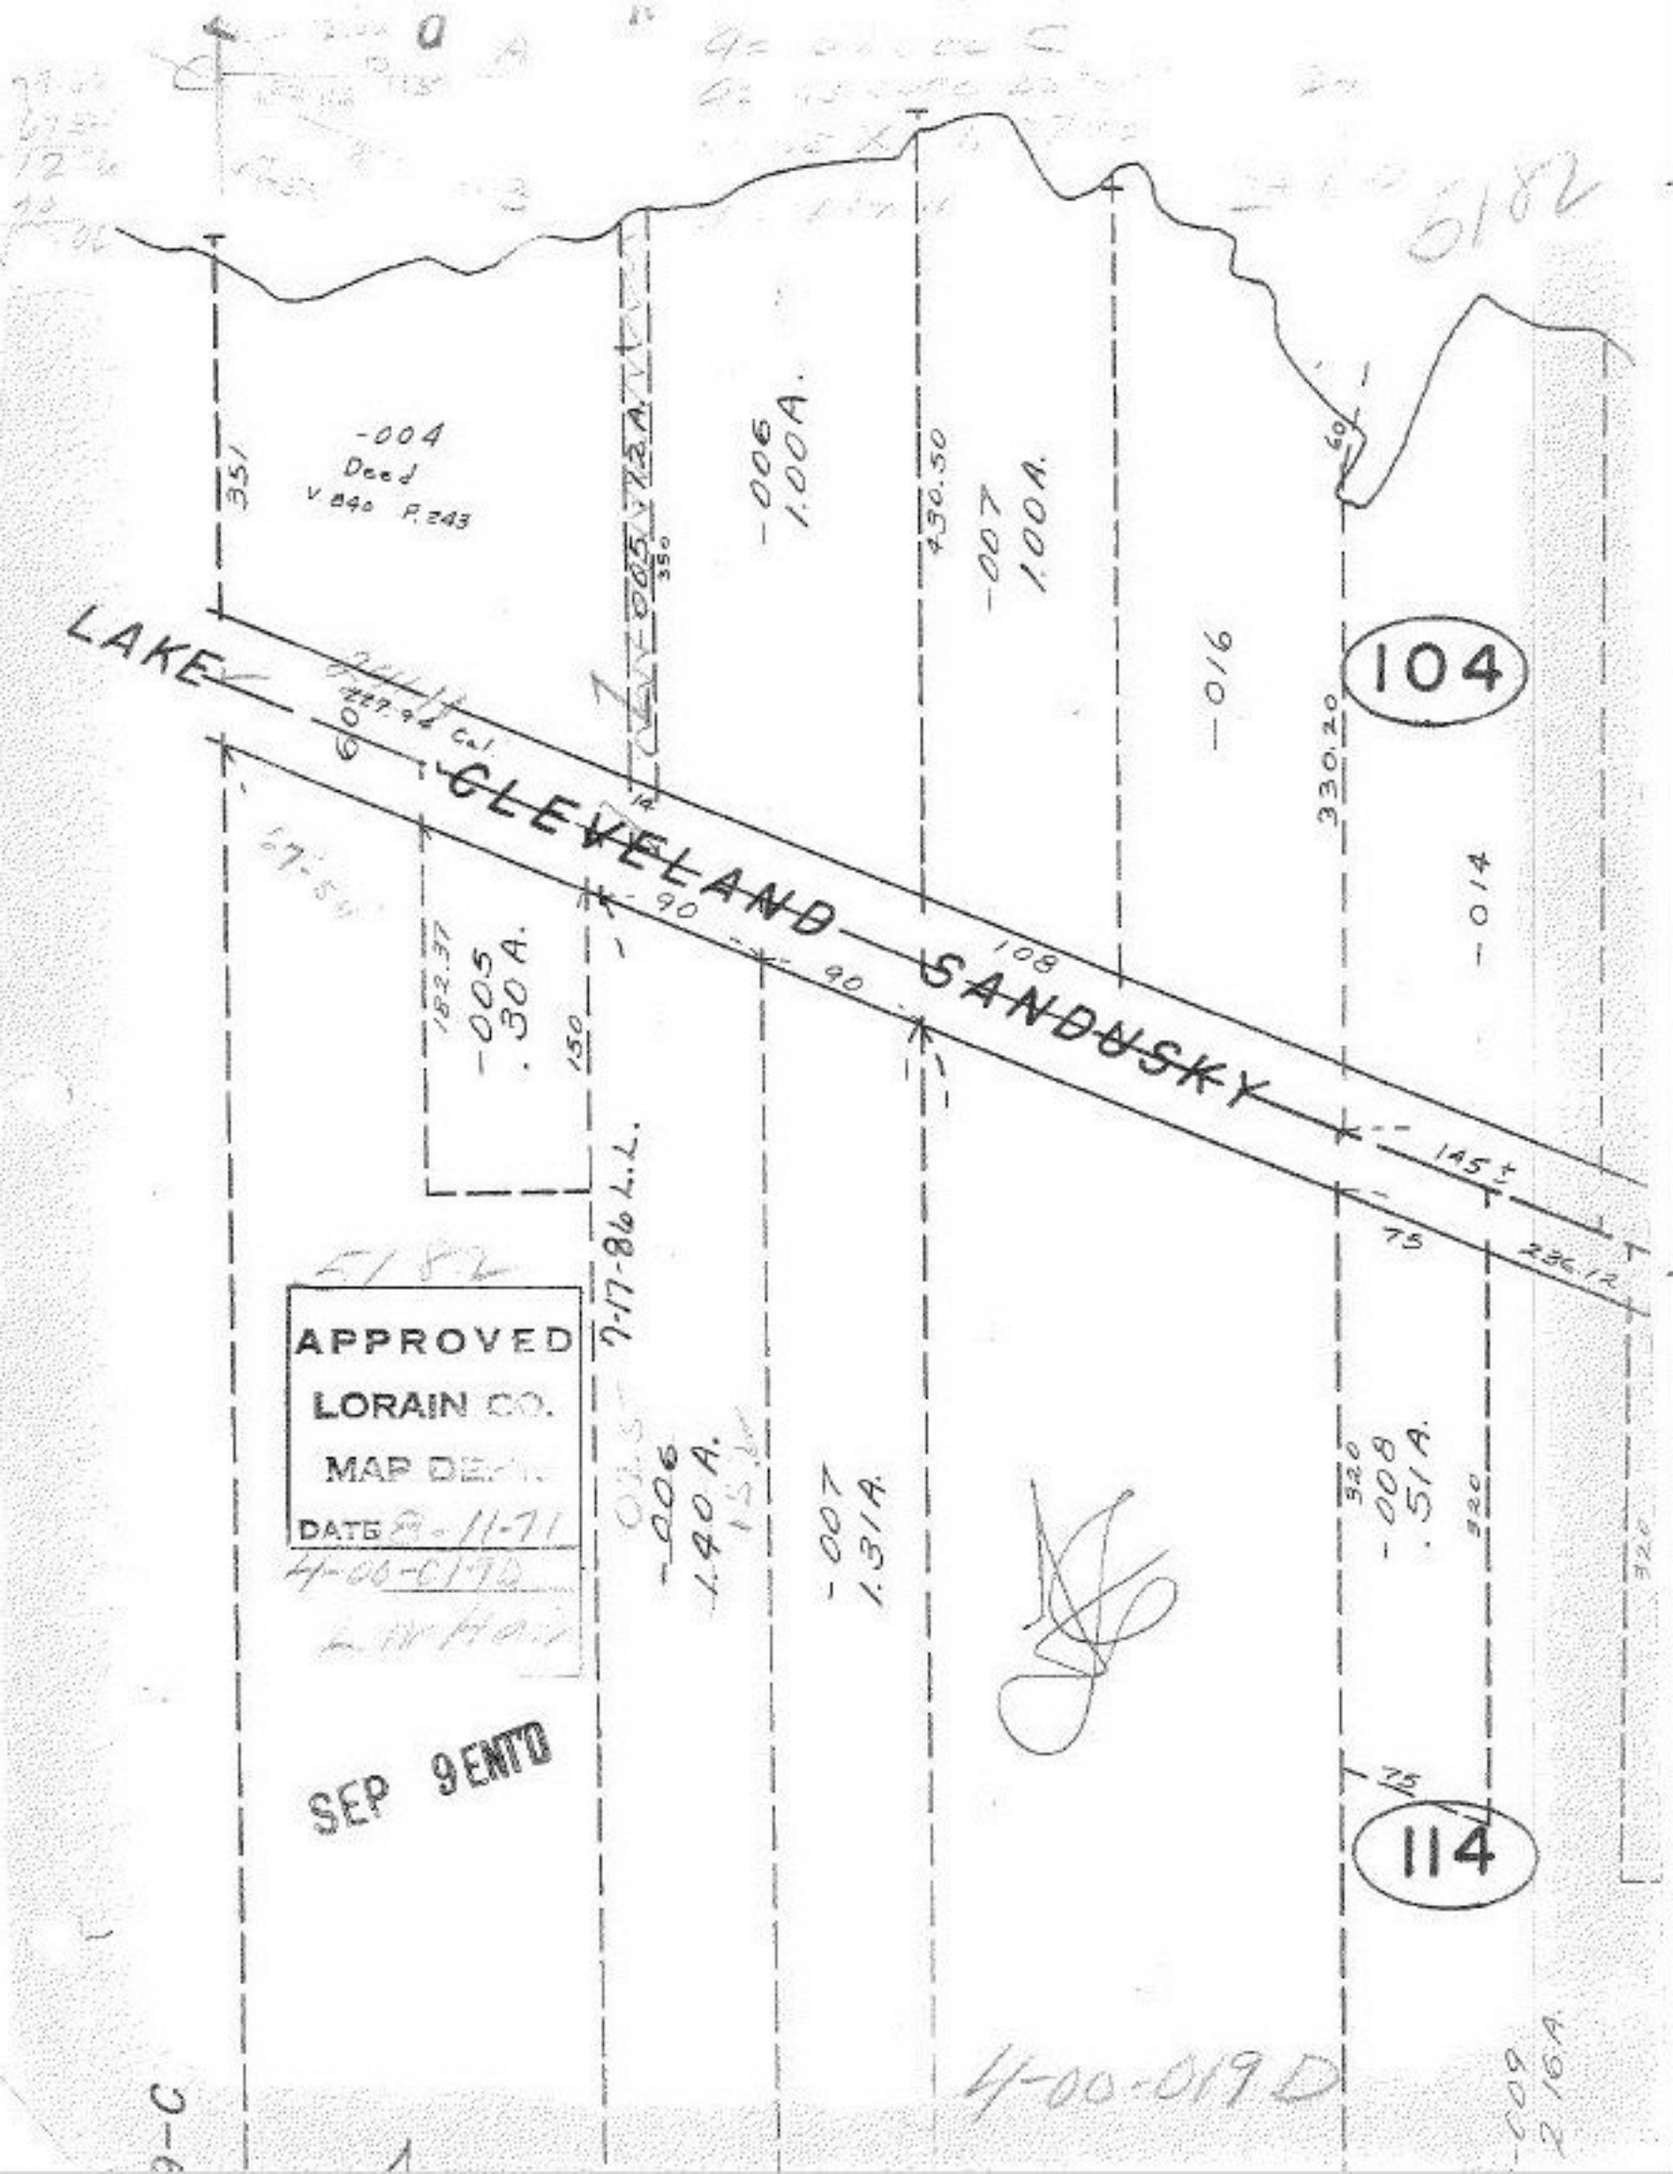
-004
Deed
V 840 P. 243
351
-005 7.22A.
350
-006
1.00A.
430.50
-007
1.00A.
-016
60
104
330.20
-014
LAKE
CLEVELAND
SANDUSKY
60
827.92 C.L.
90
90
108
145 ±
75
236.12
182.37
-005
.30A.
150
7-17-86 L.L.
APPROVED
LORAIN CO.
MAP DEPT.
DATE 9-11-71
4-00-019D
SEP 9ENTD
-006
1.40A.
-007
1.31A.
320
-008
.51A.
320
320
114
4-00-019D
6182
2164