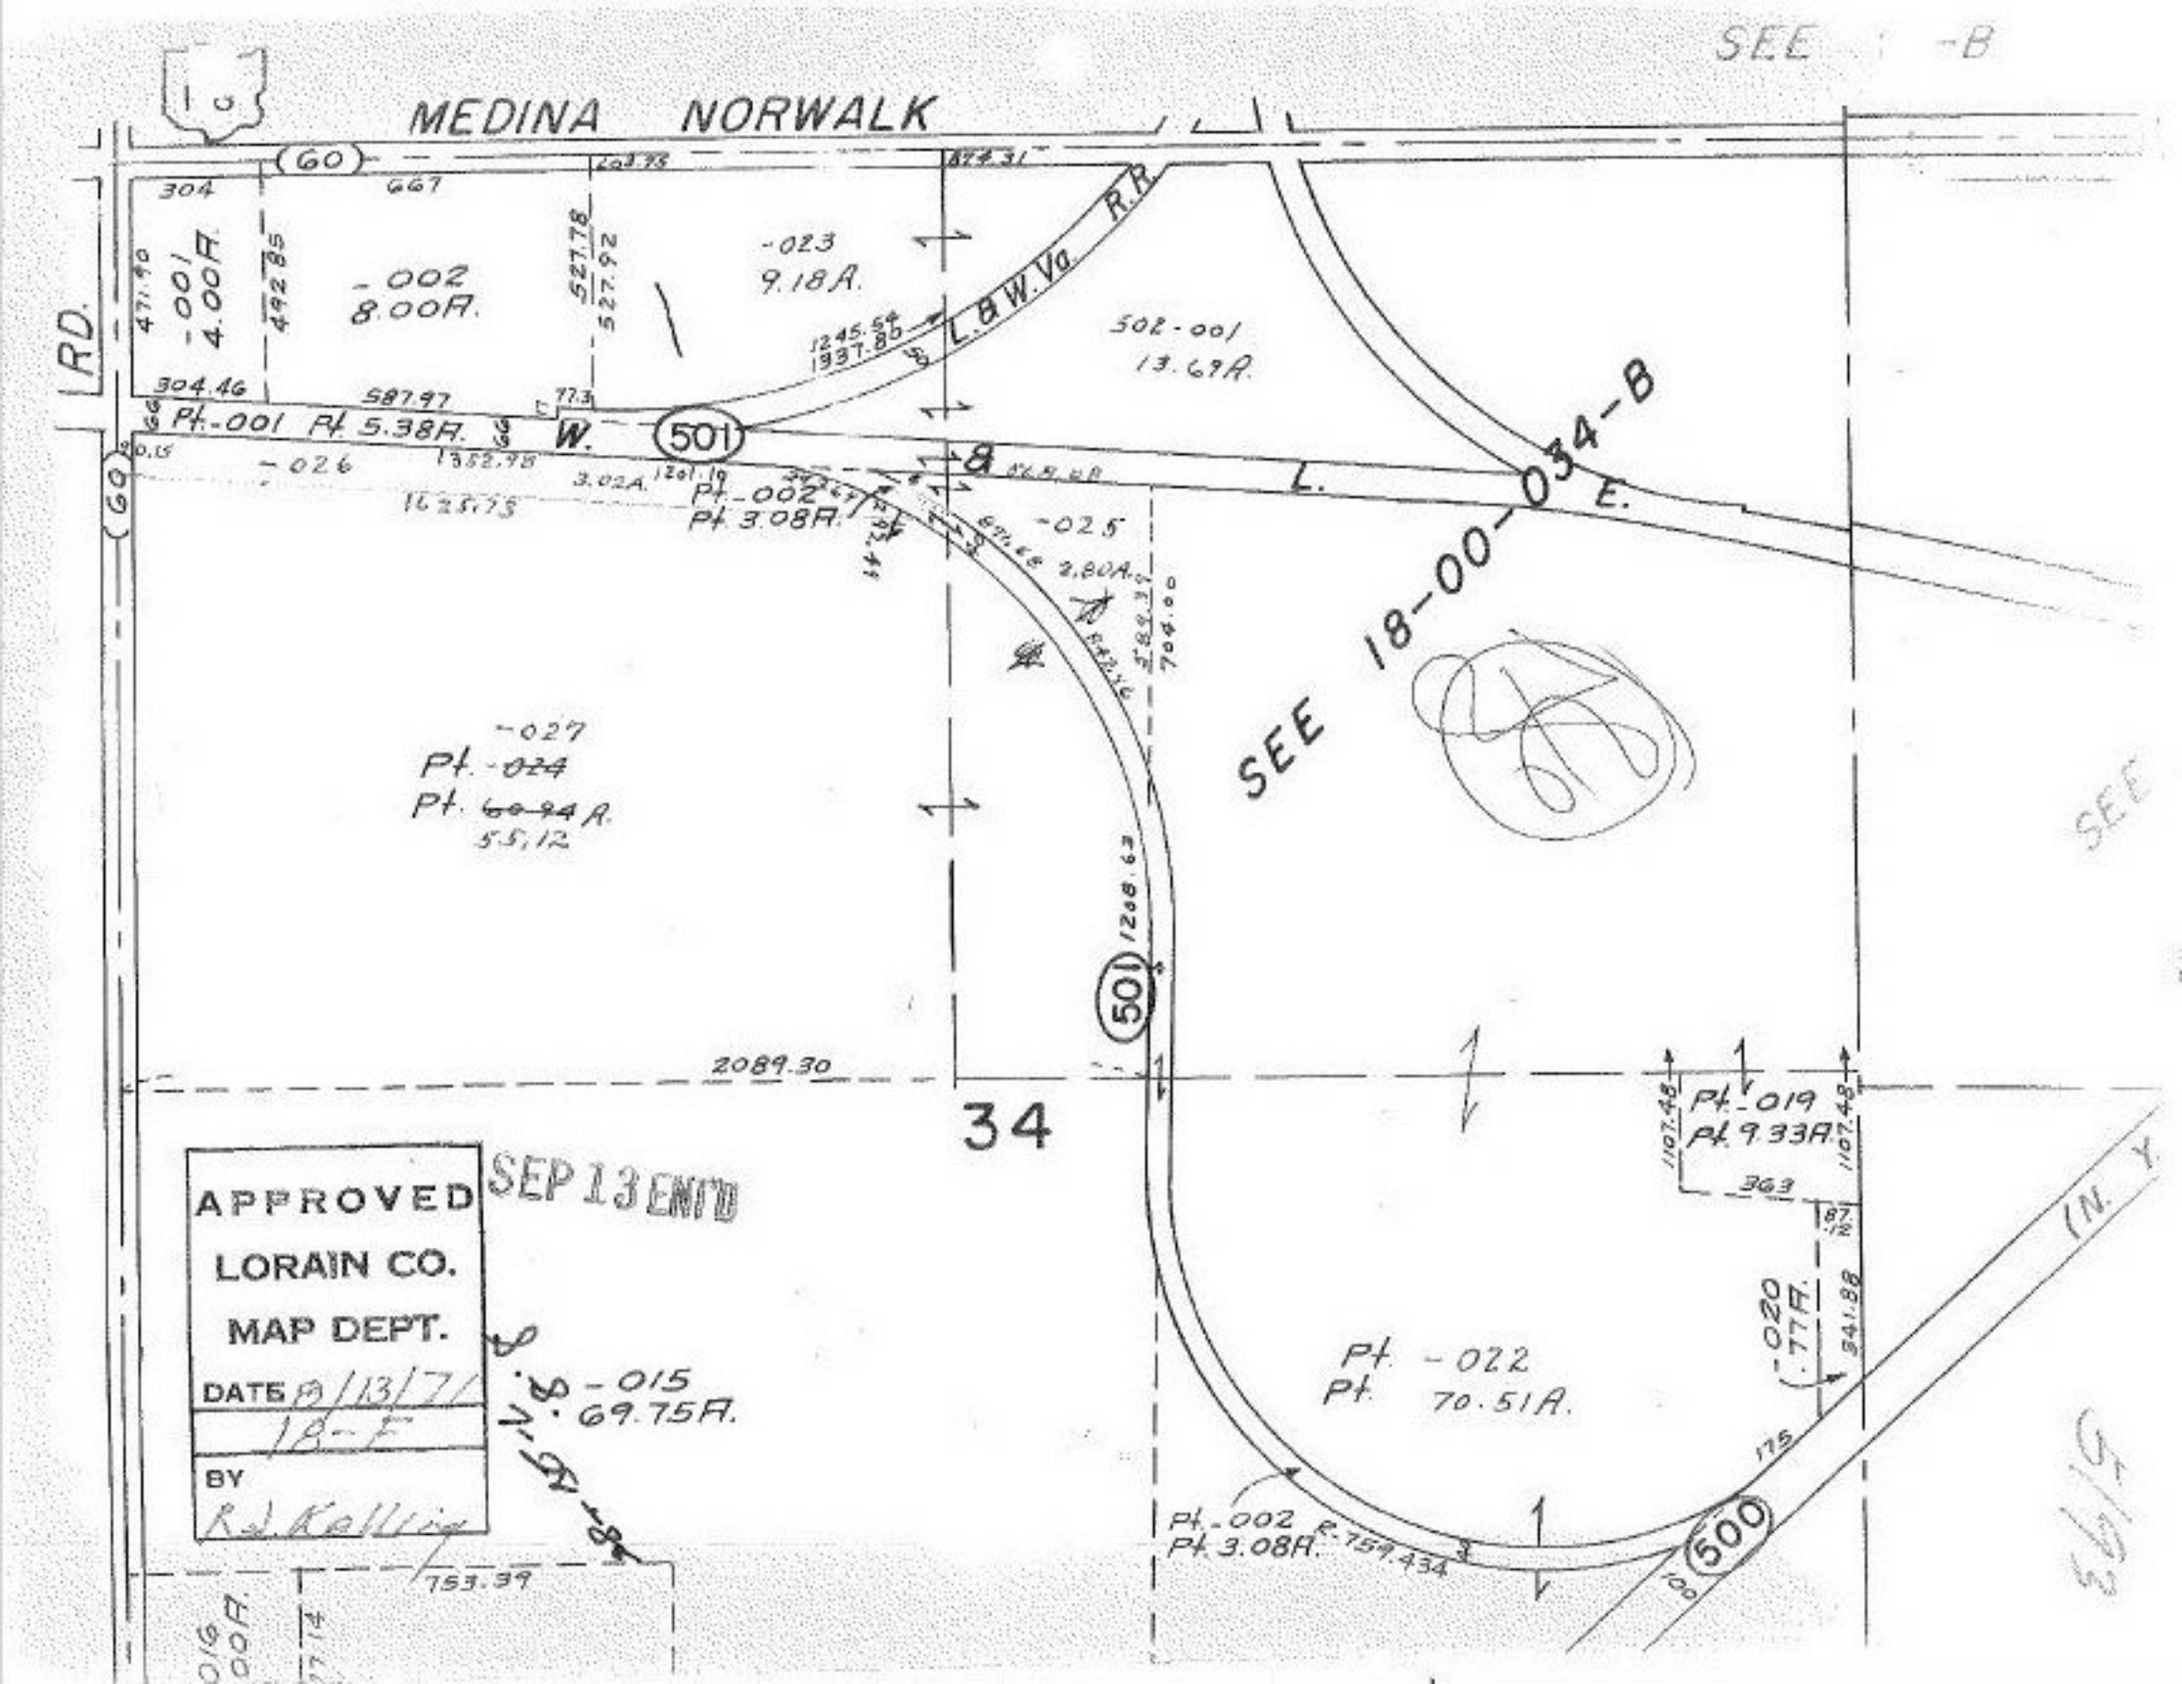
SEE -B
MEDINA NORWALK
RD.
(60)
304
667
-001
4.00A.
-002
8.00A.
-023
9.18A.
L.&W.Va. R.R.
502-001
13.69A.
304.46
587.97
Pt.-001 Pt. 5.38A.
W.
501
-026
Pt.-002
Pt. 3.08A.
L.
E.
-025
2.80A.
SEE 18-00-034-B
-027
Pt. ~~-024~~
Pt. ~~60.94~~ A.
55.12
2089.30
34
Pt.-019
Pt. 9.33A.
363
-020
.77A.
341.88
Pt. -022
Pt. 70.51A.
Pt.-002
Pt. 3.08A.
R-759.434
500
(N. Y.
-015
69.75A.
753.39
APPROVED
LORAIN CO.
MAP DEPT.
DATE 8/13/71
18-F
BY
R.J. Kalling
SEP 13 ENT'D