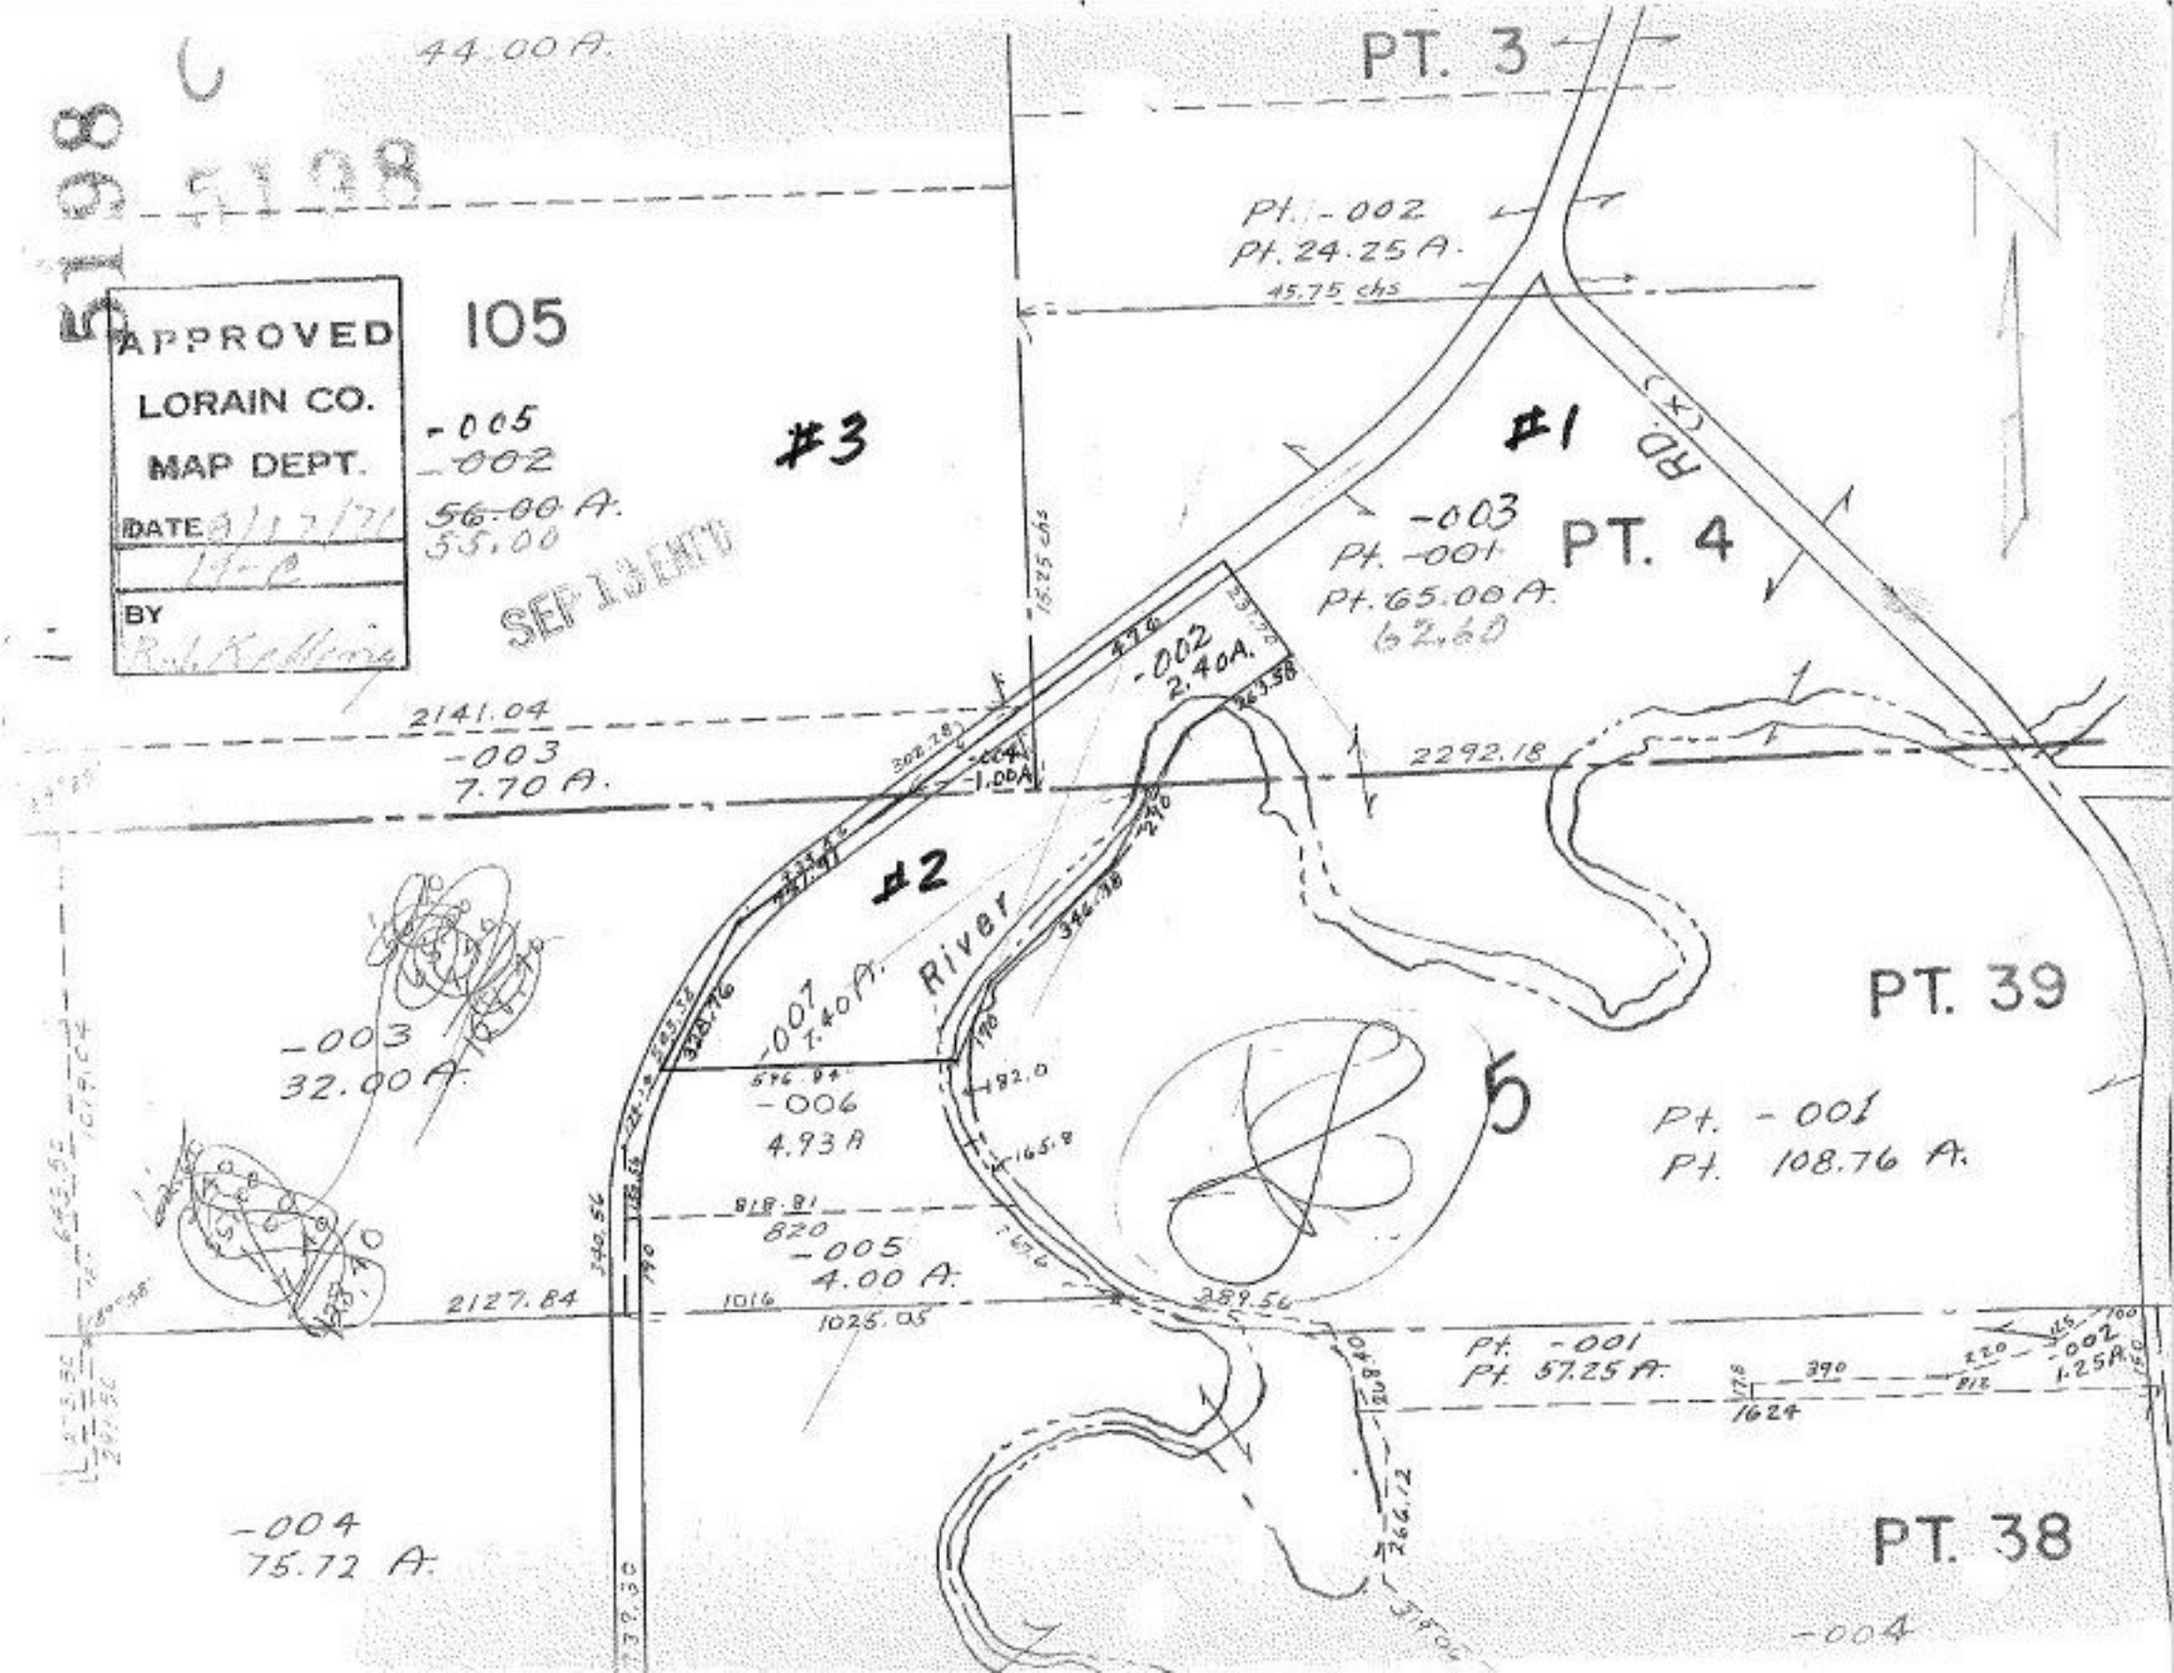
44.00 A.
PT. 3
5108
APPROVED
LORAIN CO.
MAP DEPT.
DATE 9/12/71
BY
105
-005
-002
56.00 A.
55.00
SEP 13 RECD
#3
#1
Pt. -002
Pt. 24.25 A.
45.75 chs
RD. (X)
-003
Pt. -001
Pt. 65.00 A.
62.60
PT. 4
2141.04
-003
7.70 A.
-002
2.40A.
-004
1.00A.
2292.18
#2
River
-007
1.40 A.
-006
4.93 A
-003
32.00 A.
-005
4.00 A.
2127.84
1025.05
PT. 39
Pt. -001
Pt. 108.76 A.
Pt. -001
Pt. 57.25 A.
-002
1.25 A.
1624
PT. 38
-004
75.72 A.
-004