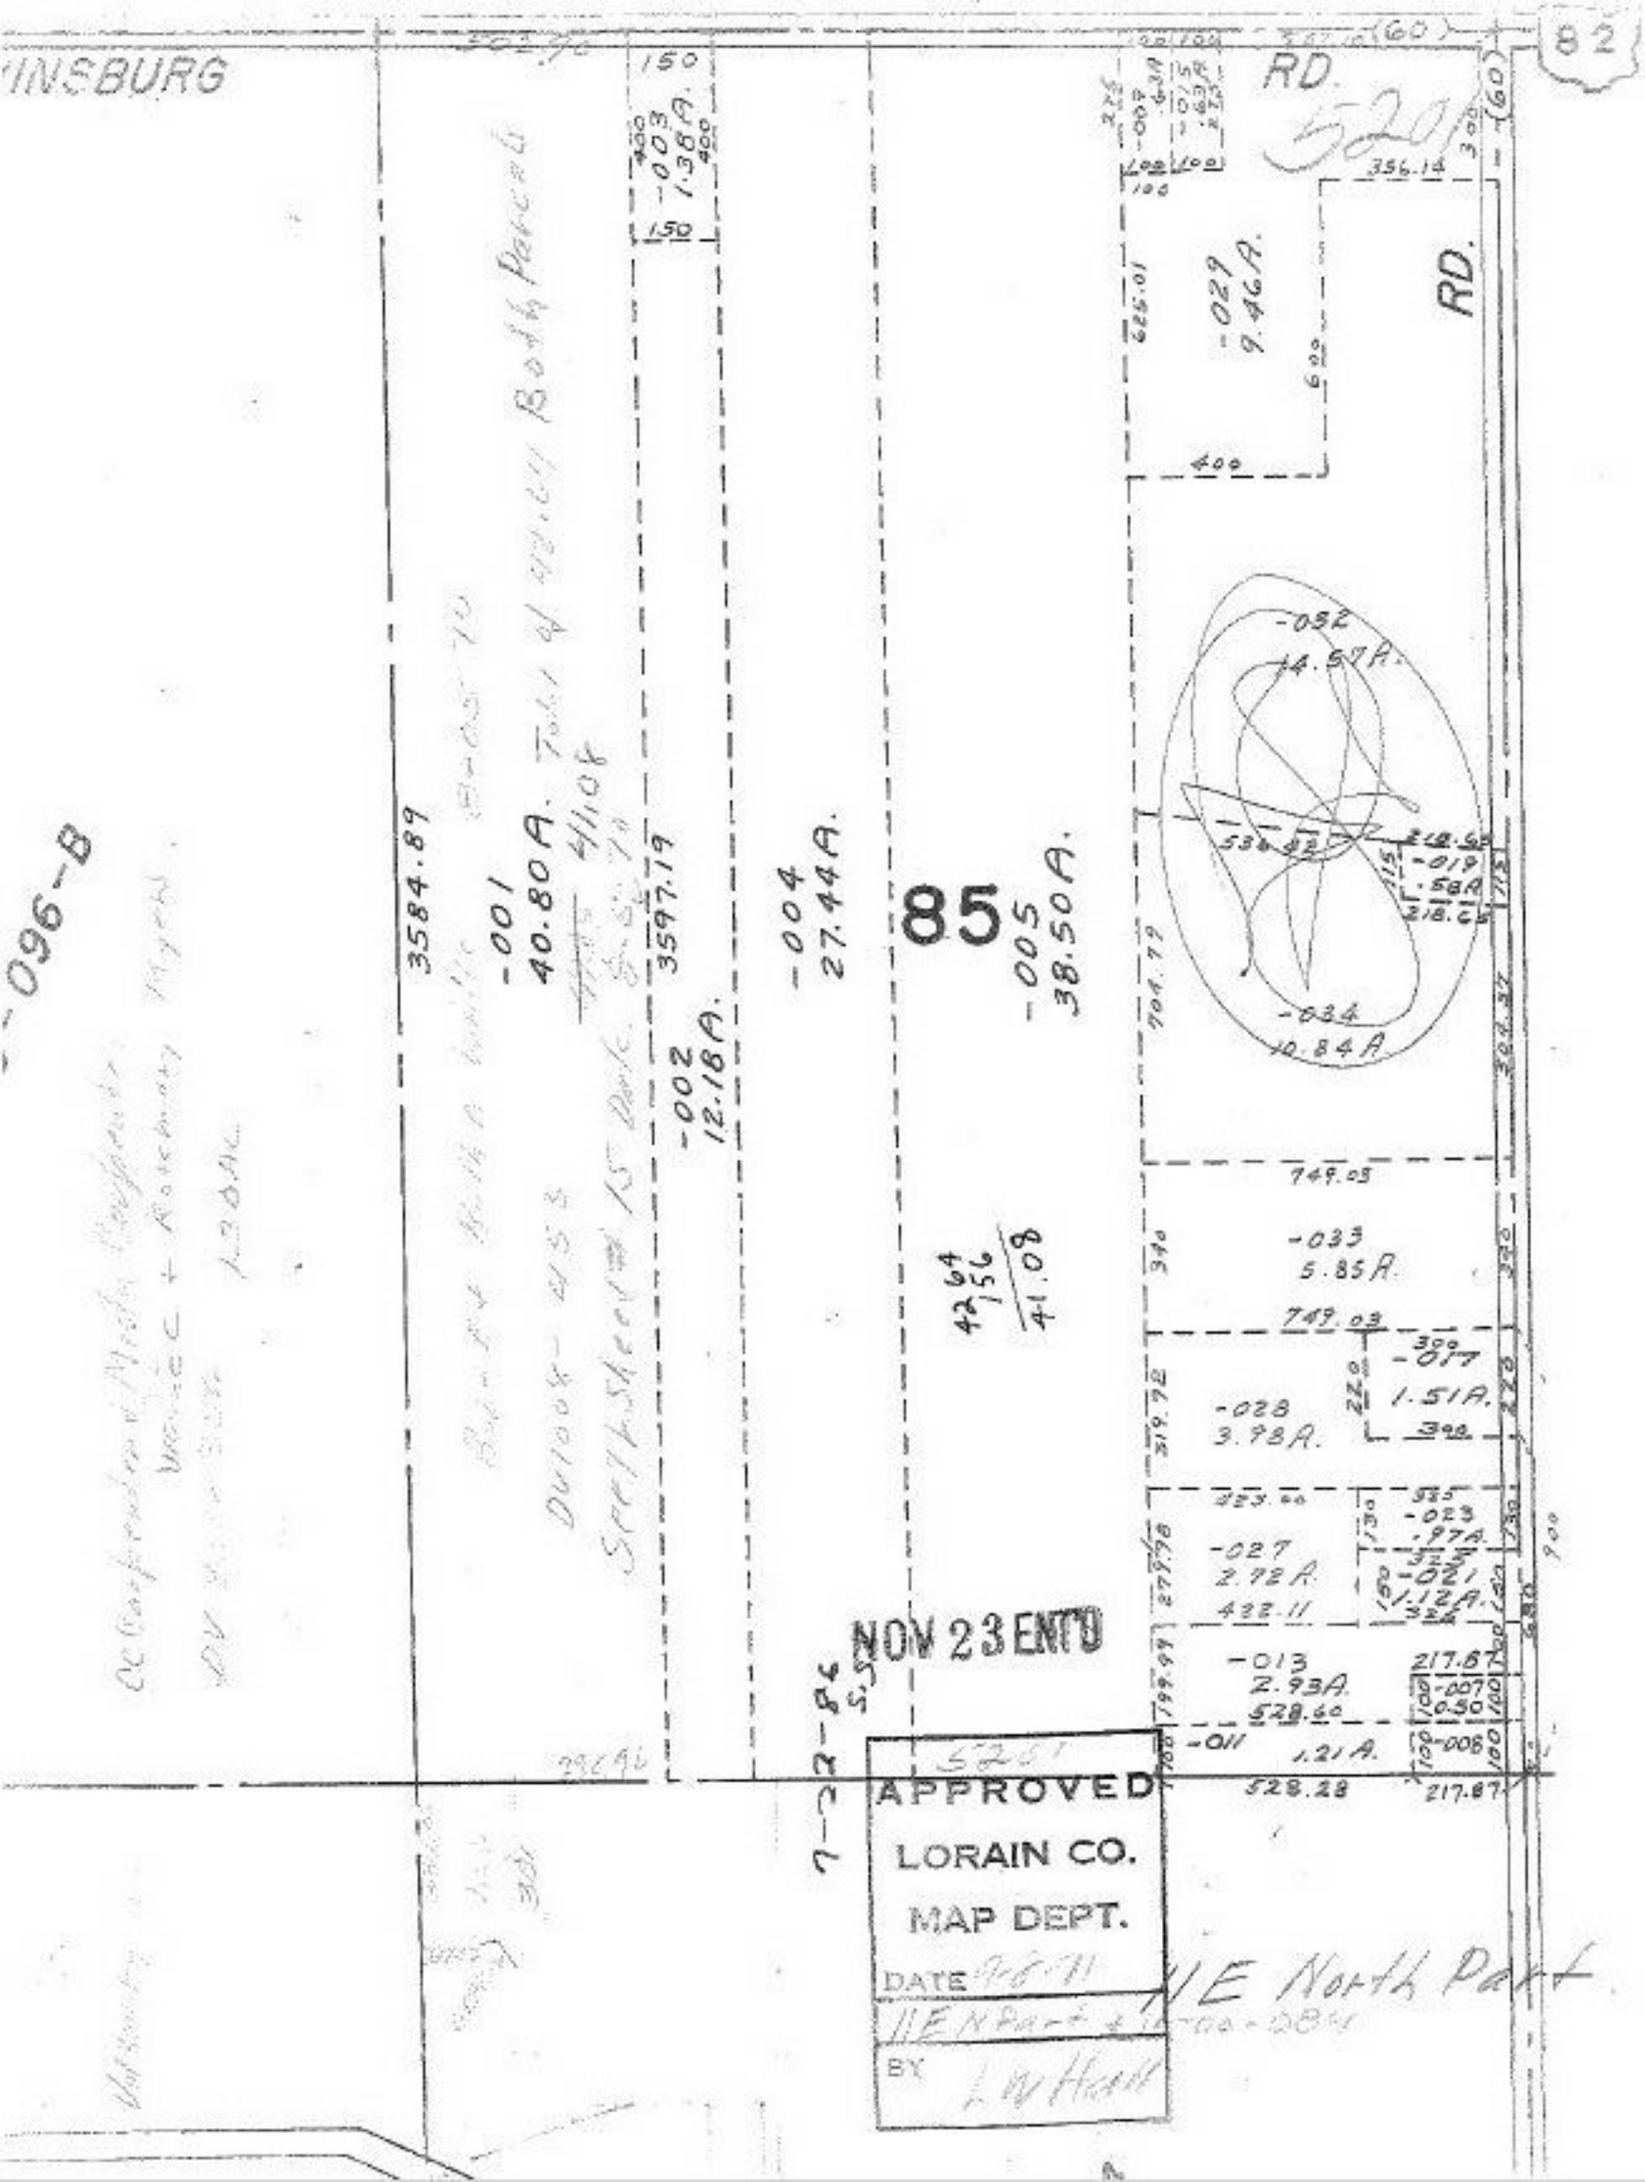

82
WINSBURG
RD.
5201
-096-B
3584.89
-001
40.80 A.
3597.19
-002
12.18 A.
-003
1.38 A.
-004
27.44 A.
85
-005
38.50 A.
-029
9.46 A.
-032
14.57 A.
-034
10.84 A.
-033
5.85 A.
-028
3.98 A.
-017
1.51 A.
-027
2.72 A.
-023
.97 A.
-021
1.12 A.
-013
2.93 A.
-011
1.21 A.
NOV 23 ENT'D
APPROVED
LORAIN CO.
MAP DEPT.
DATE
BY
11E North Part