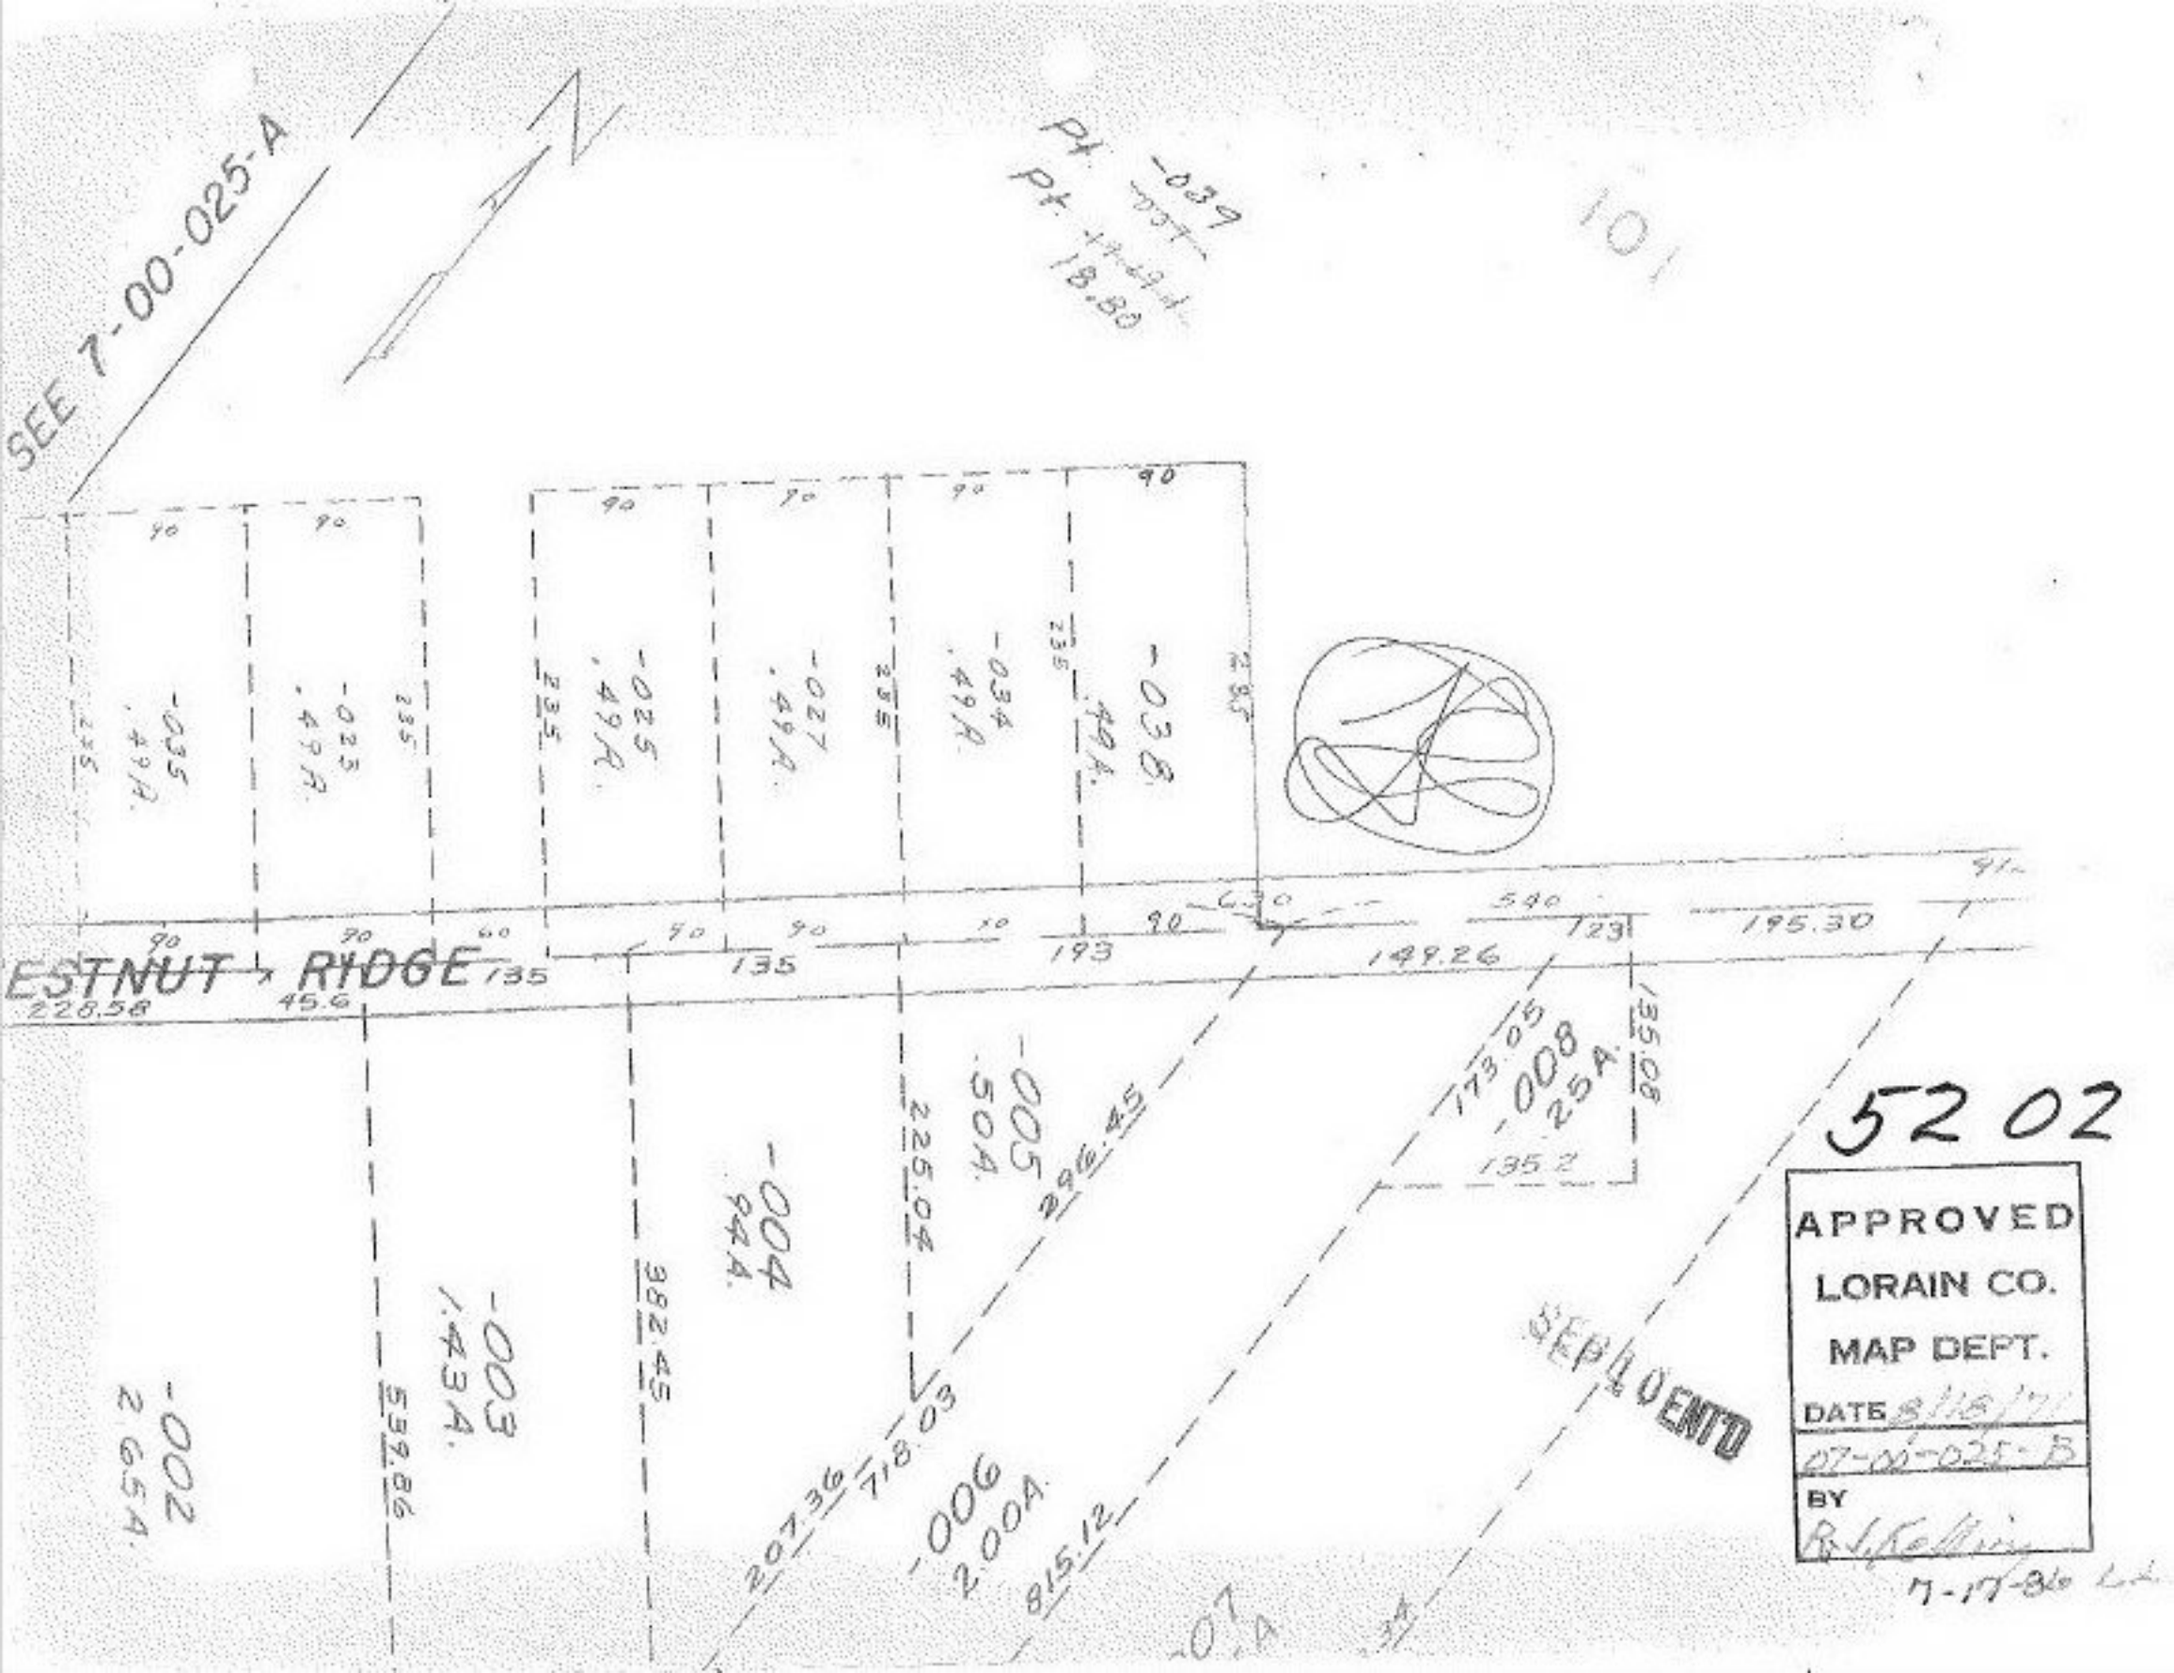
SEE 7-00-025-A
-039
Pt.
Pt.
18.80
101
-035
.494 A.
-025
.494 A.
-025
.494 A.
-027
.494 A.
-034
.494 A.
-036
.494 A.
90
90
90